


RAMP D

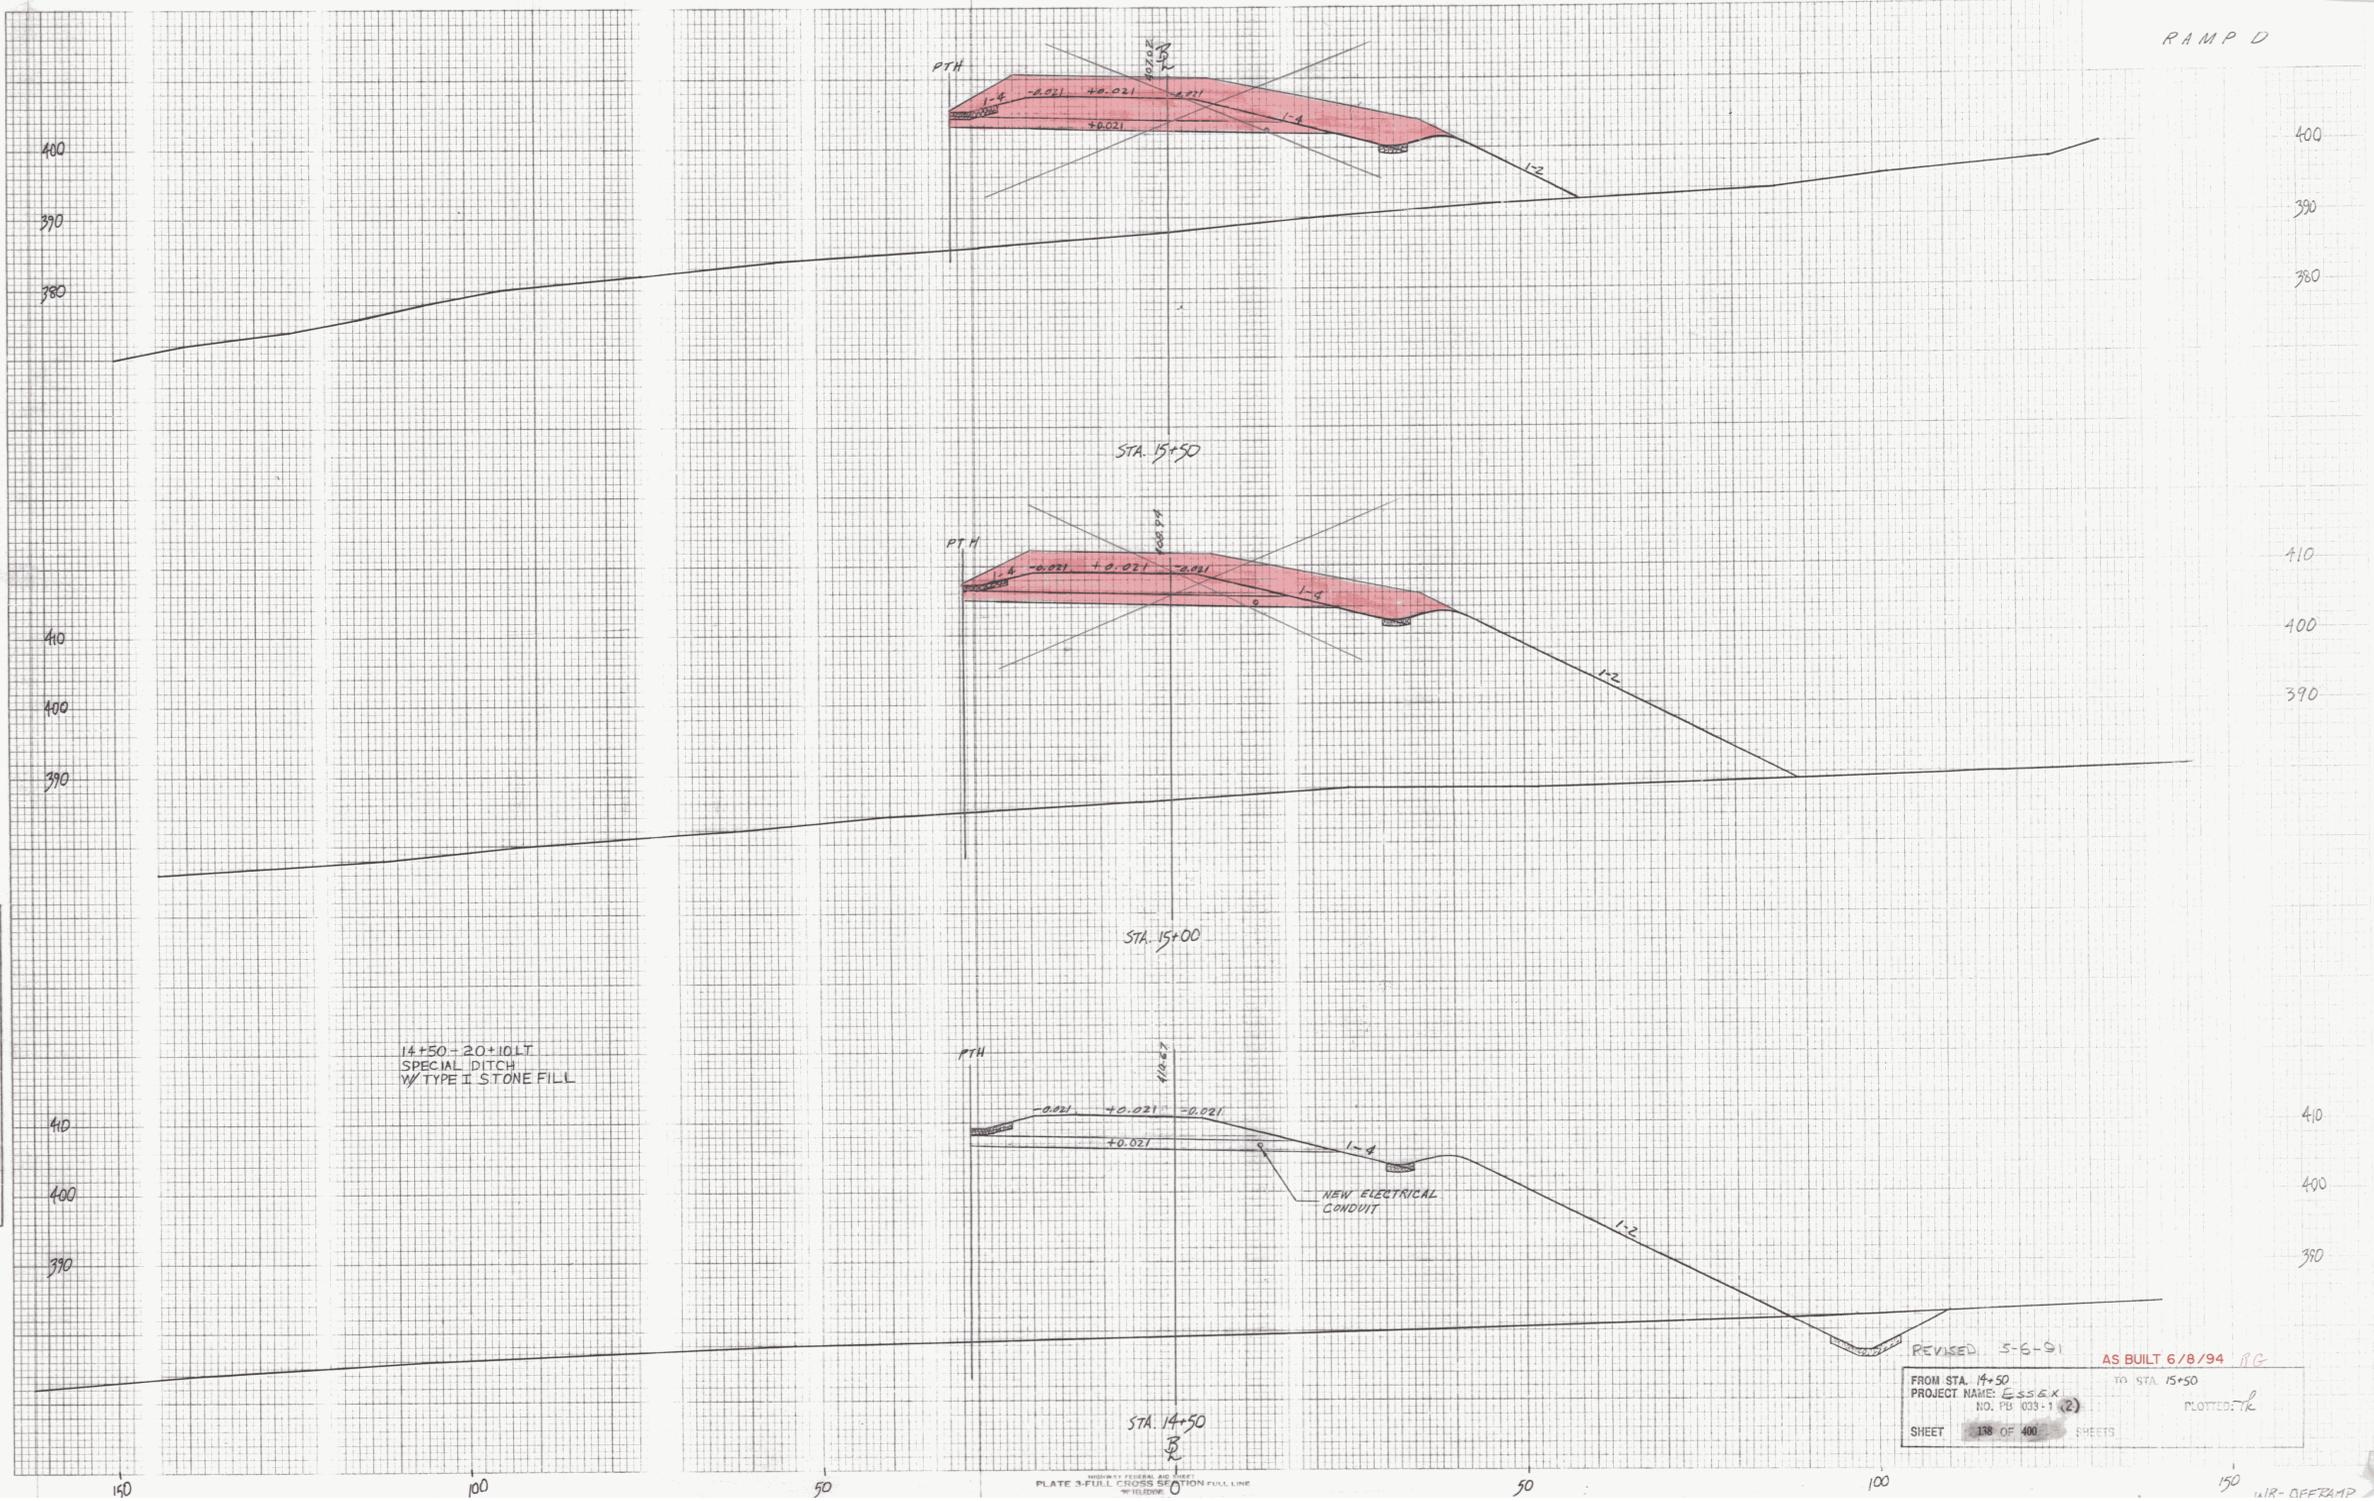

14+50 - 20+10 LT
SPECIAL DITCH
1/2" TYPE I STONE FILL

NEW ELECTRICAL
CONDUIT

REVISED 5-6-91 AS BUILT 6/8/94 PG
 FROM STA. 14+50 TO STA. 15+50
 PROJECT NAME: ESSEX
 NO. PB 033-1 (2) PLOTTED: 7/2
 SHEET 138 OF 400 SHEETS

FINAL SURVEY BY DATE
 SURVEYED BY DATE
 NOTE BOOK NO. DATE
 TEMPLATE NO. DATE
 AREAS CHECKED

ORIGINAL SURVEY BY DATE
 SURVEYED BY DATE
 NOTE BOOK NO. DATE
 TEMPLATE NO. DATE
 AREAS CHECKED

PLATE 3-FULL CROSS SECTION FULL LINE

WR-OFFRAMP