


FINAL	DATE
SURVEY	BY
NOTED	
NO.	
AREAS CHECKED	

ORIGINAL	DATE
SURVEY	BY
NOTED	
NO.	
AREAS CHECKED	

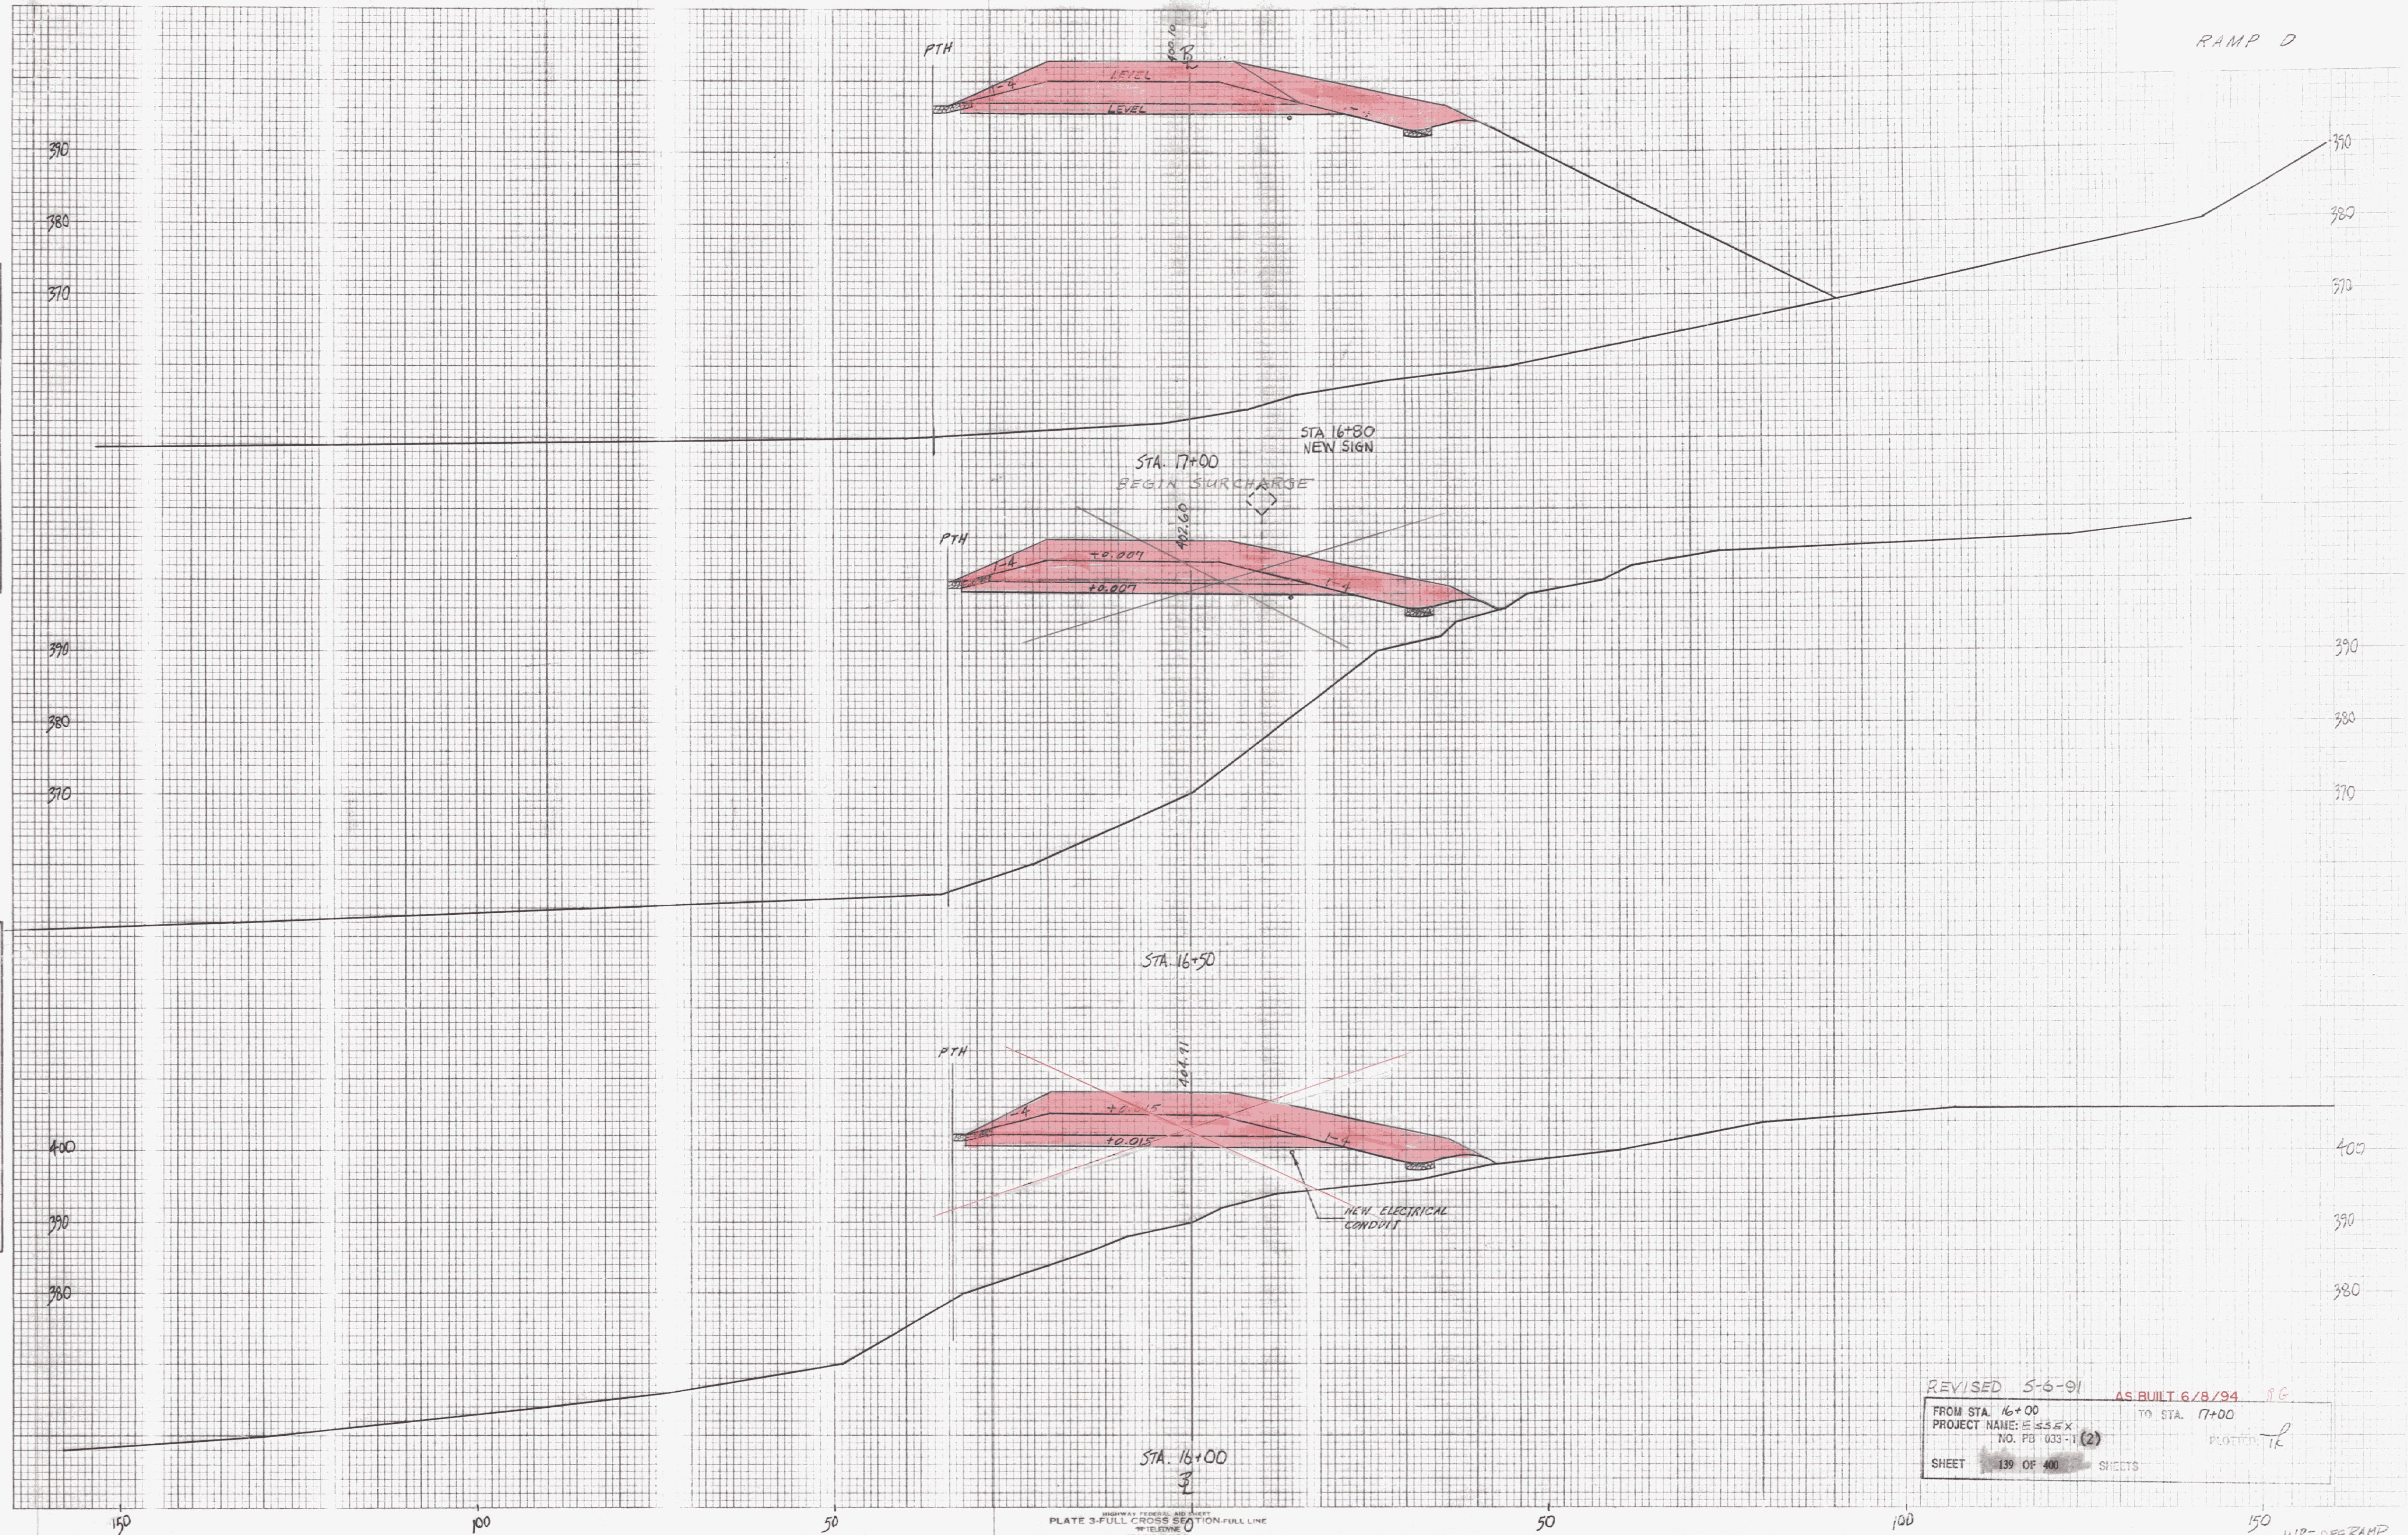

REVISED 5-6-91 AS BUILT 6/8/94
FROM STA. 16+00 TO STA. 17+00
PROJECT NAME: E 55 EX
NO. PB 033-11 (2)
SHEET 139 OF 400 SHEETS
PLOTTED: TK