


RAMP D

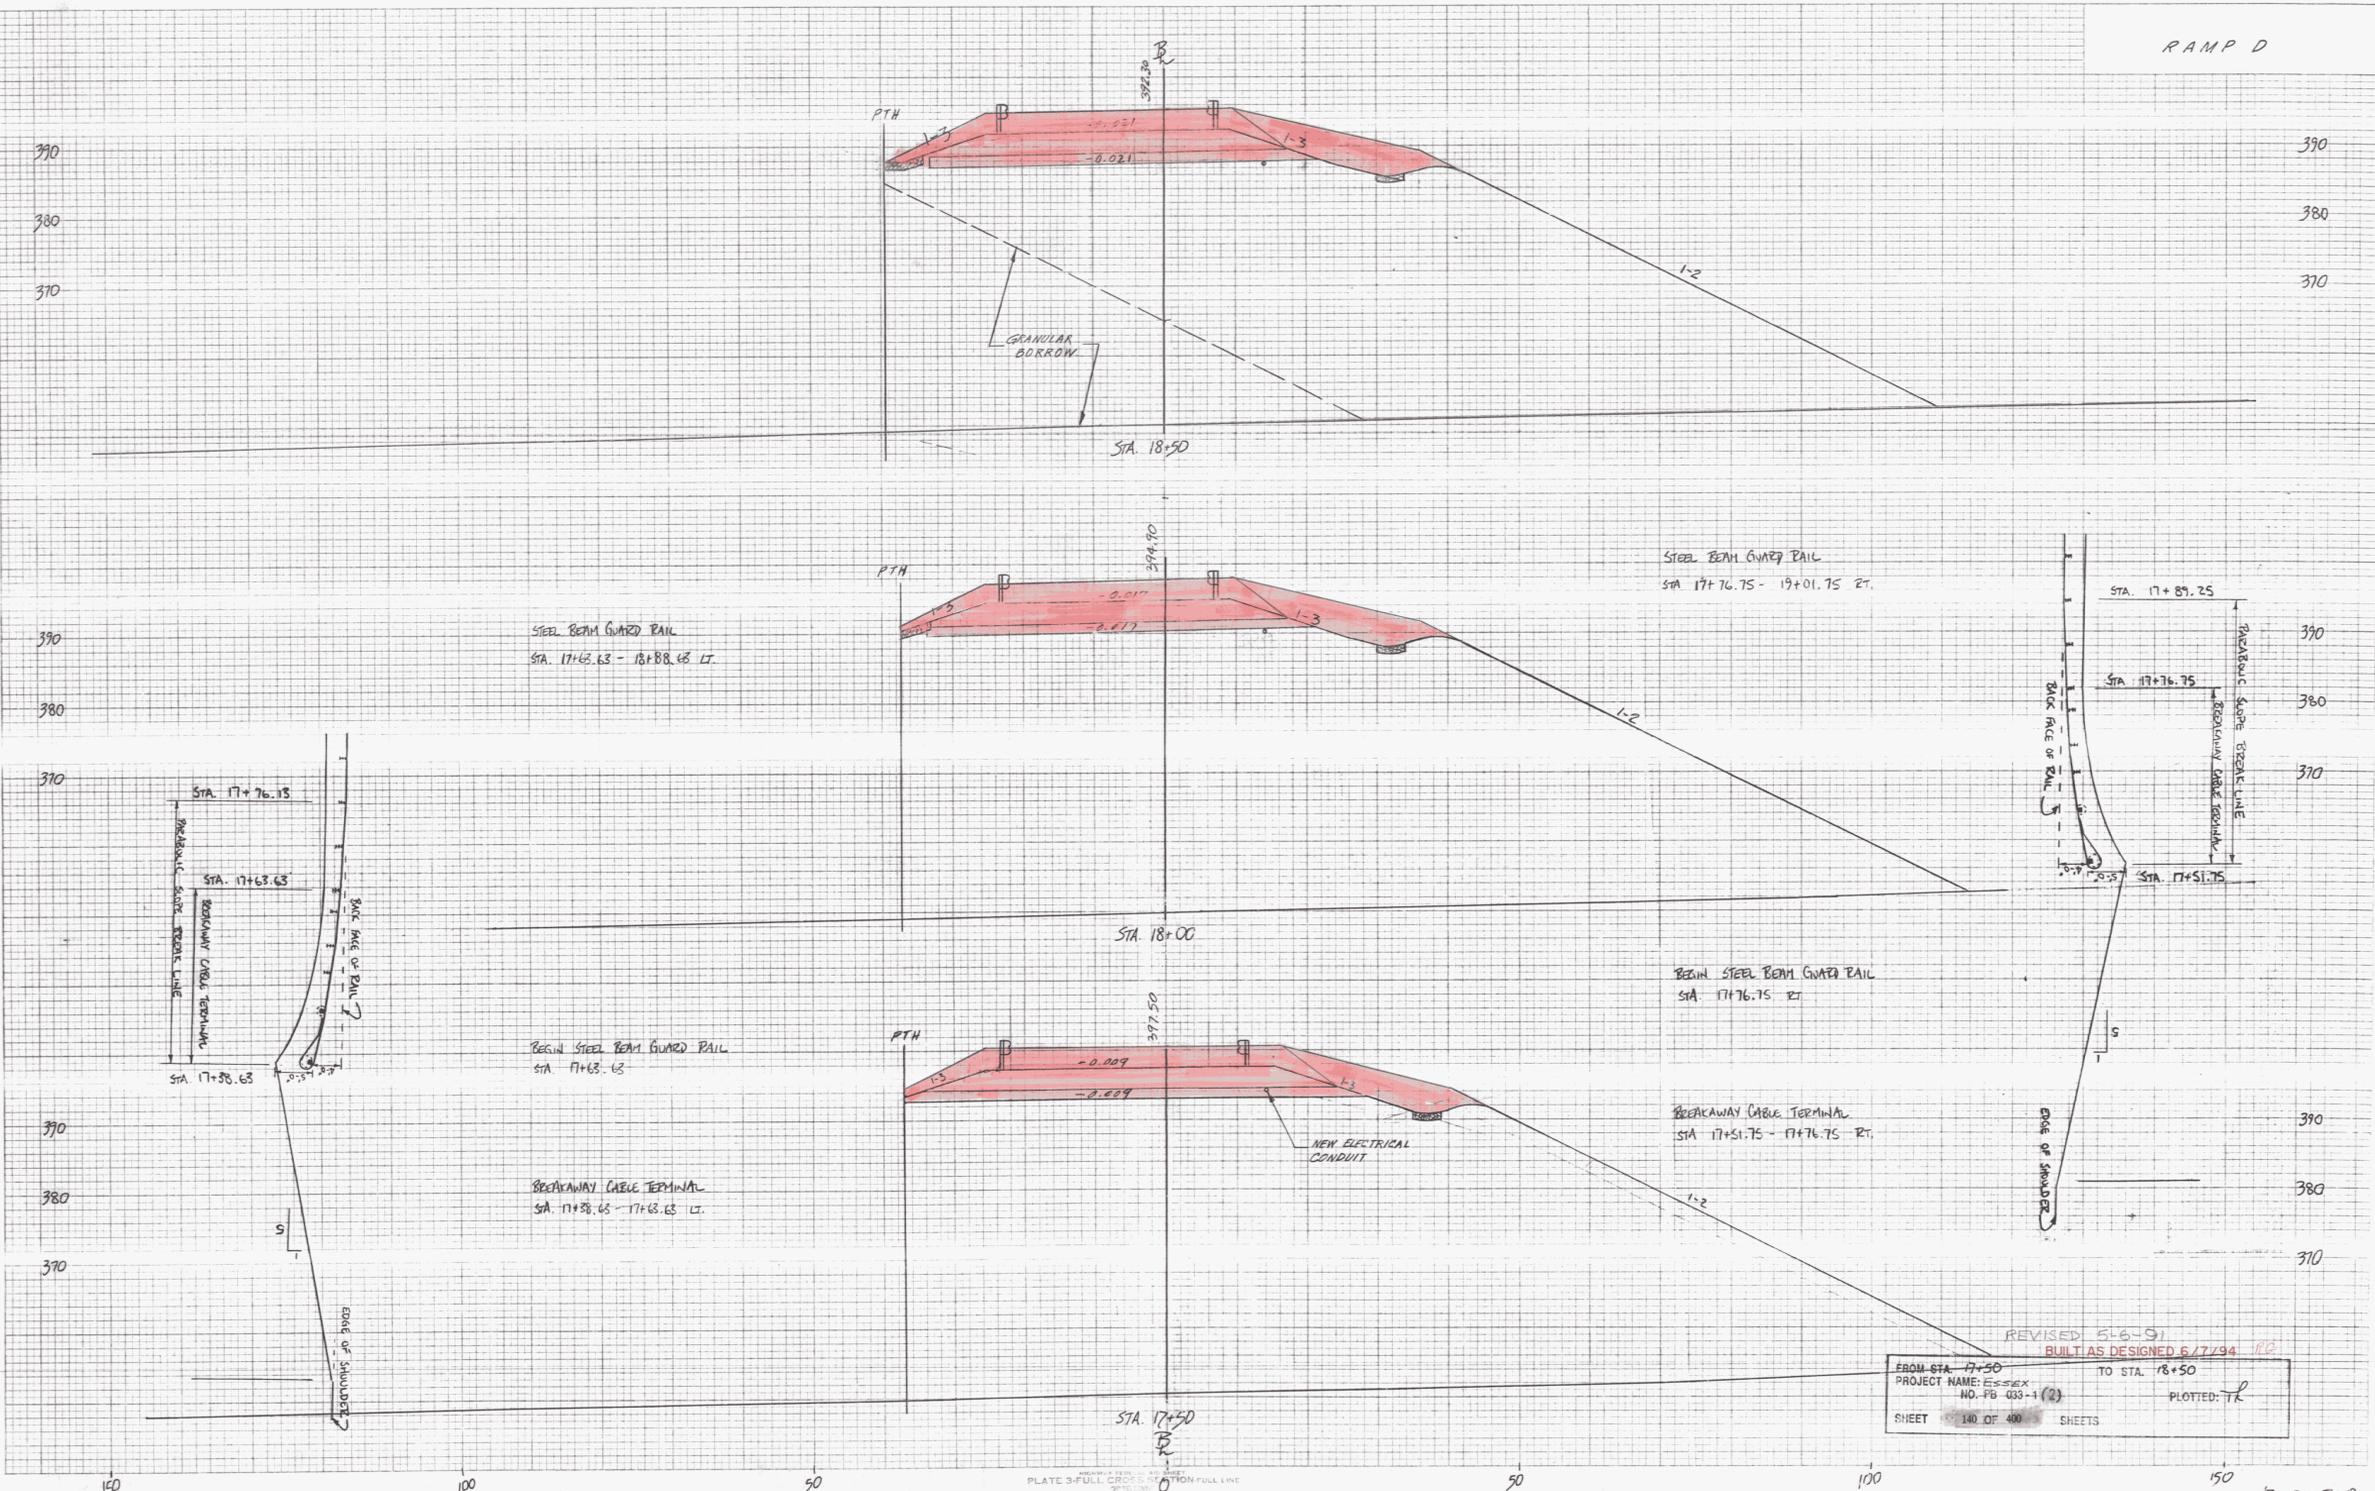

DATE _____ BY _____
 FINAL SURVEY DRAWING
 NOTE BOOK TEMPLATE NO. _____

DATE _____ BY _____
 ORIGINAL SURVEY DRAWING
 NOTE BOOK TEMPLATE NO. _____

REVISI 5-16-91
 BUILT AS DESIGNED 6/7/94
 FROM STA. 17+50 TO STA. 18+50
 PROJECT NAME: ESSEX
 NO. FB 033-1 (2) PLOTTED: TR
 SHEET 140 OF 400 SHEETS

PLATE 3-FULL CROSS SECTION FULL LINE
 SCALE: 1" = 10'

1/2" - OFF BOARD