


RAMP D

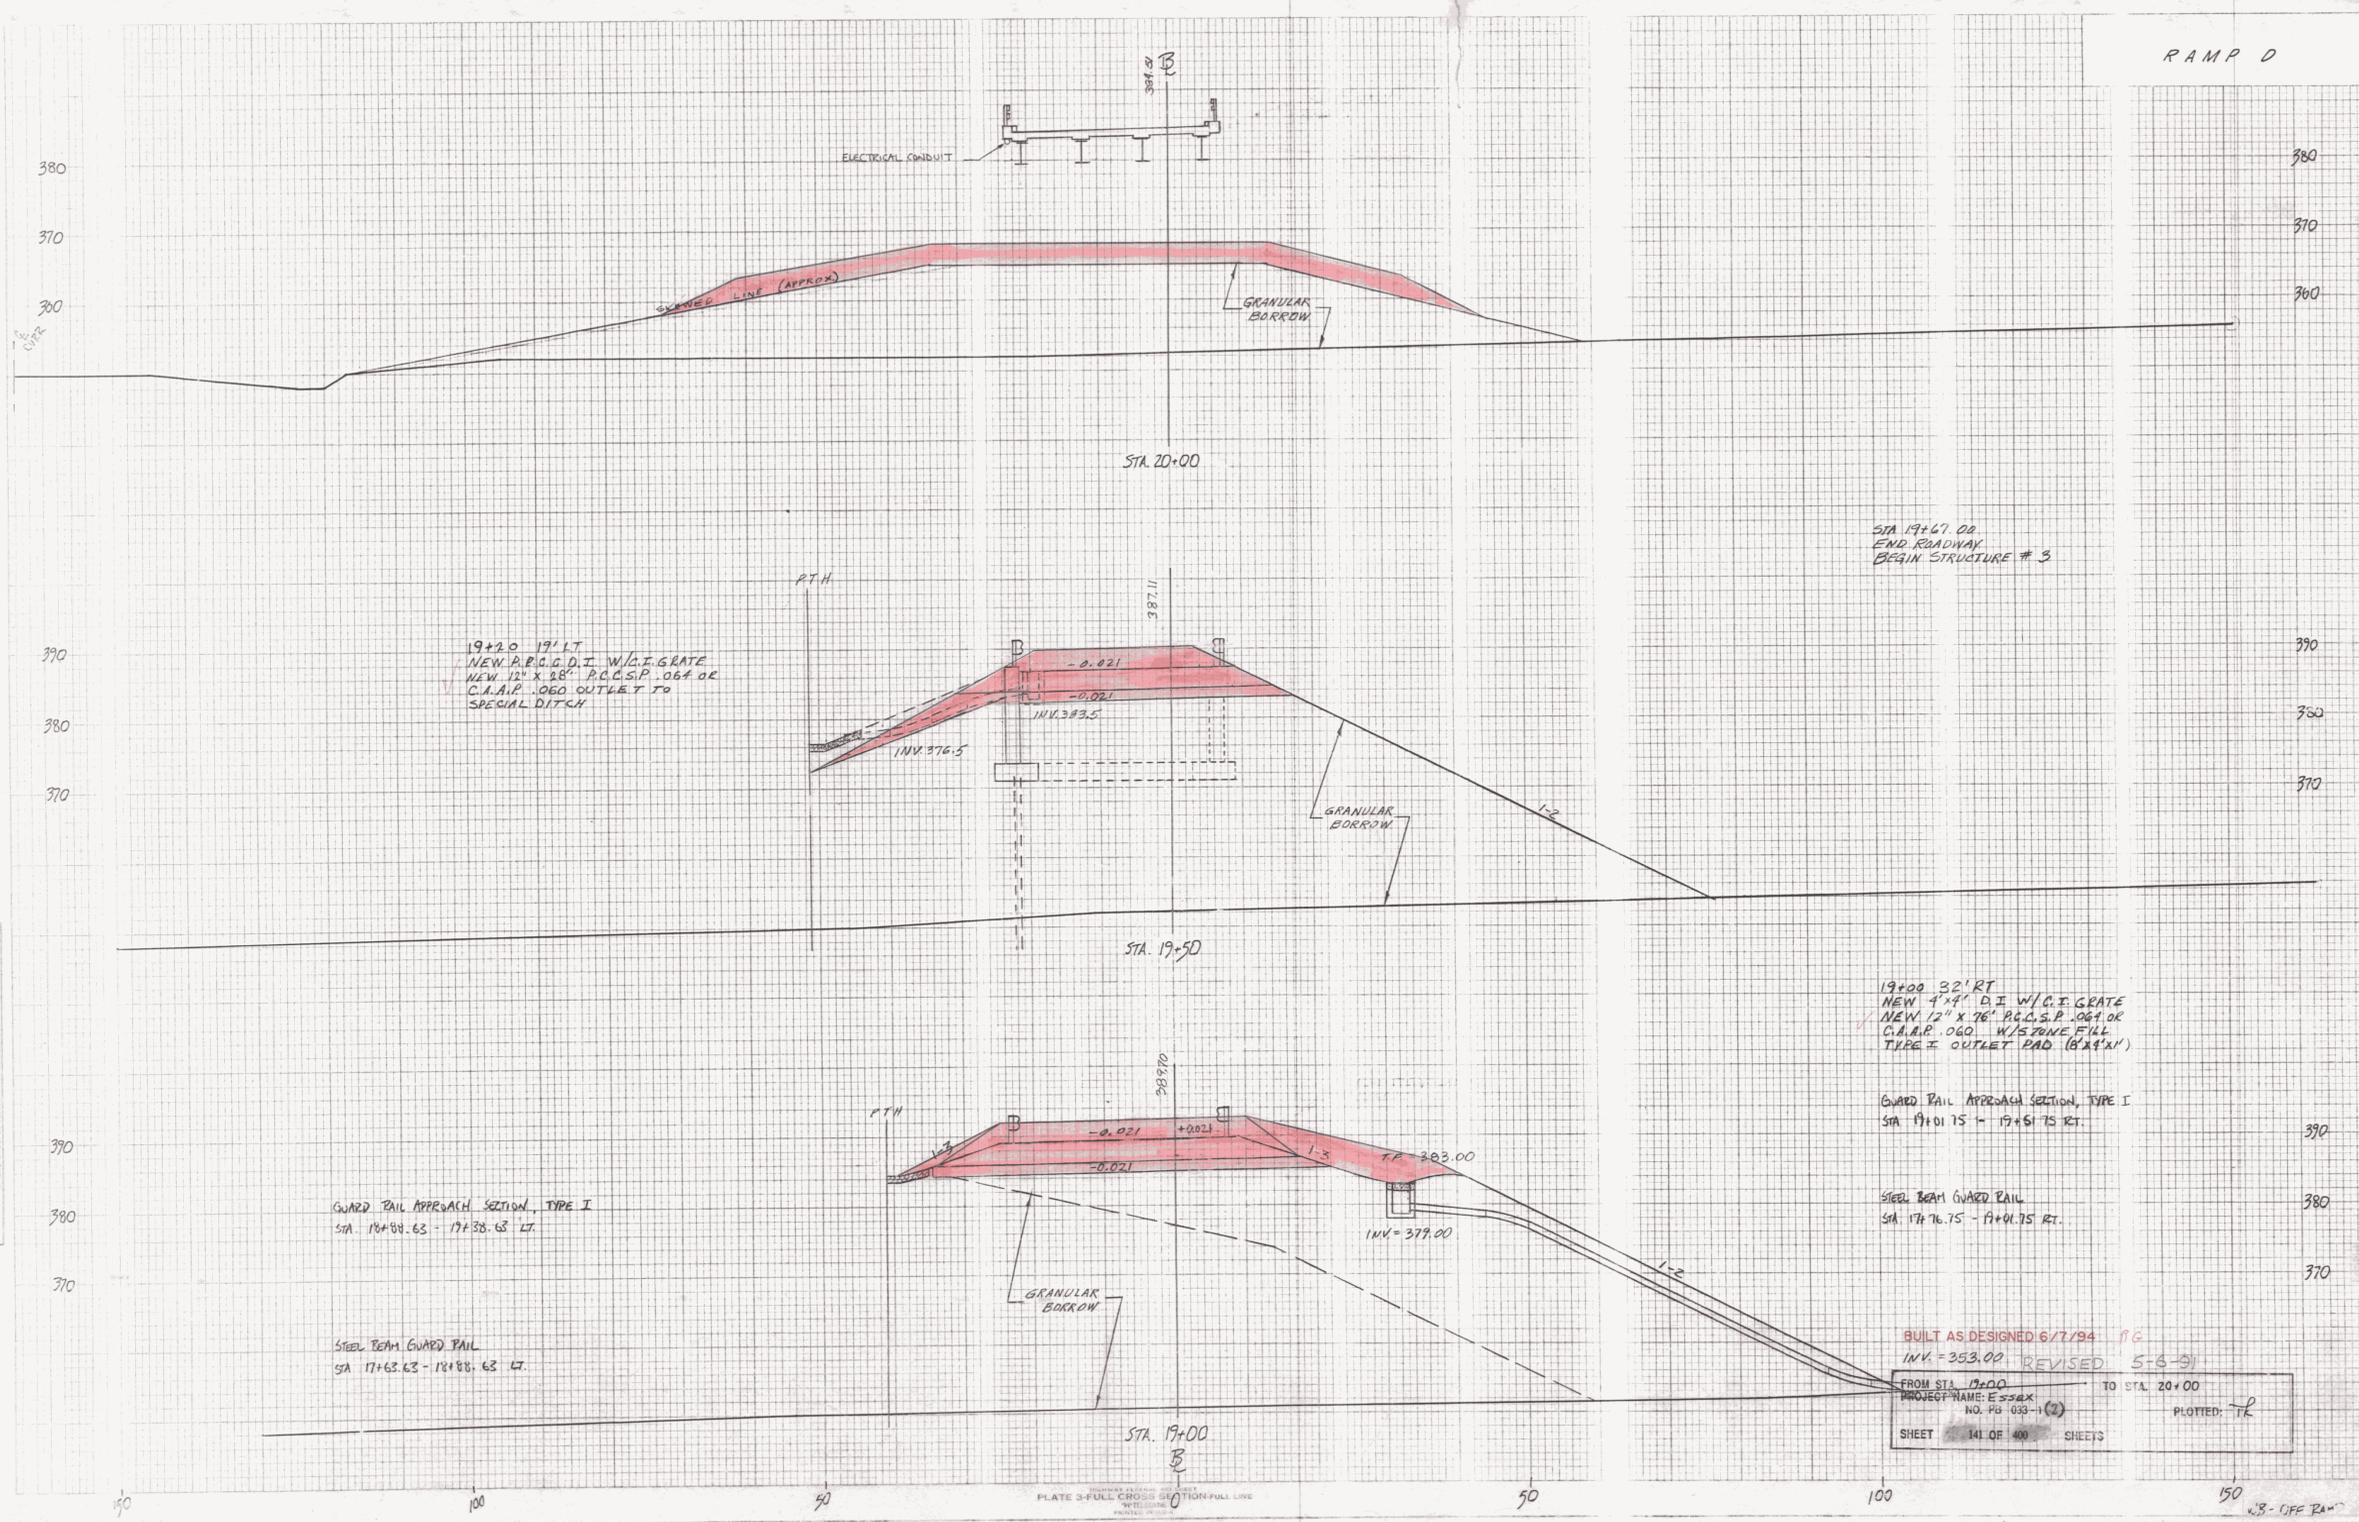

FINAL SURVEY BY DATE  
 NO. OF BOARDS  
 NO. OF SHEETS  
 NO. OF COPIES

ORIGINAL SURVEY BY DATE  
 NO. OF BOARDS  
 NO. OF SHEETS  
 NO. OF COPIES

19+20 19' LT  
 NEW 12" X 28" P.C.S.P. 0.64 OR  
 C.A.A.P. 0.60 OUTLET TO  
 SPECIAL DITCH

STA 19+61.00  
 END ROADWAY  
 BEGIN STRUCTURE # 3

GUARD RAIL APPROACH SECTION, TYPE I  
 STA 18+58.63 - 19+38.63 LT.

19+00 32' RT  
 NEW 4' X 4' D.I. W/C.I. GRATE  
 NEW 12" X 28" P.C.S.P. 0.64 OR  
 C.A.A.P. 0.60 W/S PRIME FILL  
 TYPE I OUTLET PAD (8' X 4')

STEEL BEAM GUARD RAIL  
 STA 17+63.63 - 18+08.63 LT.

GUARD RAIL APPROACH SECTION, TYPE I  
 STA 19+01.75 - 19+51.75 RT.

STEEL BEAM GUARD RAIL  
 STA 17+76.75 - 18+01.75 RT.

BUILT AS DESIGNED 6/7/94 18G  
 INV. = 353.00 REVISED 5-6-91  
 FROM STA. 17+00 TO STA. 20+00  
 PROJECT NAME: ESSEX  
 NO. PG. 033-1 (2) PLOTTED: TR  
 SHEET 141 OF 400 SHEETS

PLATE 3-FULL CROSS SECTION FULL LINE  
 PRINTED ON 11" X 17" PAPER

18-OFF PLAN