


VERMONT ROUTE 289

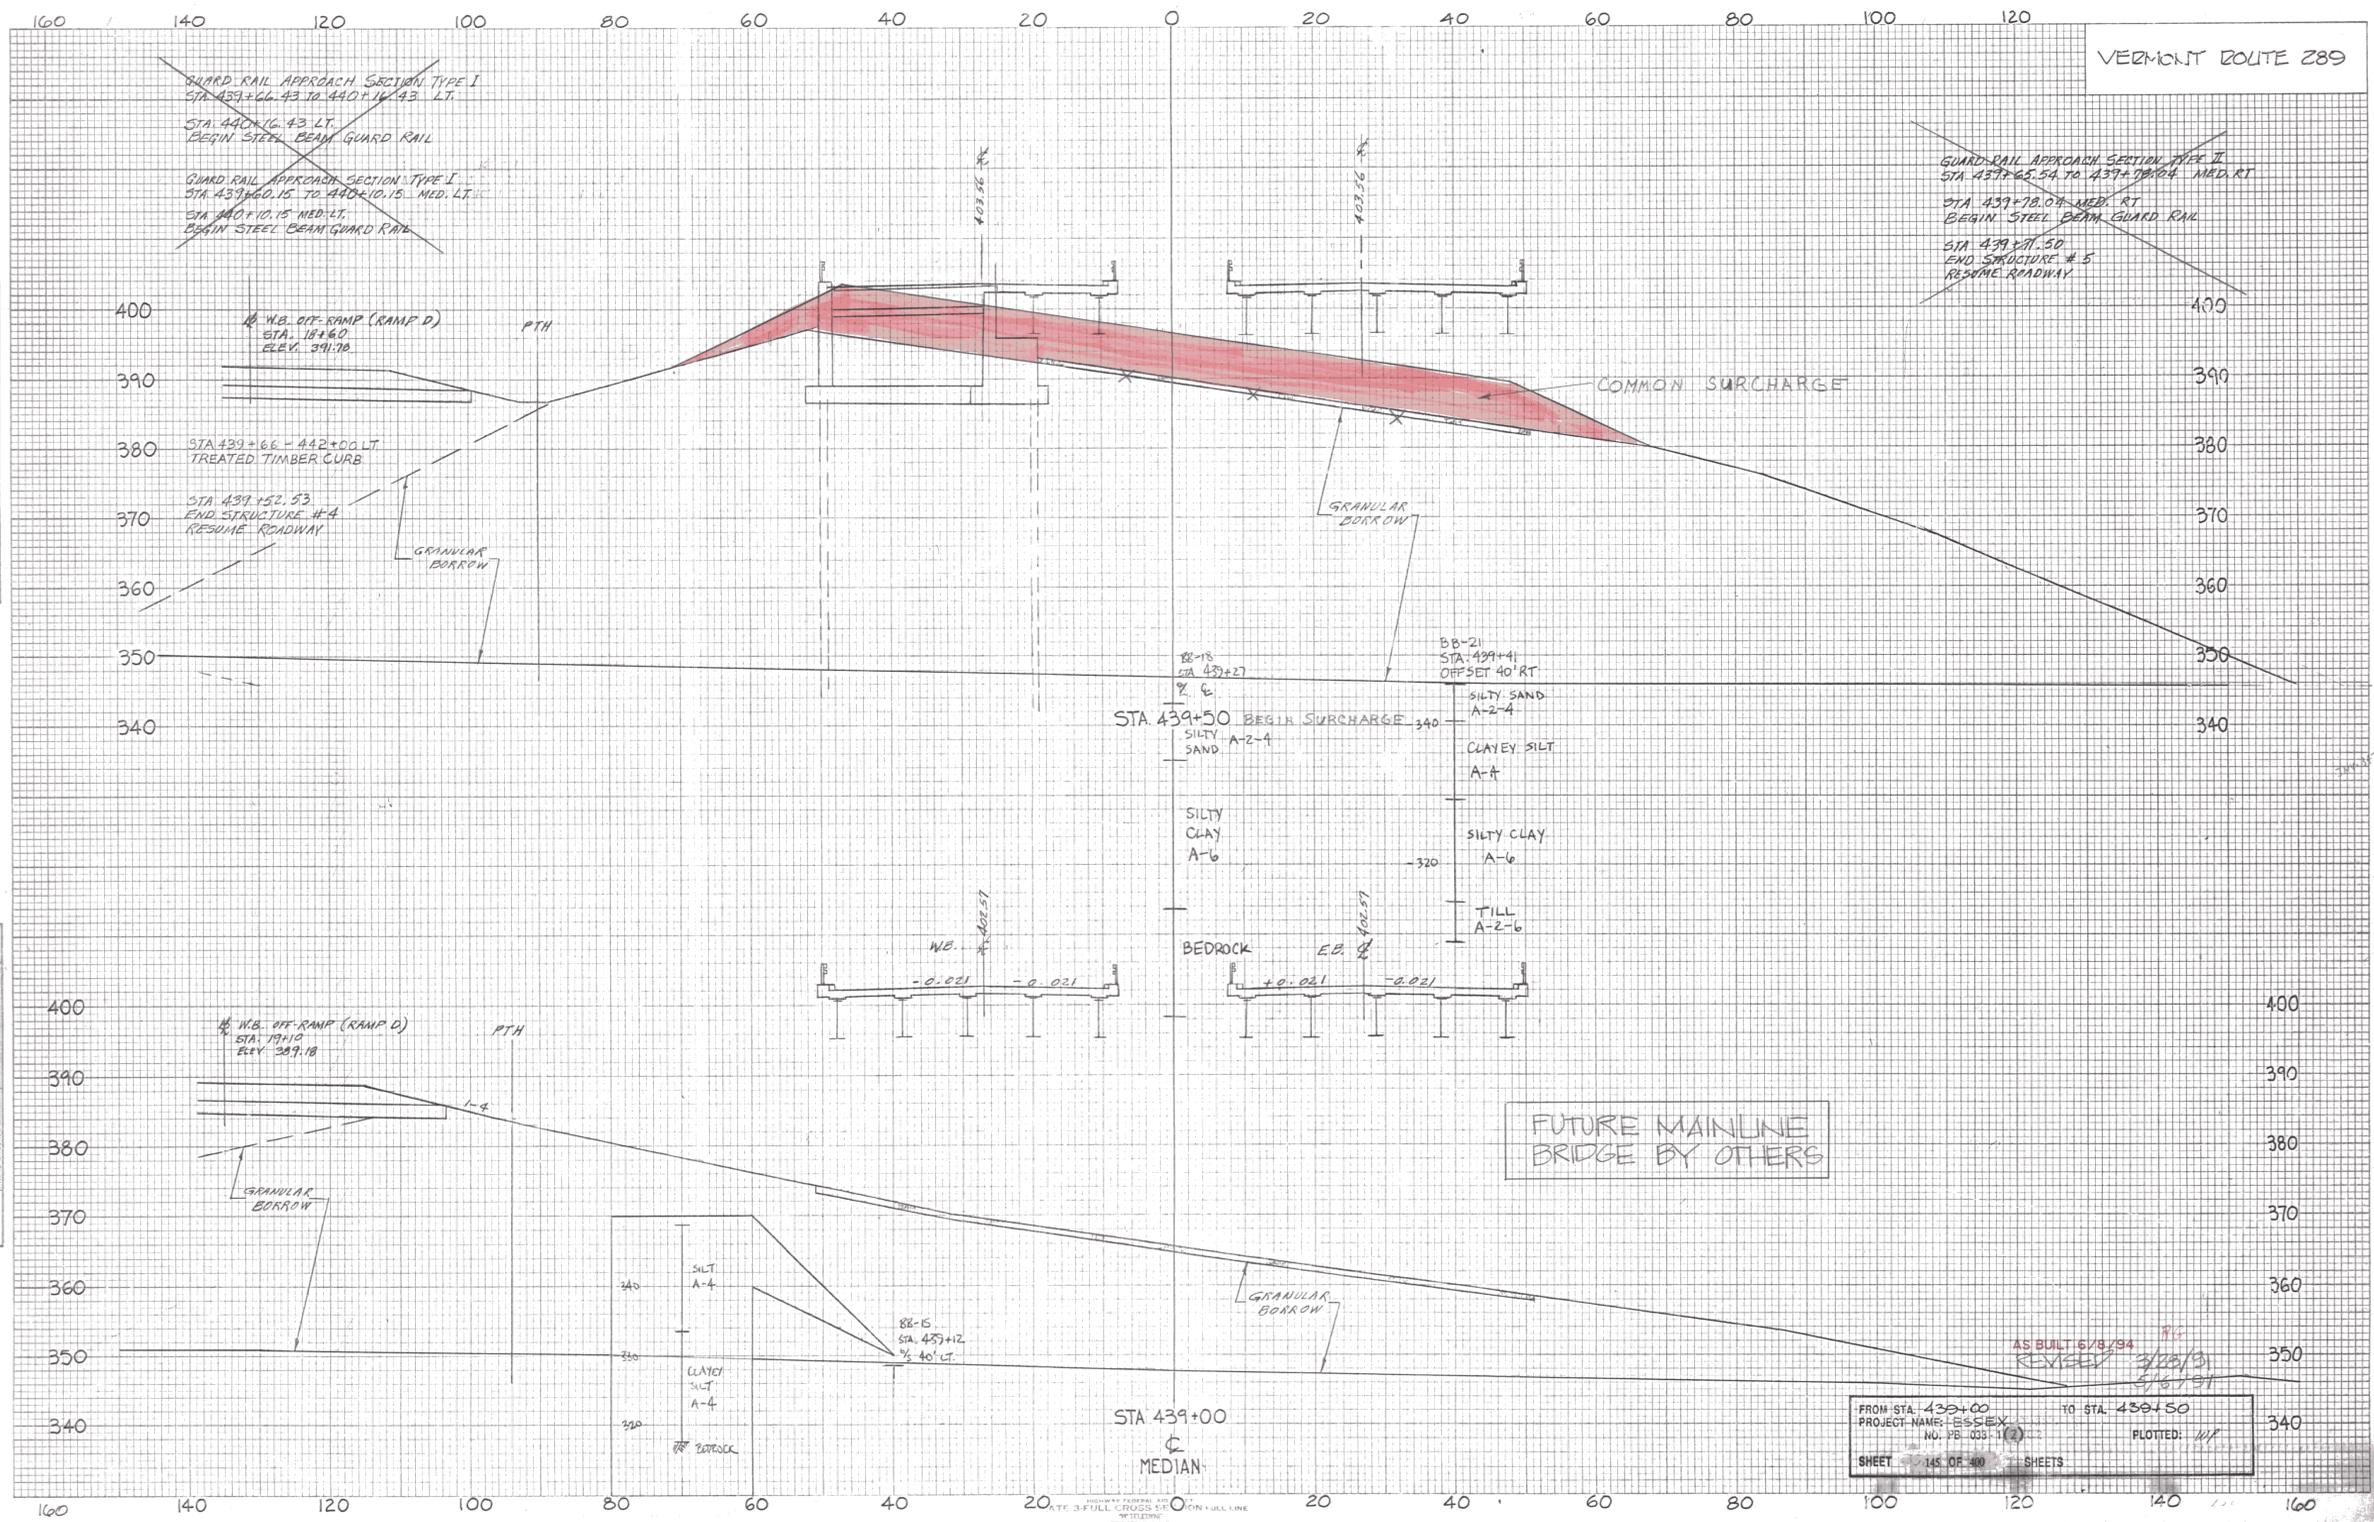

~~GUARD RAIL APPROACH SECTION TYPE I  
STA. 439+66.43 TO 440+16.43 LT.  
STA. 440+16.43 LT.  
BEGIN STEEL BEAM GUARD RAIL~~

~~GUARD RAIL APPROACH SECTION TYPE I  
STA. 439+60.15 TO 440+10.15 MED. LT.  
STA. 440+10.15 MED. LT.  
BEGIN STEEL BEAM GUARD RAIL~~

~~GUARD RAIL APPROACH SECTION TYPE II  
STA. 439+65.54 TO 439+78.04 MED. RT.  
STA. 439+78.04 MED. RT.  
BEGIN STEEL BEAM GUARD RAIL~~

~~STA. 439+78.50  
END STRUCTURE # 5  
RESUME ROADWAY~~

14' W.B. OFF-RAMP (RAMP D)  
STA. 18+60  
ELEV. 391.78

STA. 439+66 - 442+00 LT  
TREATED TIMBER CURB

STA. 439+52.53  
END STRUCTURE # 4  
RESUME ROADWAY

STA. 439+50 BEGIN SURCHARGE

FUTURE MAINLINE  
BRIDGE BY OTHERS

AS BUILT 6/8/94  
REVISED 3/28/95  
5/6/95

FROM STA. 439+00 TO STA. 439+50  
PROJECT NAME: ESSEX  
NO. PB. 035-1(2)  
SHEET 145 OF 400 SHEETS  
PLOTTED: 1/17

DATE: \_\_\_\_\_  
BY: \_\_\_\_\_  
CHECKED: \_\_\_\_\_  
DATE: \_\_\_\_\_  
BY: \_\_\_\_\_  
CHECKED: \_\_\_\_\_  
DATE 3/11/95