


VERMONT ROUTE 289

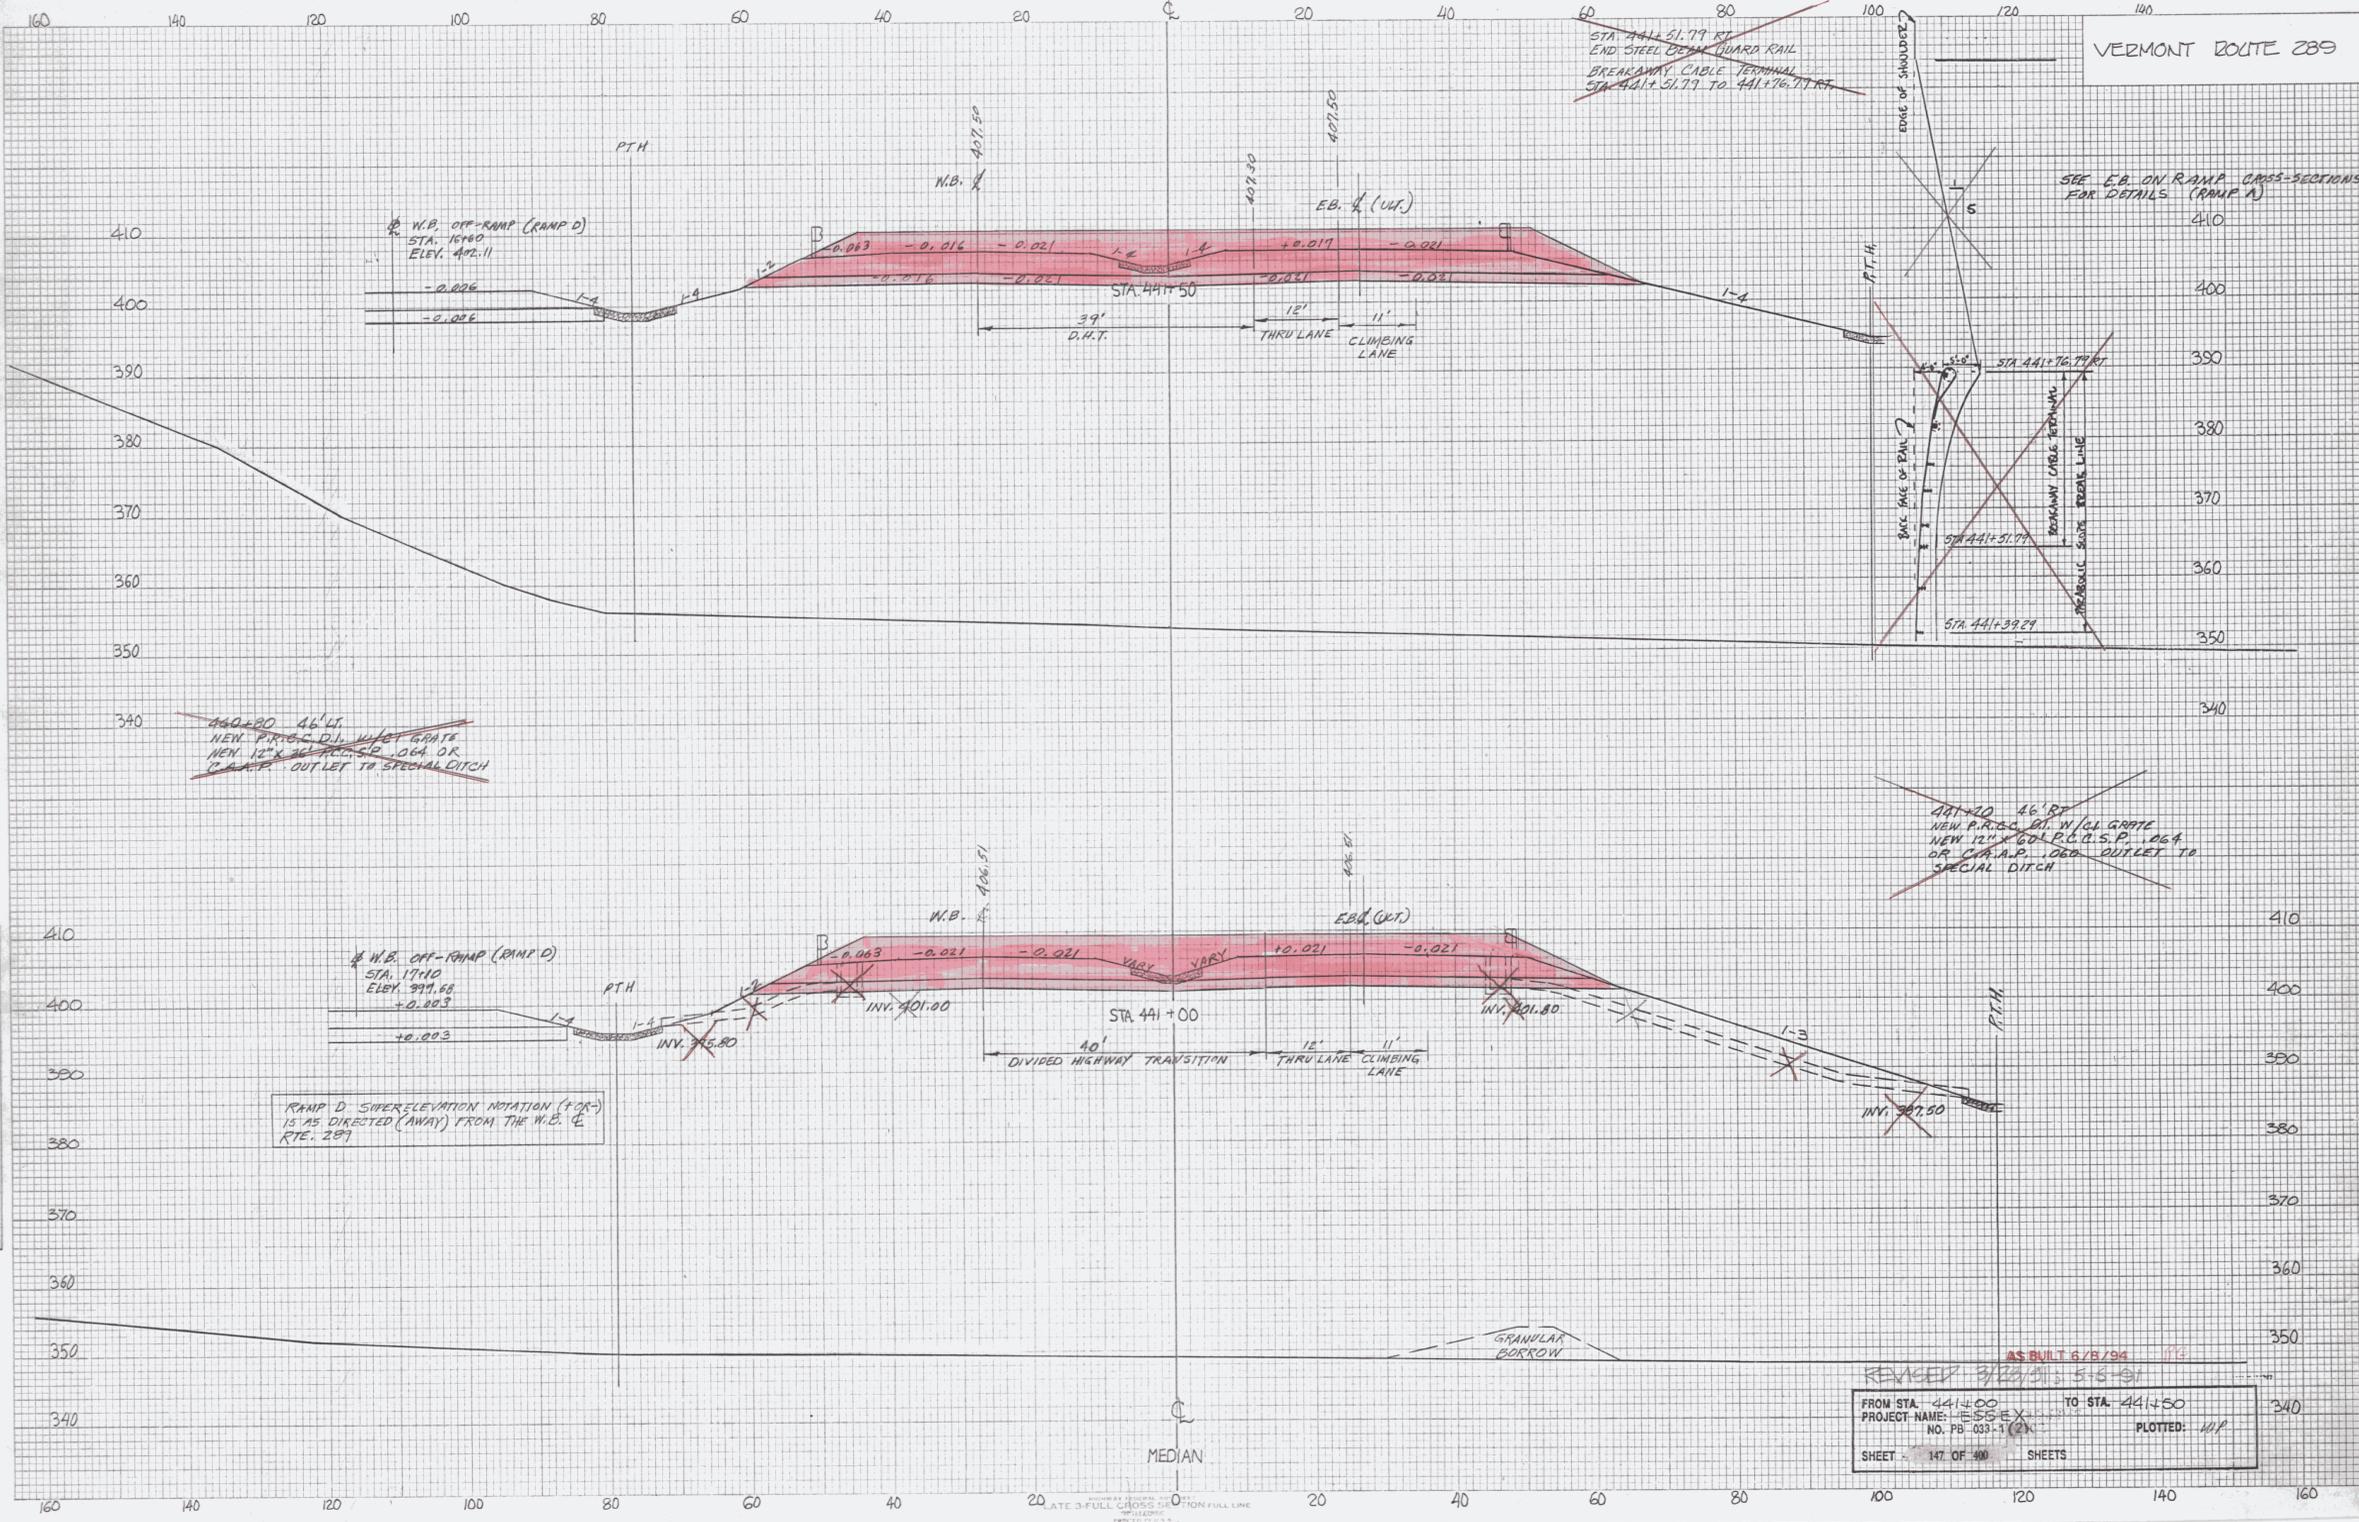

FINAL SURVEY BY DATE
 DRAWN BY DATE
 CHECKED BY DATE
 NOTE BOOK NO.
 AREA CHECKED

ORIGINAL SURVEY BY DATE
 DRAWN BY DATE
 CHECKED BY DATE
 NOTE BOOK NO.
 AREA CHECKED

FROM STA. 441+00 TO STA. 441+50
 PROJECT NAME: ESSEX
 NO. PB 033-1(2)
 SHEET 17 OF 40 SHEETS
 PLOTTED: 1/1/91