


VERMONT ROUTE 289

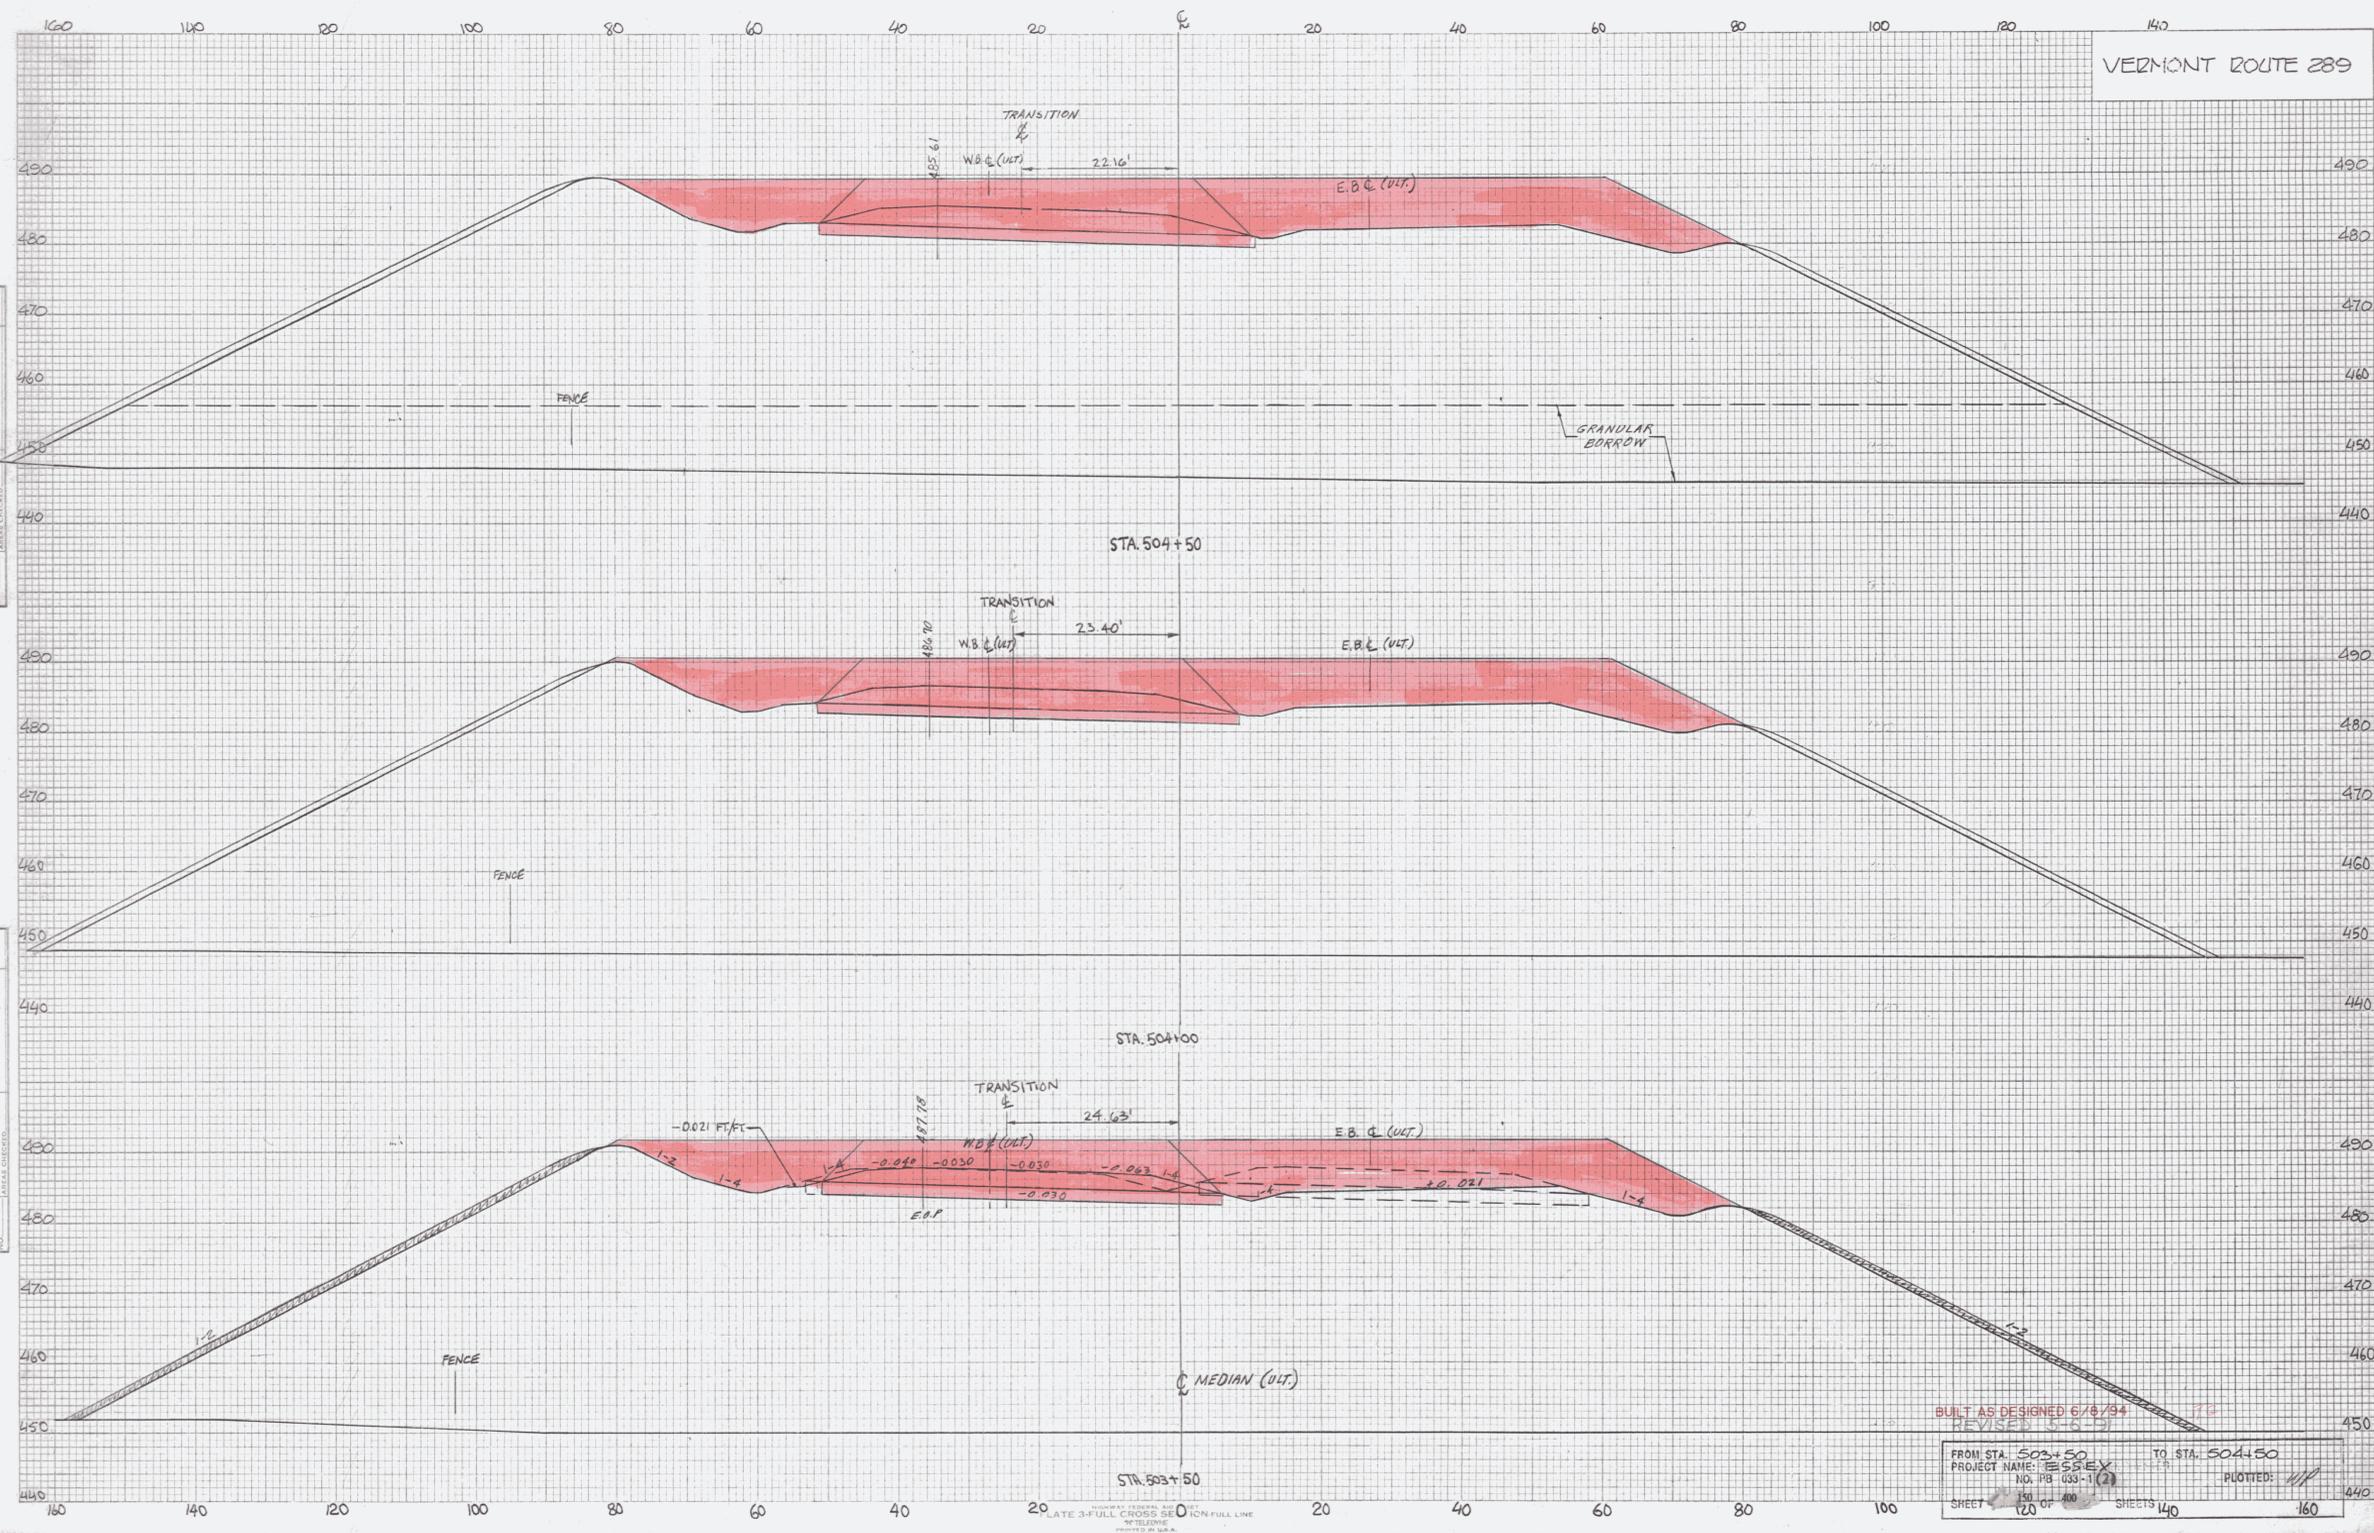

DATE: \_\_\_\_\_ BY: \_\_\_\_\_  
 FINAL SURVEY: \_\_\_\_\_  
 REVISIONS: \_\_\_\_\_  
 NOTE BOOK: \_\_\_\_\_  
 NO. \_\_\_\_\_  
 ASSES CHECKED: \_\_\_\_\_

DATE: \_\_\_\_\_ BY: \_\_\_\_\_  
 ORIGINAL SURVEY: \_\_\_\_\_  
 REVISIONS: \_\_\_\_\_  
 NOTE BOOK: \_\_\_\_\_  
 NO. \_\_\_\_\_  
 ASSES CHECKED: \_\_\_\_\_

BUILT AS DESIGNED 6/8/94  
 REVISED 3-5-91  
 FROM STA. 503+50 TO STA. 504+50  
 PROJECT NAME: ESSEX  
 NO. PB 033-1 (2)  
 SHEET 151 OF 400 SHEETS 140  
 PLOTTED: *[Signature]*

PLATE 3-FULL CROSS SECTION FULL LINE  
 PRINTED BY S.M.A.