


VERMONT ROUTE 289

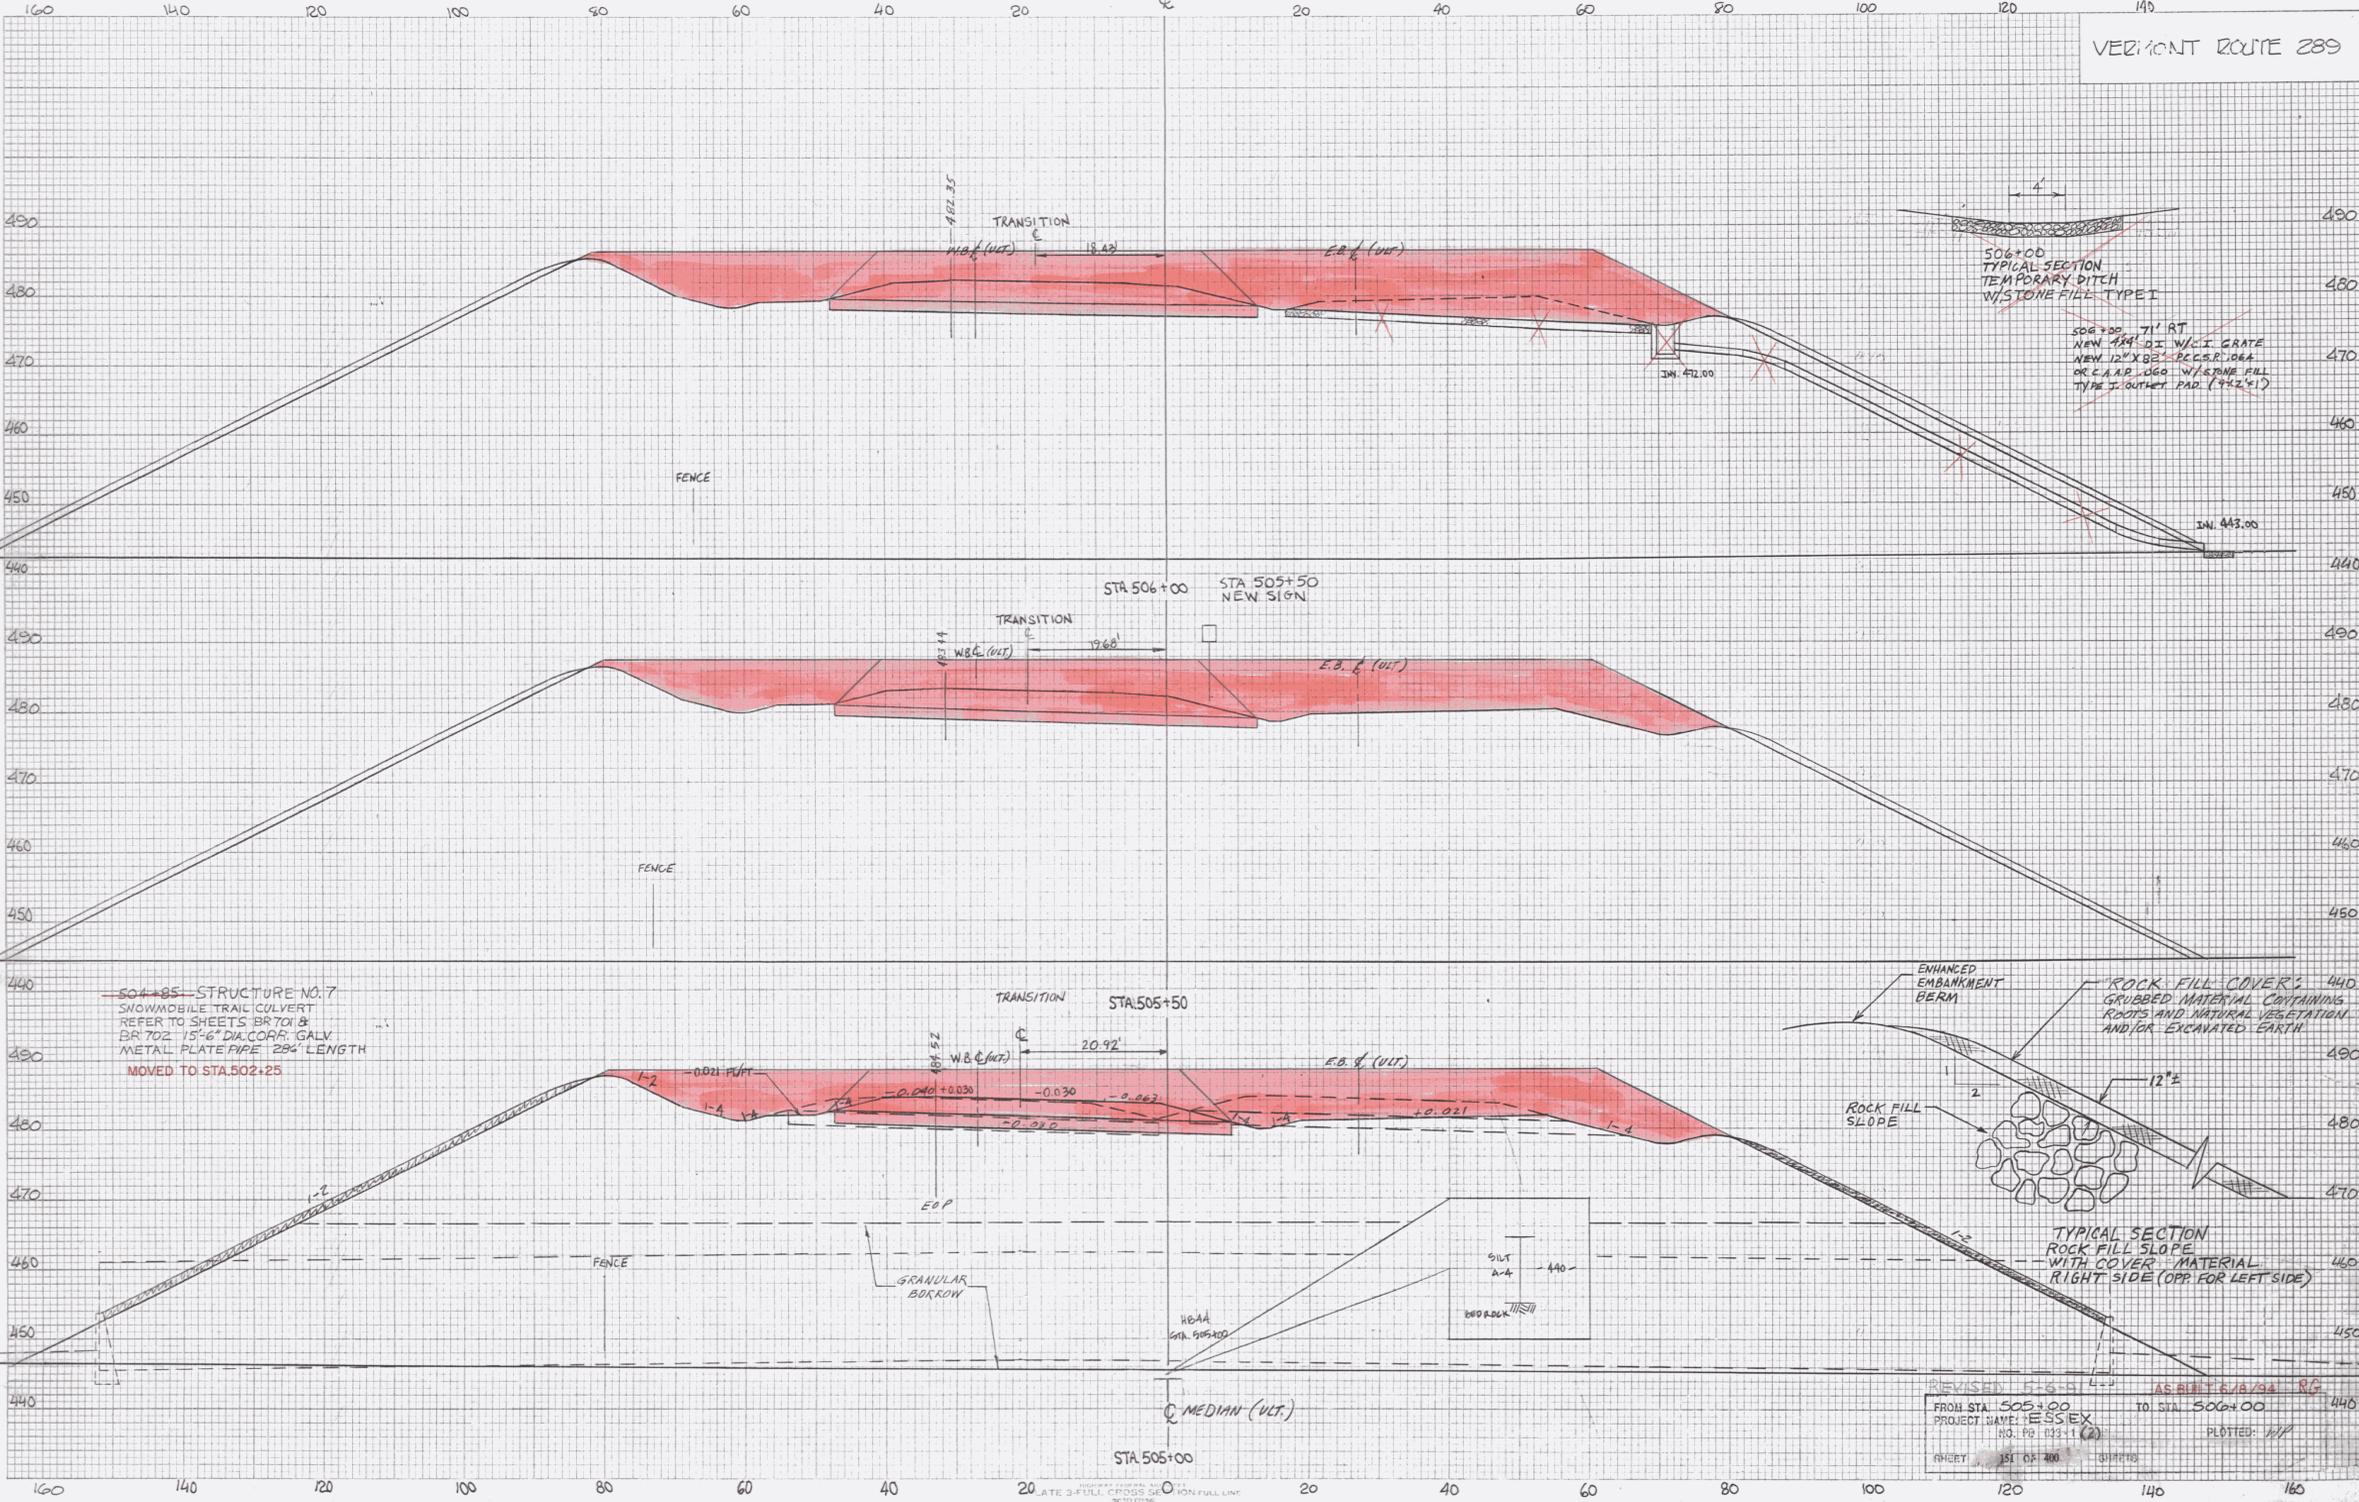

DATE: _____
 BY: _____
 ORIGINAL SURVEY NO. _____
 DATE PLOTTED: _____
 NOTE BOOK NO. _____
 AREA CHECKED: _____

DATE: _____
 BY: _____
 ORIGINAL SURVEY NO. _____
 DATE PLOTTED: _____
 NOTE BOOK NO. _____
 AREA CHECKED: _____

504+85 STRUCTURE NO. 7
 SNOWMOBILE TRAIL CULVERT
 REFER TO SHEETS BR 701 &
 BR 702 15" DIA. CORR. GALV.
 METAL PLATE PIPE 284' LENGTH
 MOVED TO STA. 502+25

REVISED 5/6/84
 FROM STA. 505+00 TO STA. 506+00
 PROJECT NAME: ESSEX
 NO. PG. 1035-11 (2)
 PLOTTED: 11/77
 SHEET 151 OF 400

DATE PLOTTED: 11/77
 PLOTTED BY: _____
 CHECKED BY: _____