


VERMONT ROUTE 289

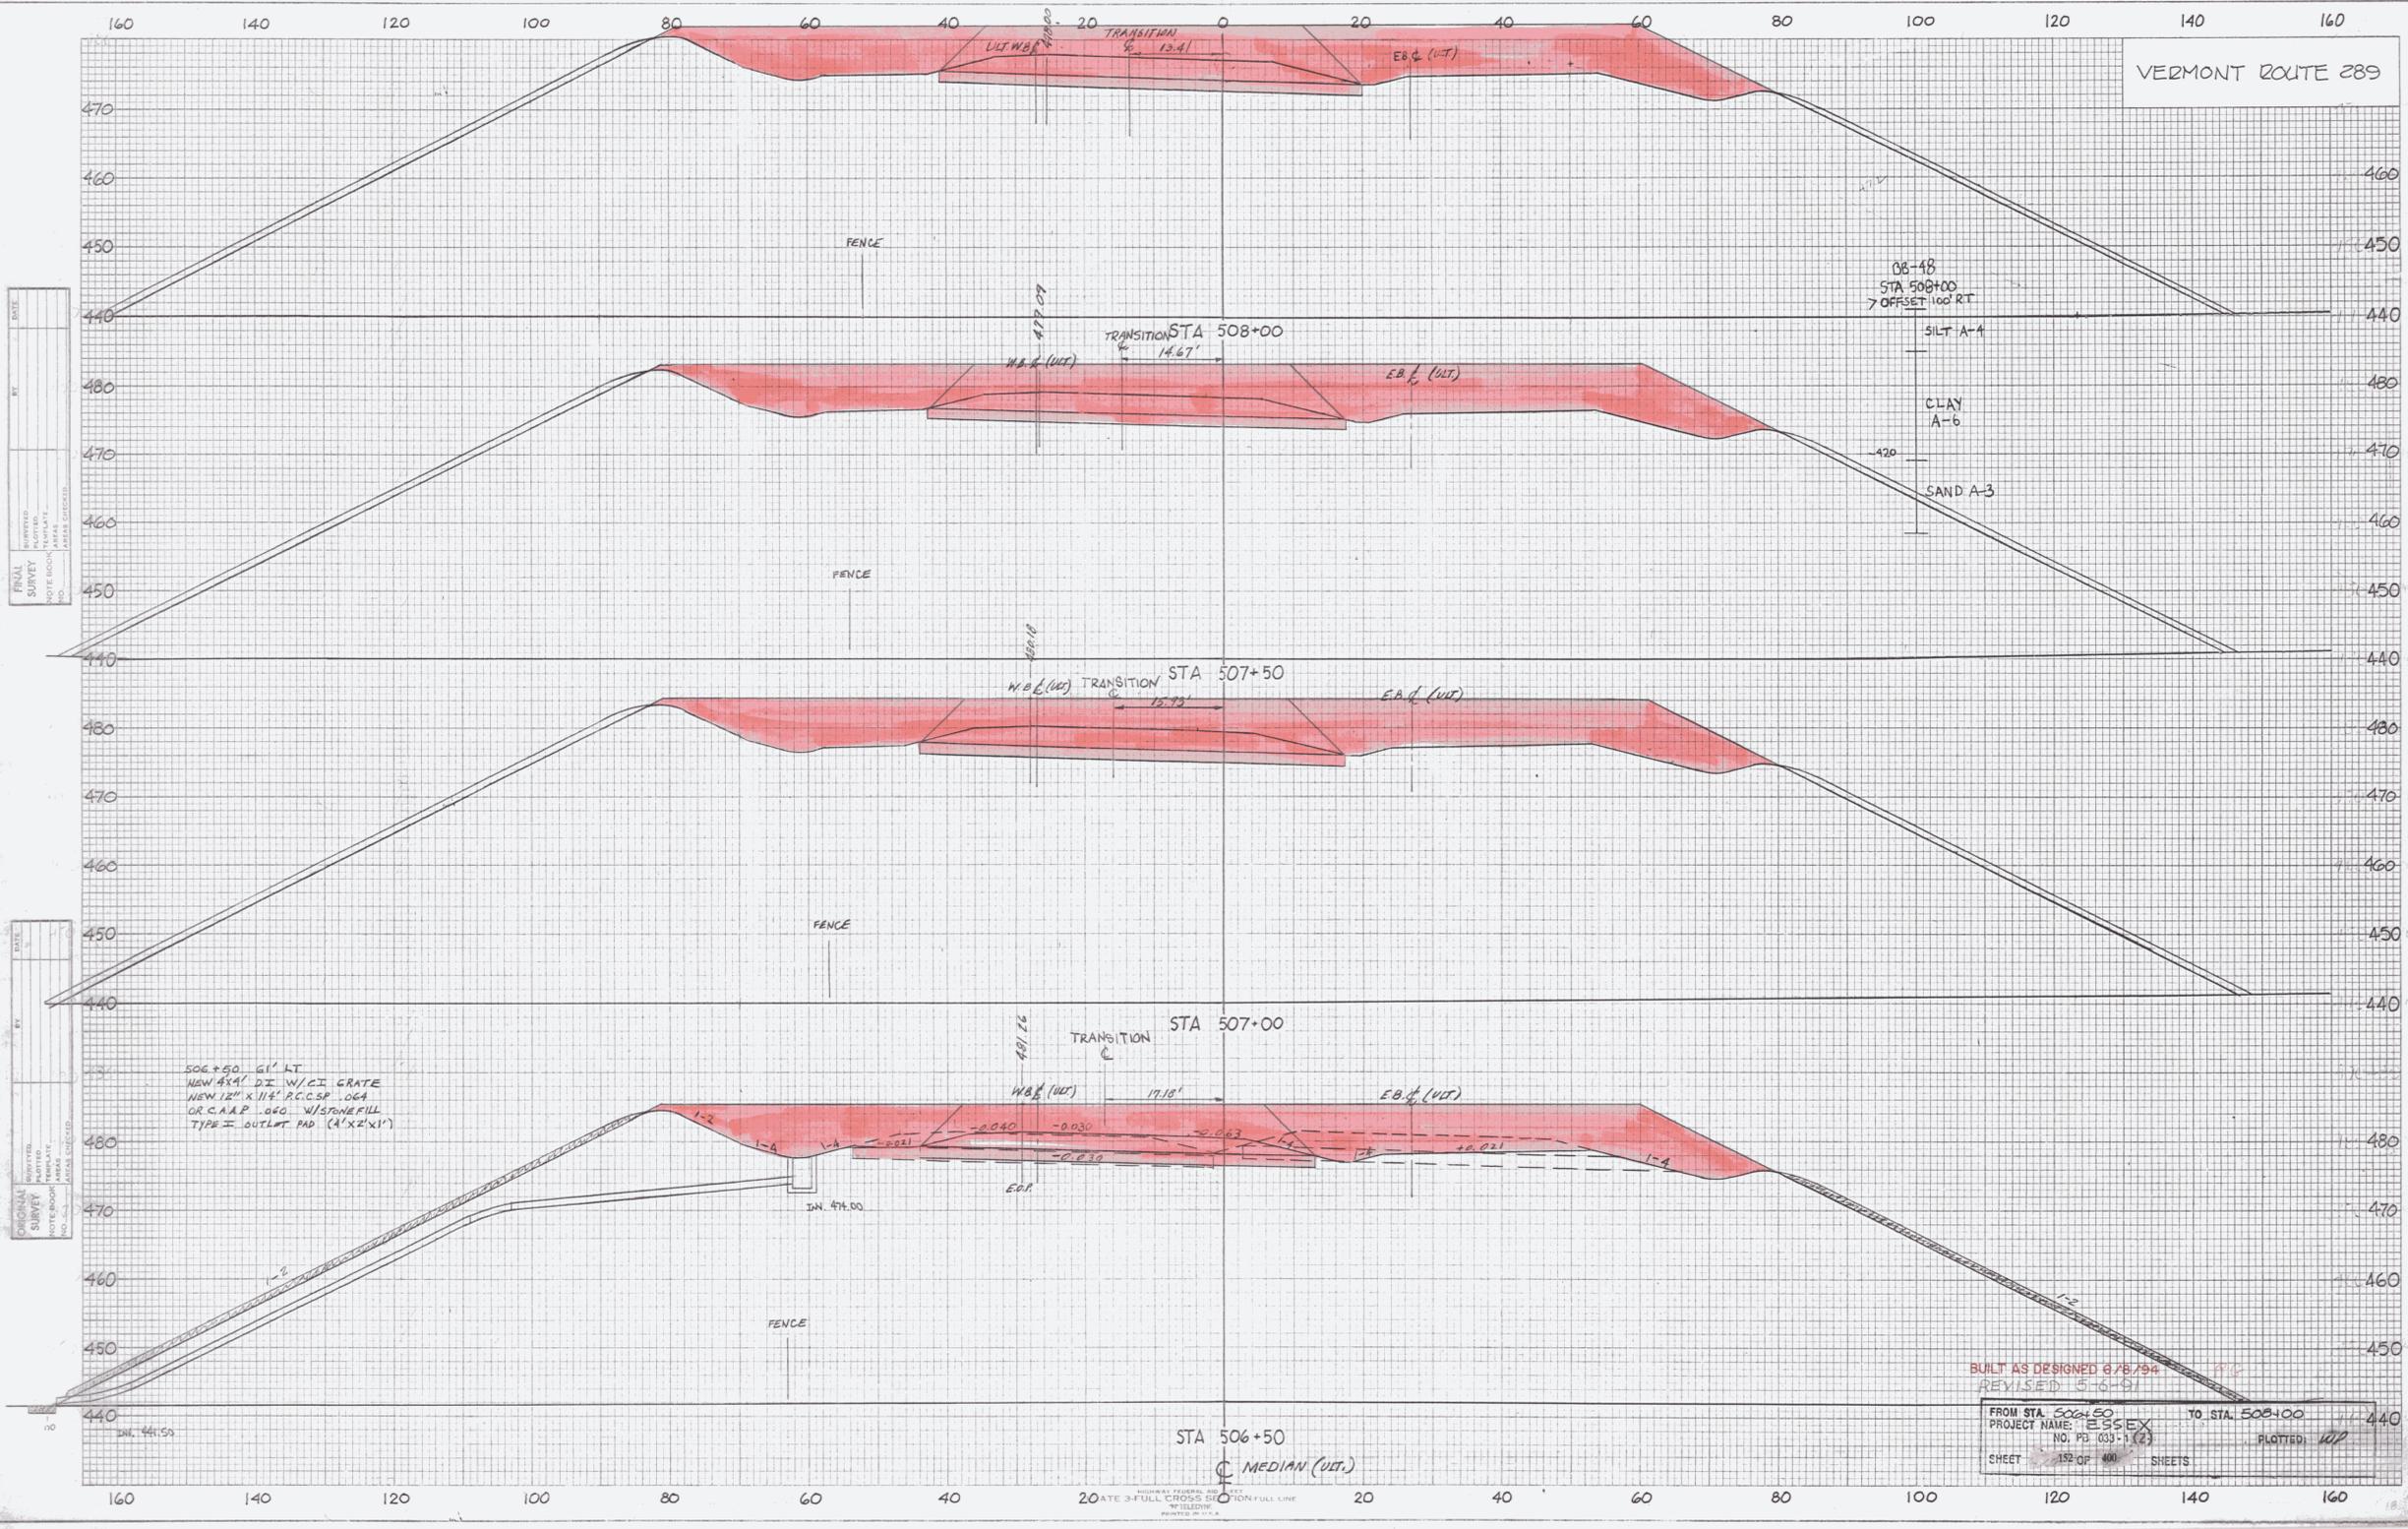

DATE: _____
 BY: _____
 REVISIONS:
 NO. DATE DESCRIPTION
 1. _____
 2. _____
 3. _____

DATE: _____
 BY: _____
 REVISIONS:
 NO. DATE DESCRIPTION
 1. _____
 2. _____
 3. _____

506+50 61' AT
 NEW 48" DI W/CI GRATE
 NEW 12" X 14" P.C.C.S.P. LOG
 OR C.A.P. LOG W/STONE FILL
 TYPE II OUTLET PAD (1' X 2' X 1')

BUILT AS DESIGNED 6/28/79
 REVISED 5/6/81

FROM STA. 506+50 TO STA. 508+00
 PROJECT NAME: ESSEX
 NO. PD. 033-1 (2)
 SHEET 152 OF 400 SHEETS
 PLOTTED: 1/77

STA 506+50
 MEDIAN (UIT.)

DATE 3-FULL CROSS SECTION FULL LINE
 11/15/81
 PRINTED IN U.S.A.