


VERMONT ROUTE 289

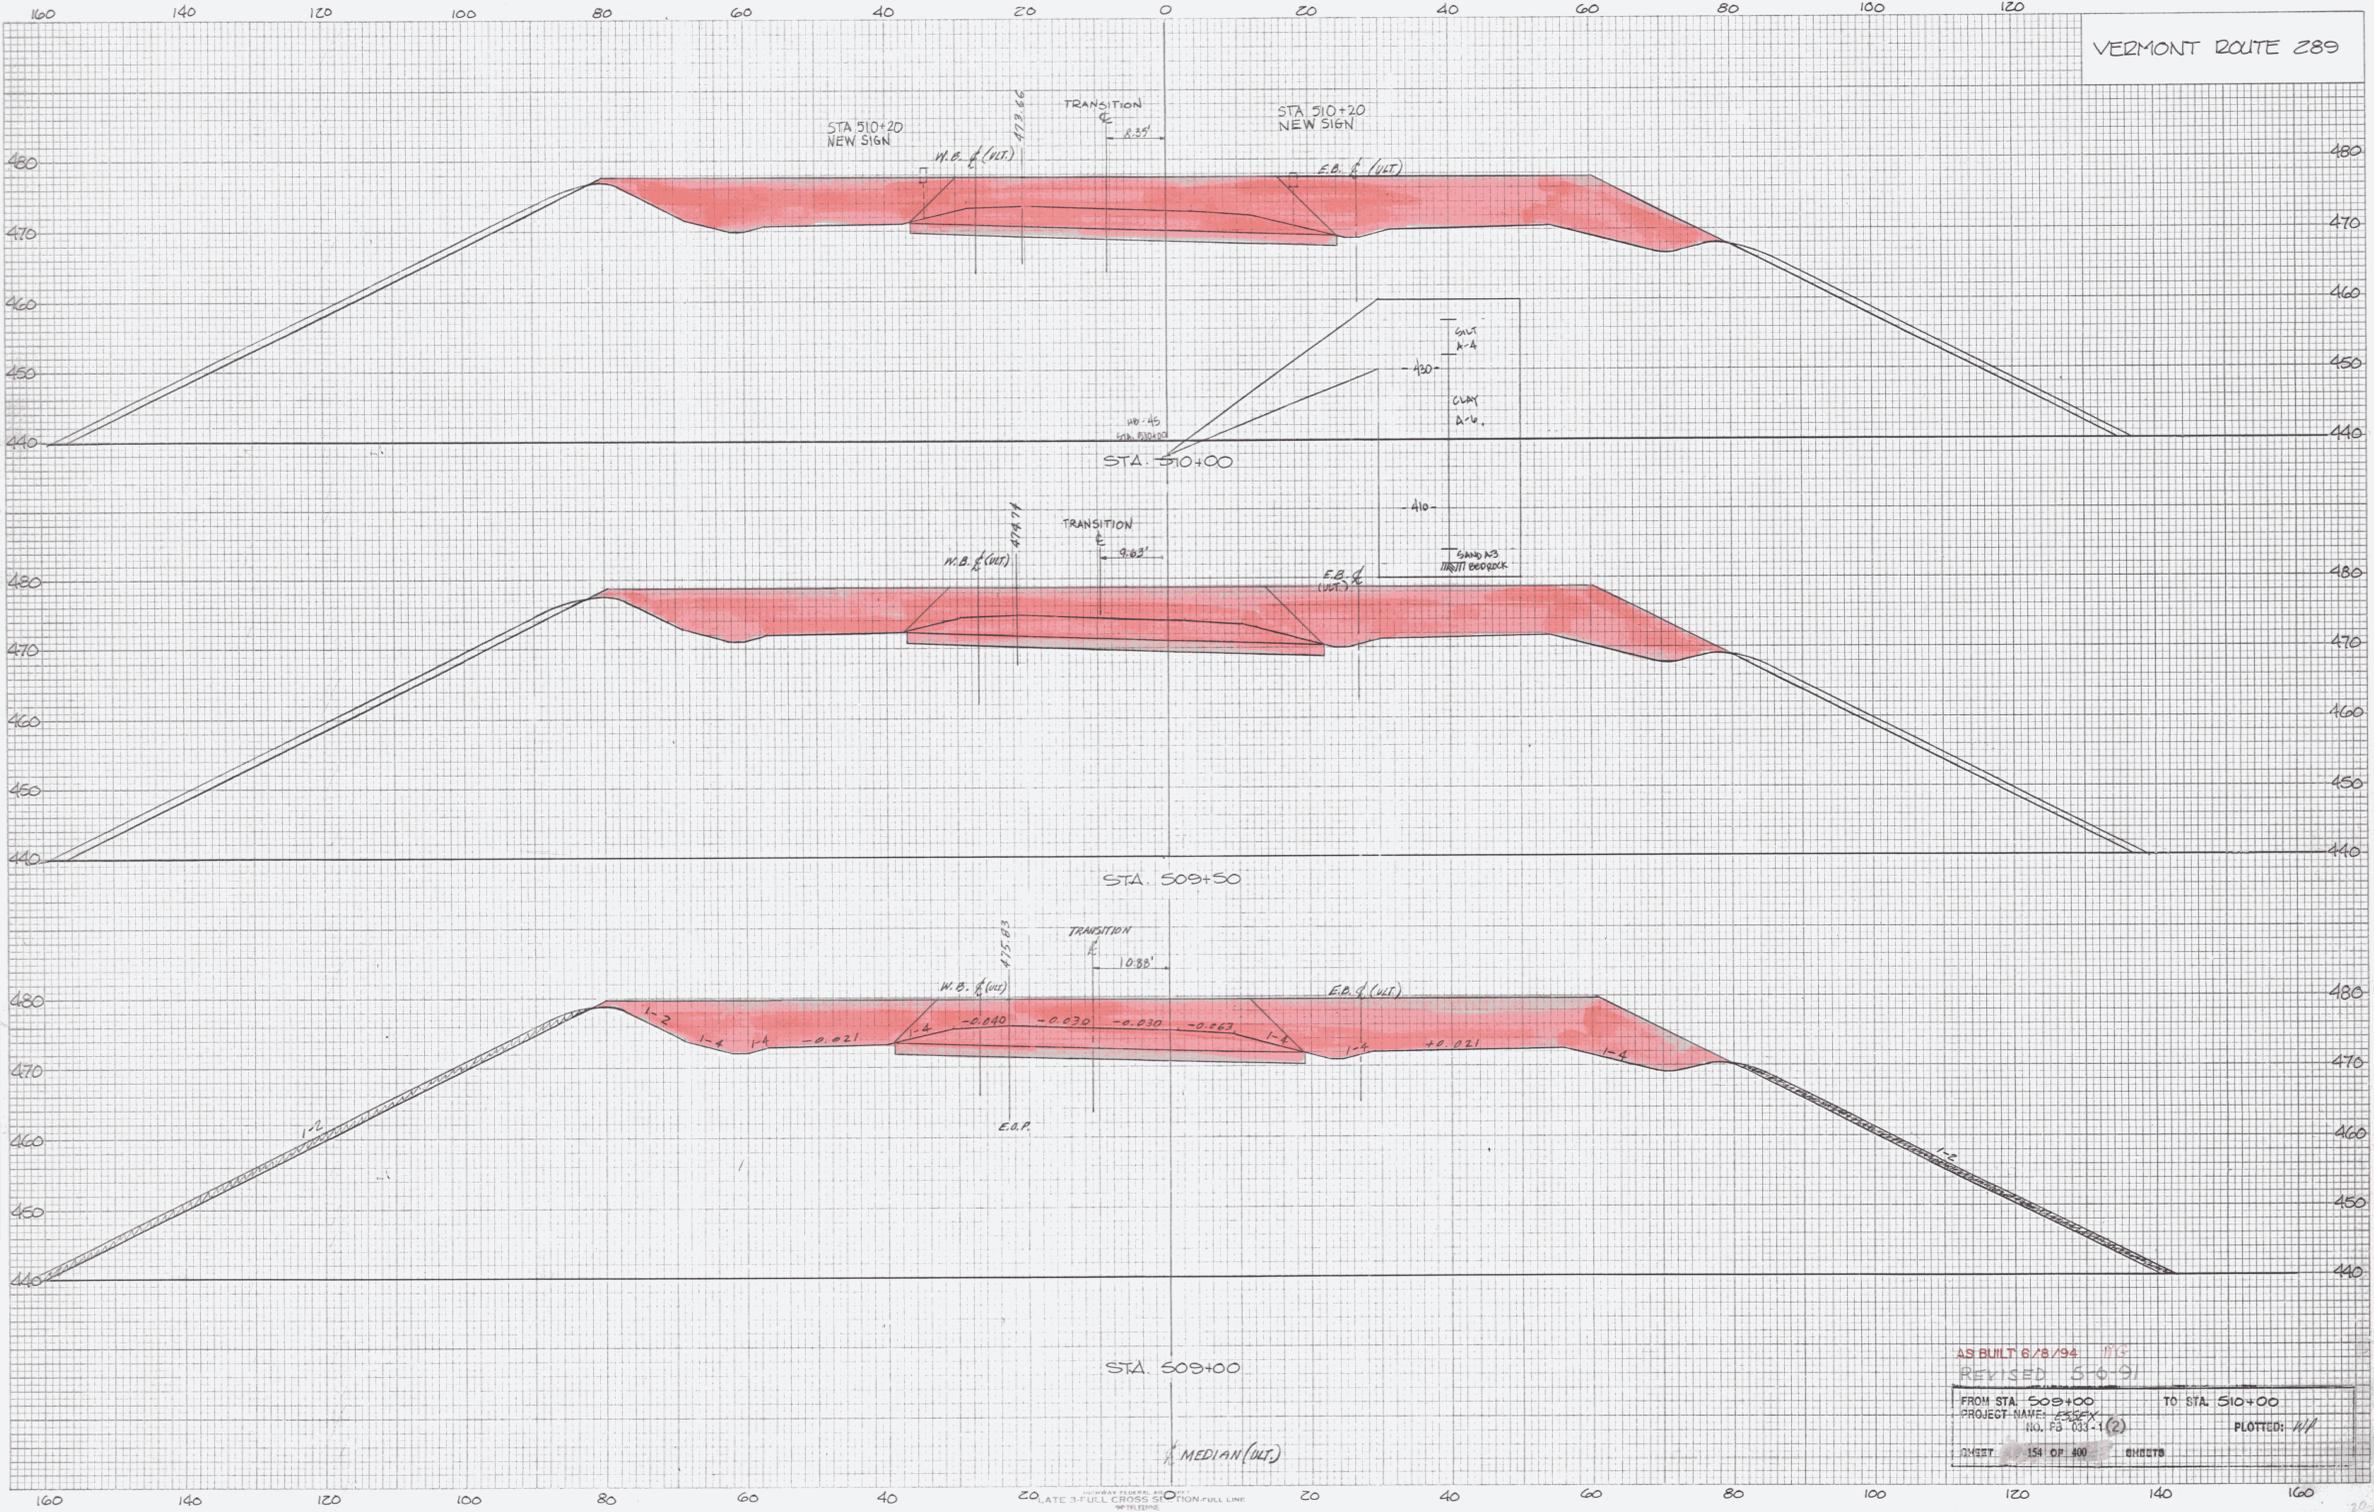

FINAL SURVEY NOTE BOOK NO. 4153.66

PROPOSED SURVEY NOTE BOOK NO. 4153.66

AS BUILT 6/28/94
 REVISED 5-0-91
 FROM STA. 508+00 TO STA. 510+00
 PROJECT NAME: 110. PS 101-1(2)
 SHEET 154 OF 200
 PLOTTED: H/H

DATE 3-FULL CROSS SECTION-FULL LINE