


VERMONT ROUTE 289

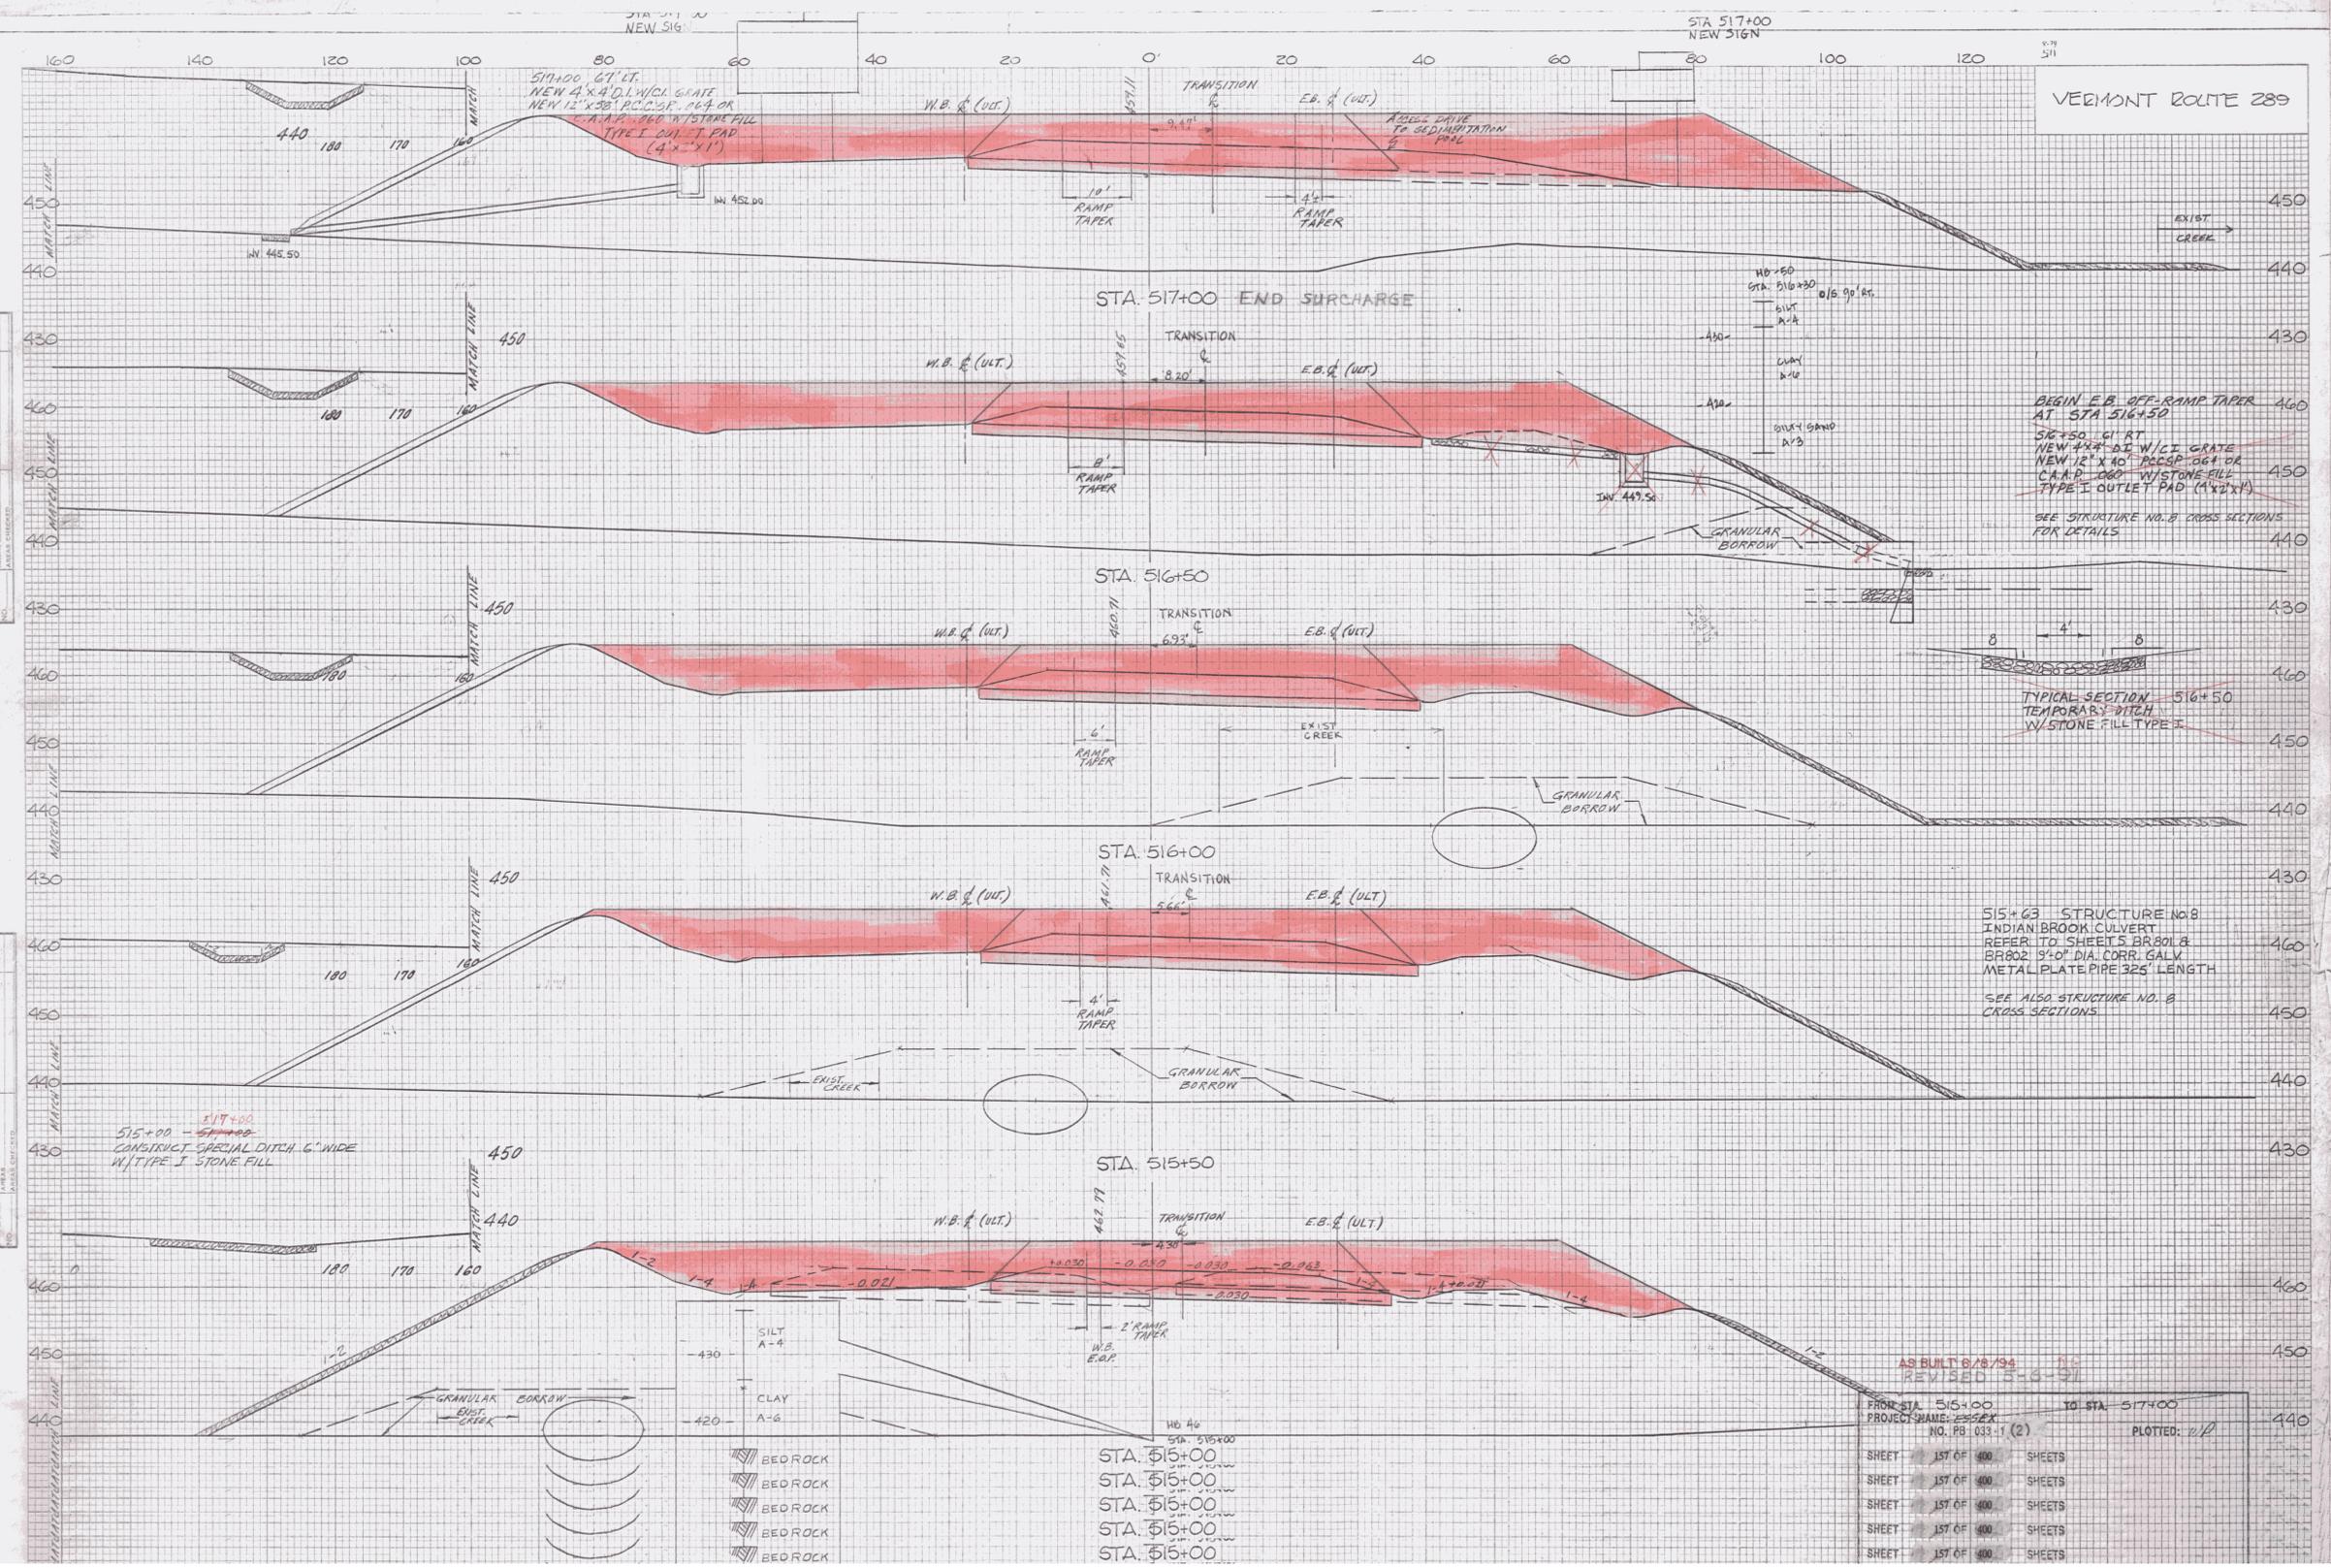

DATE: \_\_\_\_\_  
 BY: \_\_\_\_\_  
 CHECKED: \_\_\_\_\_  
 ORIGINAL SURVEY: \_\_\_\_\_  
 REVISIONS: \_\_\_\_\_  
 NO. OF BOOKS: \_\_\_\_\_  
 AREA CHECKED: \_\_\_\_\_

DATE: \_\_\_\_\_  
 BY: \_\_\_\_\_  
 CHECKED: \_\_\_\_\_  
 ORIGINAL SURVEY: \_\_\_\_\_  
 REVISIONS: \_\_\_\_\_  
 NO. OF BOOKS: \_\_\_\_\_  
 AREA CHECKED: \_\_\_\_\_

AS BUILT 8/8/94  
 REVISED 3-6-71

FROM STA. 515+00	TO STA. 517+00
PROJECT NAME: ESSEX	
NO. PB. 033-1 (2)	PLOTTED: 1/1
SHEET 1ST OF 400	SHEETS

CR 10/22/94