
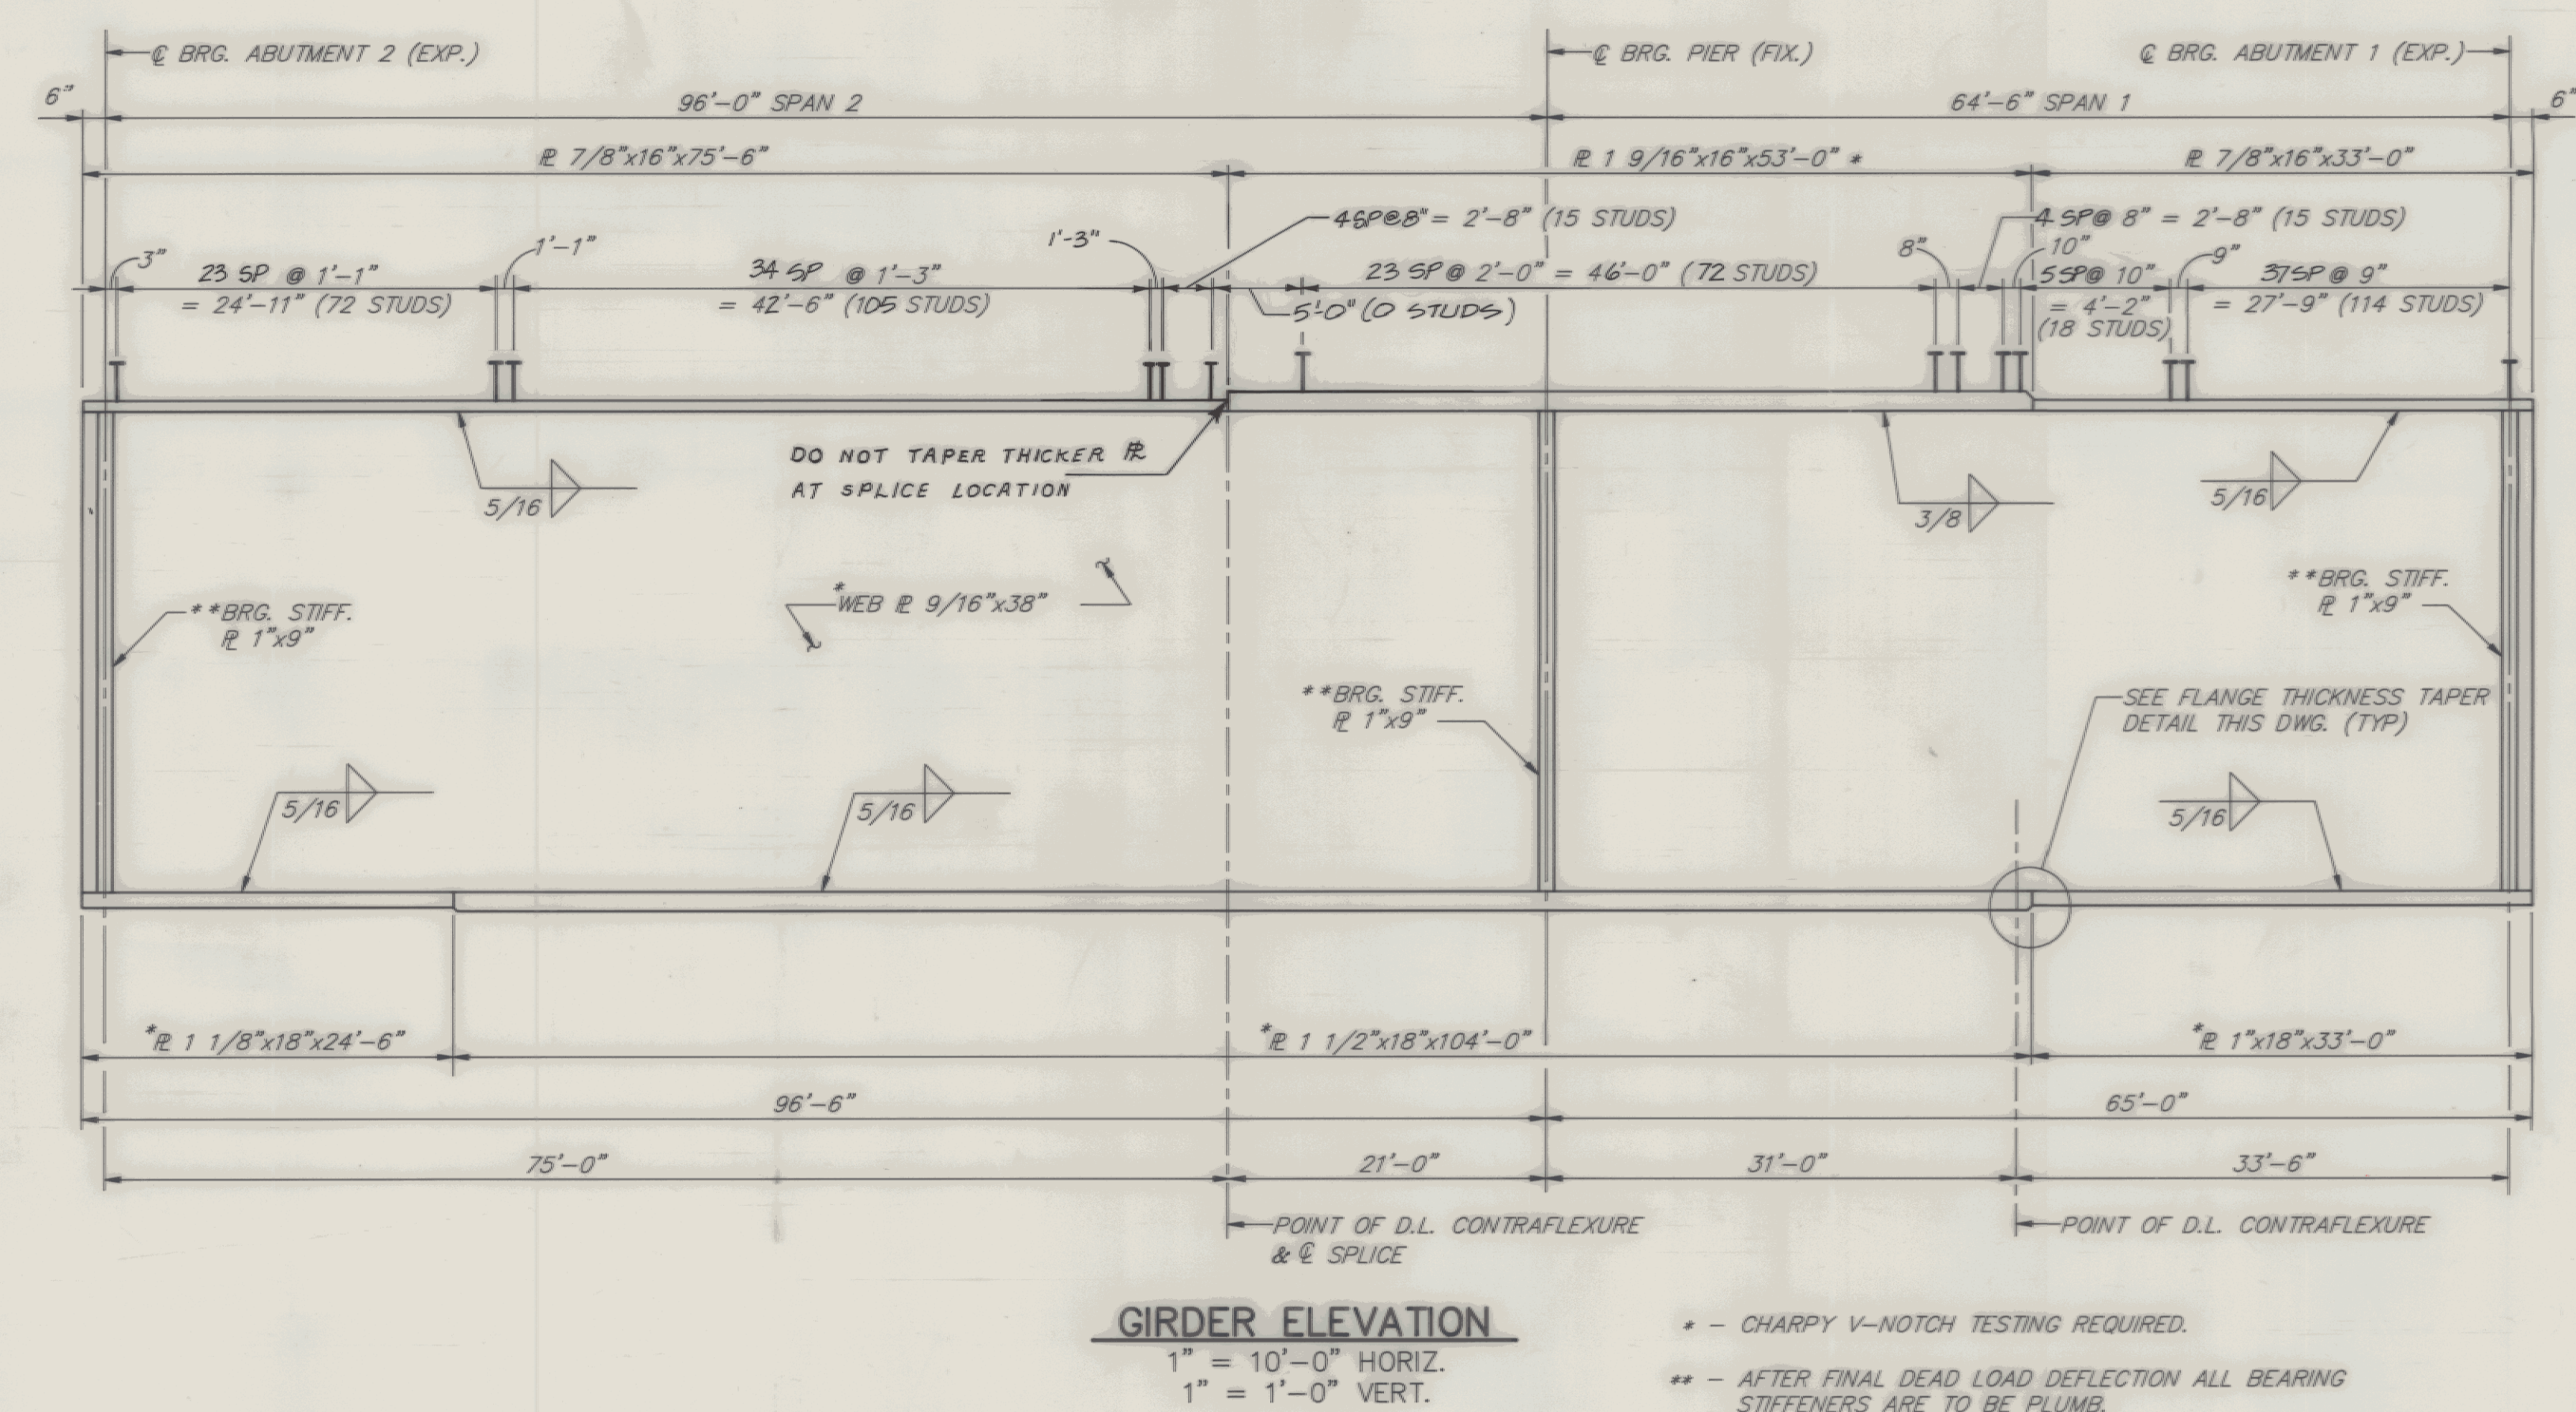
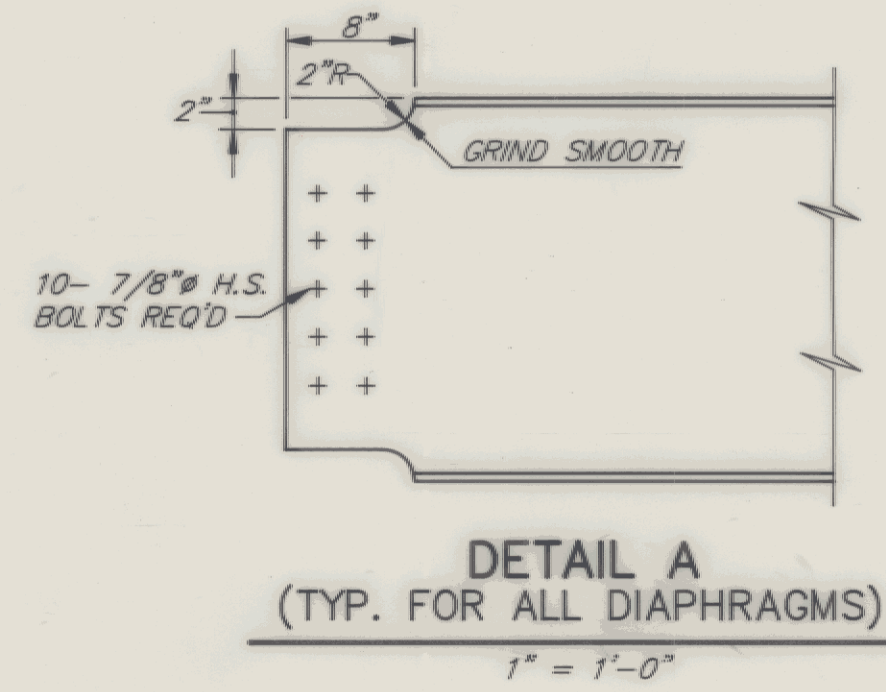
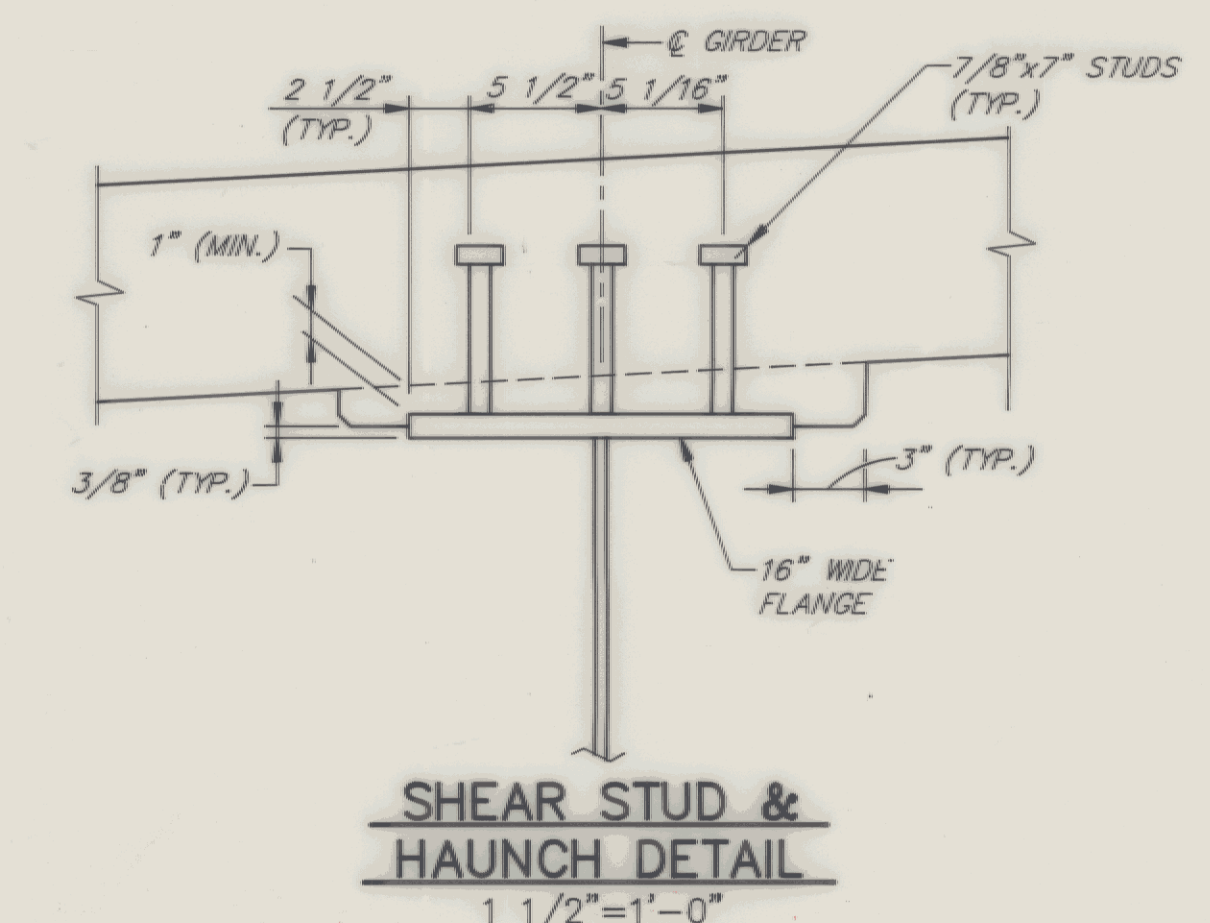


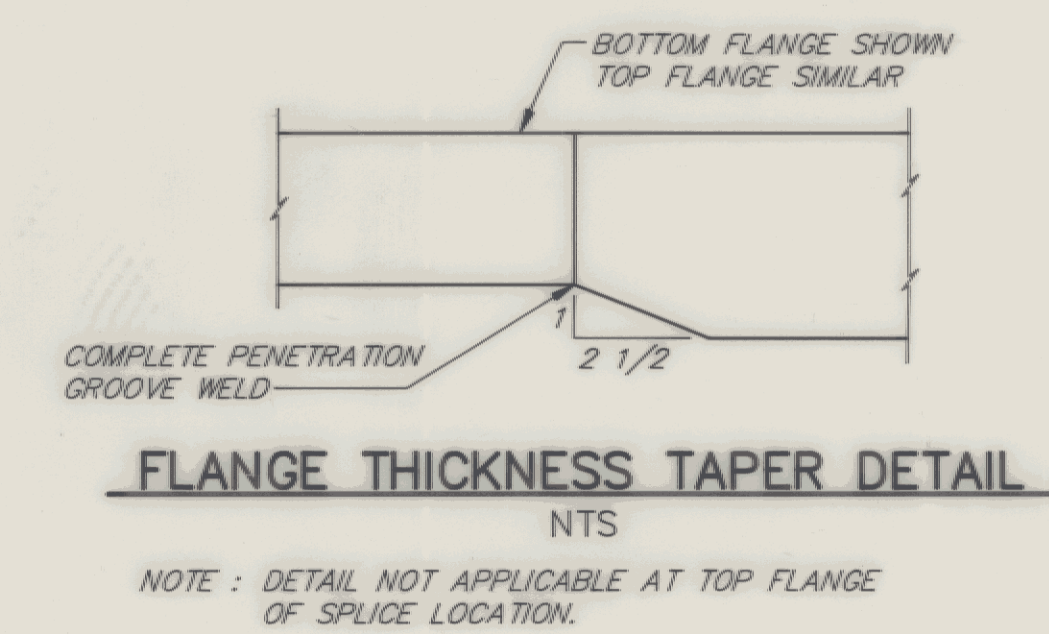

BUILT AS DESIGNED 5/12/94 <i>to</i>			
STATE OF VERMONT AGENCY OF TRANSPORTATION			
TOWN OF ESSEX		Bridge No. 13 Log Sta.	
HIGHWAY NO. VT. RTE. 289		Surv. Sta. RAMP 15+00	
VT. RT. 289 "RAMP D" OVER CVRR			
FRAMING PLAN & GIRDER ELEVATION			
Designed by GSB / PJB		Drawn by RFU / DJA / M.W.D.	
Checked by RJS date 10/12/90		Bridge Design Supervisor MWO date 10/12/90	
PROJECT WILLISTON -- COLCHESTER		PROJECT NO. PB 033-1(2)	
Bridge Sheet No. BR307		Sheet 172 of 400	