



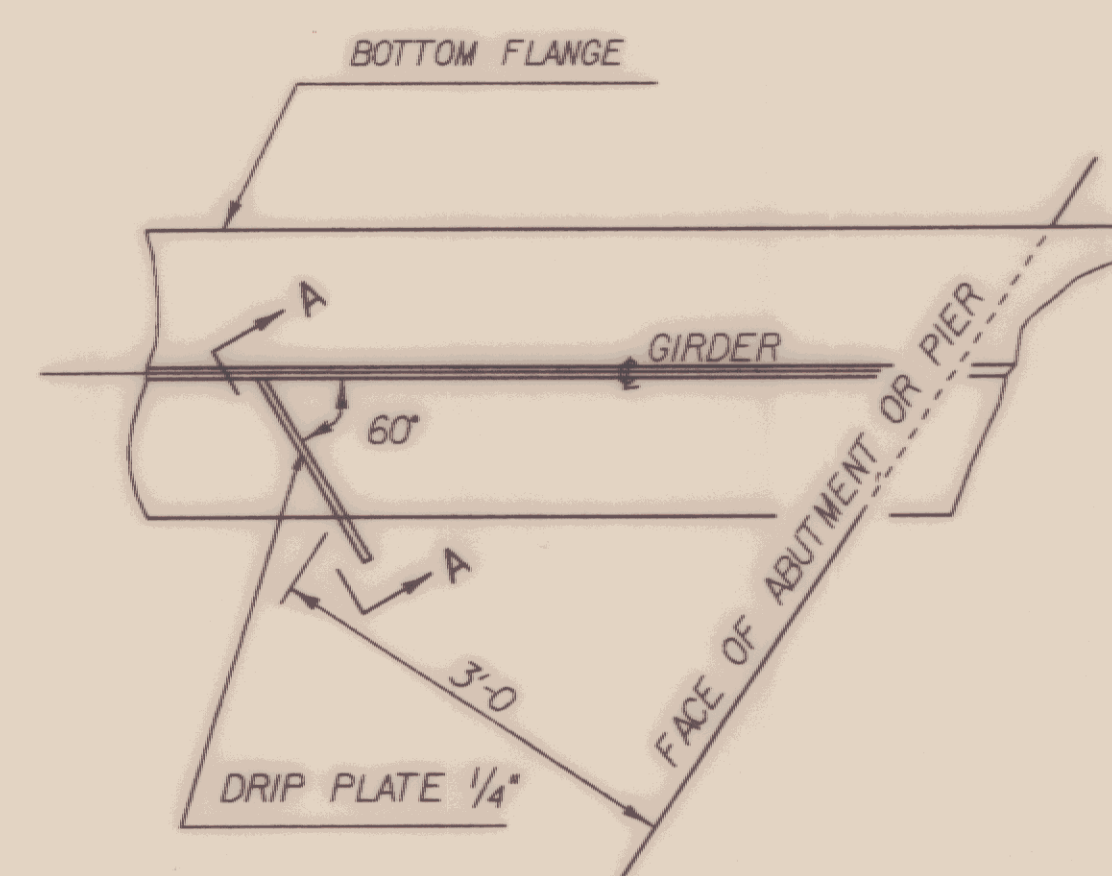


PLAN DRIP PLATE

NOTE: DRIP PLATES SHALL BE PLACED ON OUTSIDE EDGE OF FASCIA GIRDERS, ON THE HIGH SIDE OF ALL PIERS AND ABUTMENTS, OR AS INDICATED ON PROJECT PLANS.

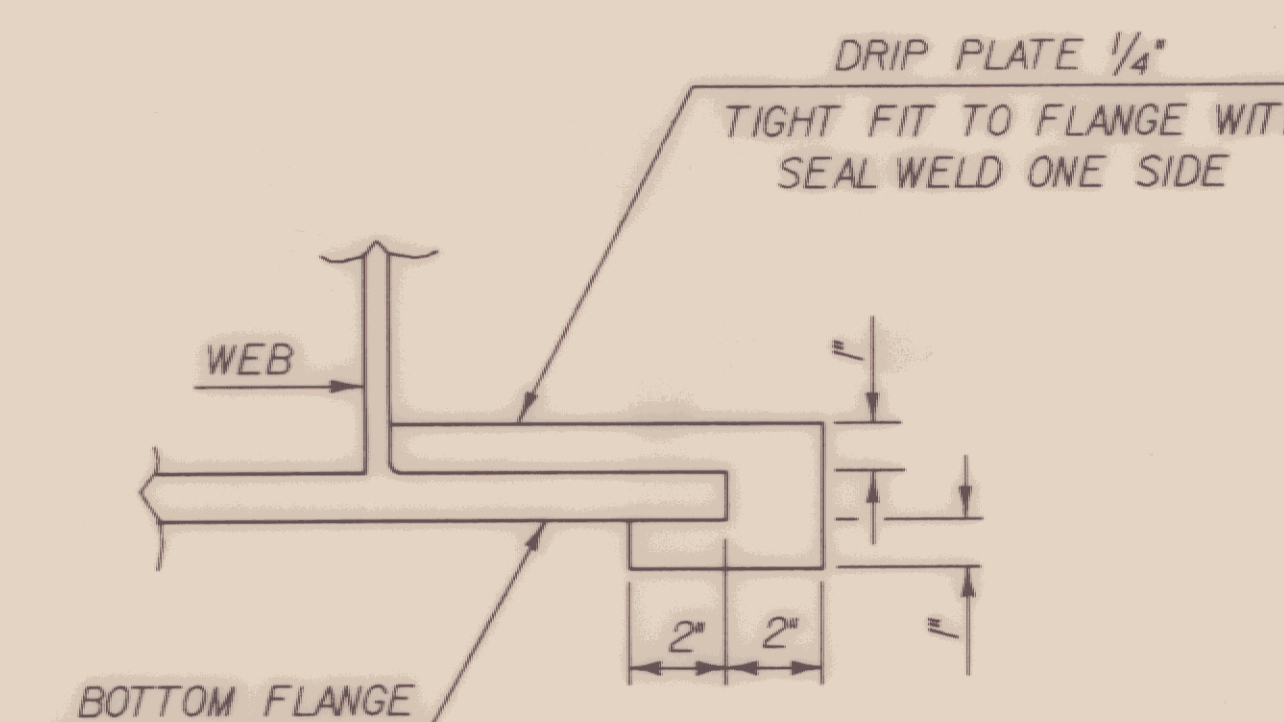


SECTION A - A

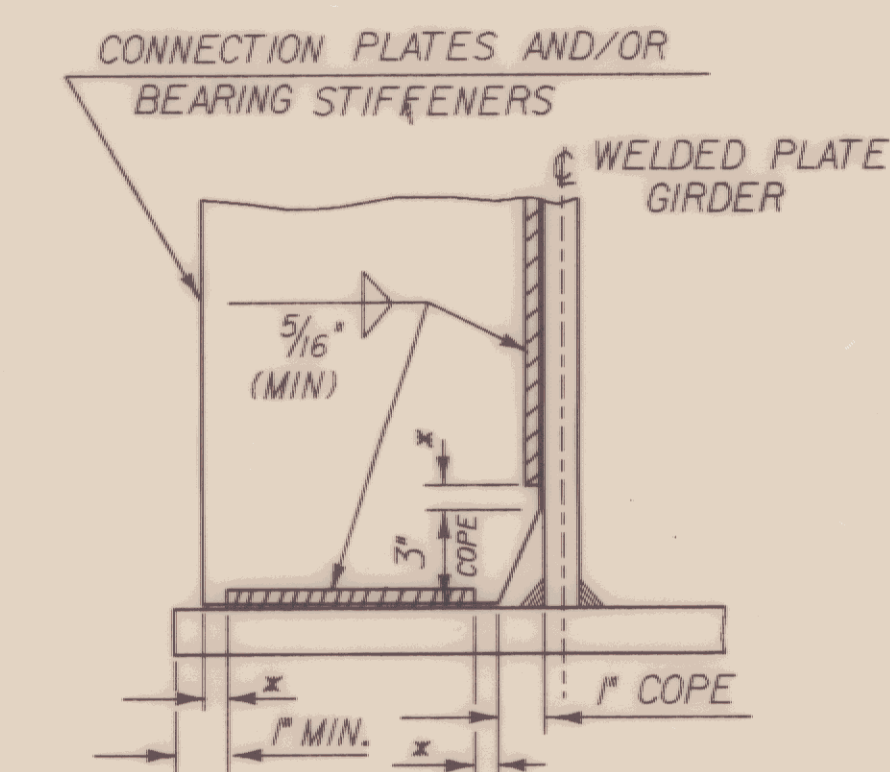


WELD TERMINATION DETAIL AND COPING DETAIL FOR WELDED PLATE GIRDERS

* NO WELD FOR 1/4" MIN., 1/2" MAX. (EXCEPT MUST MAINTAIN 1" MINIMUM FROM EDGE OF FLANGE)

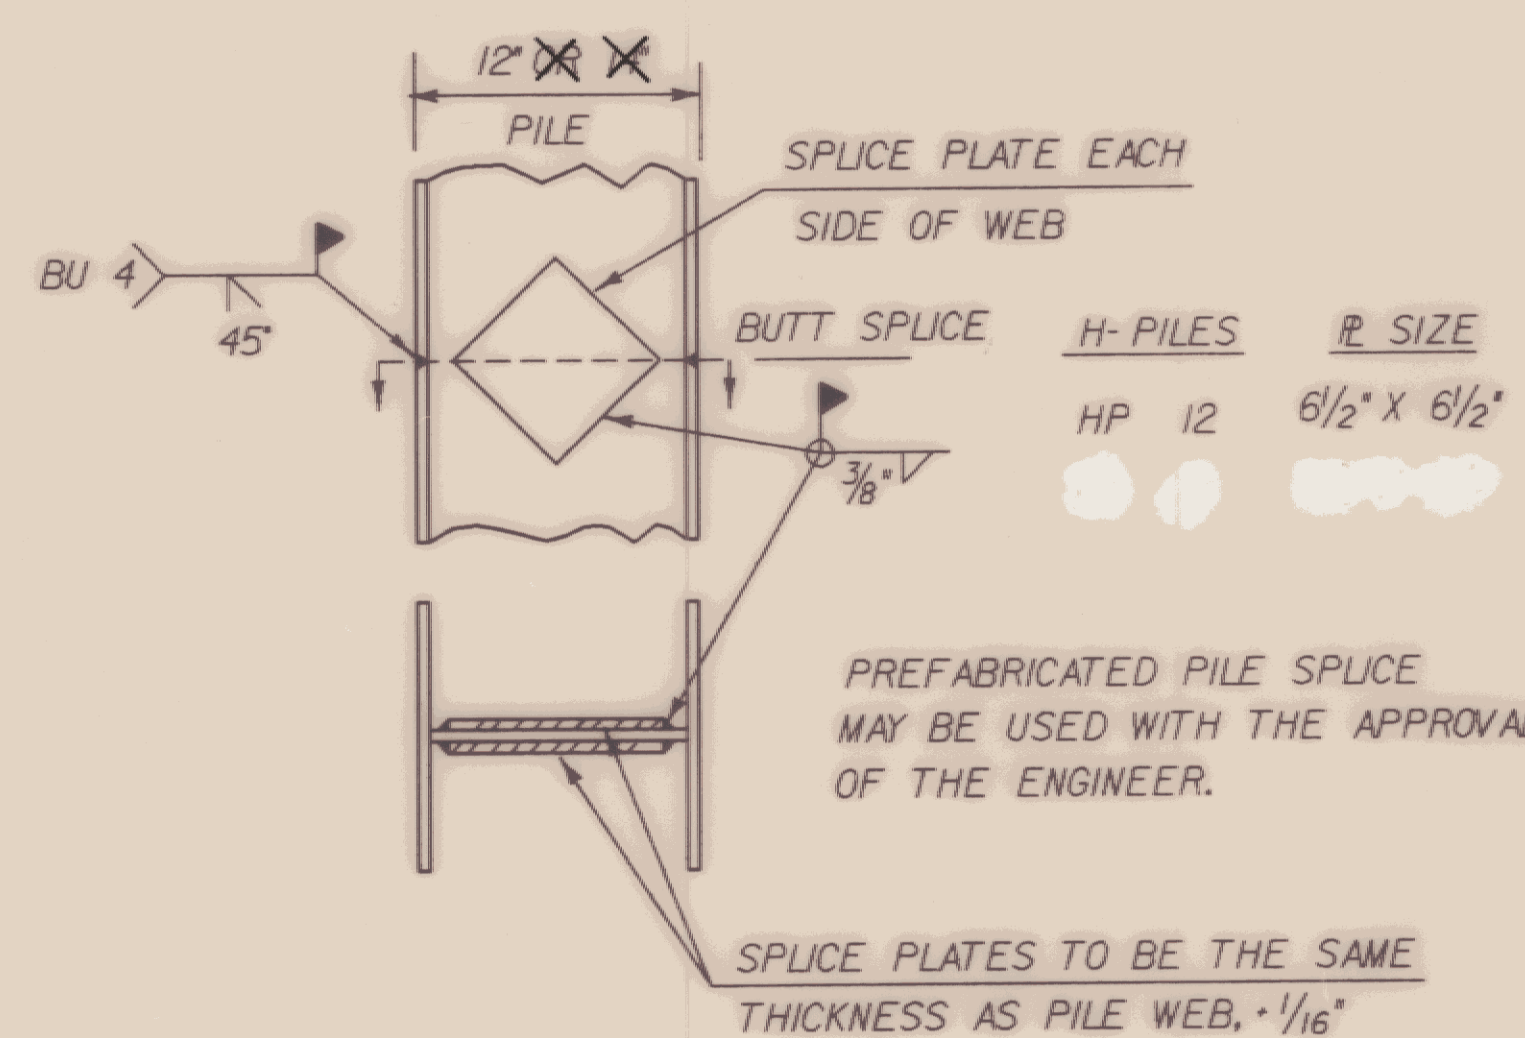

DETAIL OF PILE SPLICE

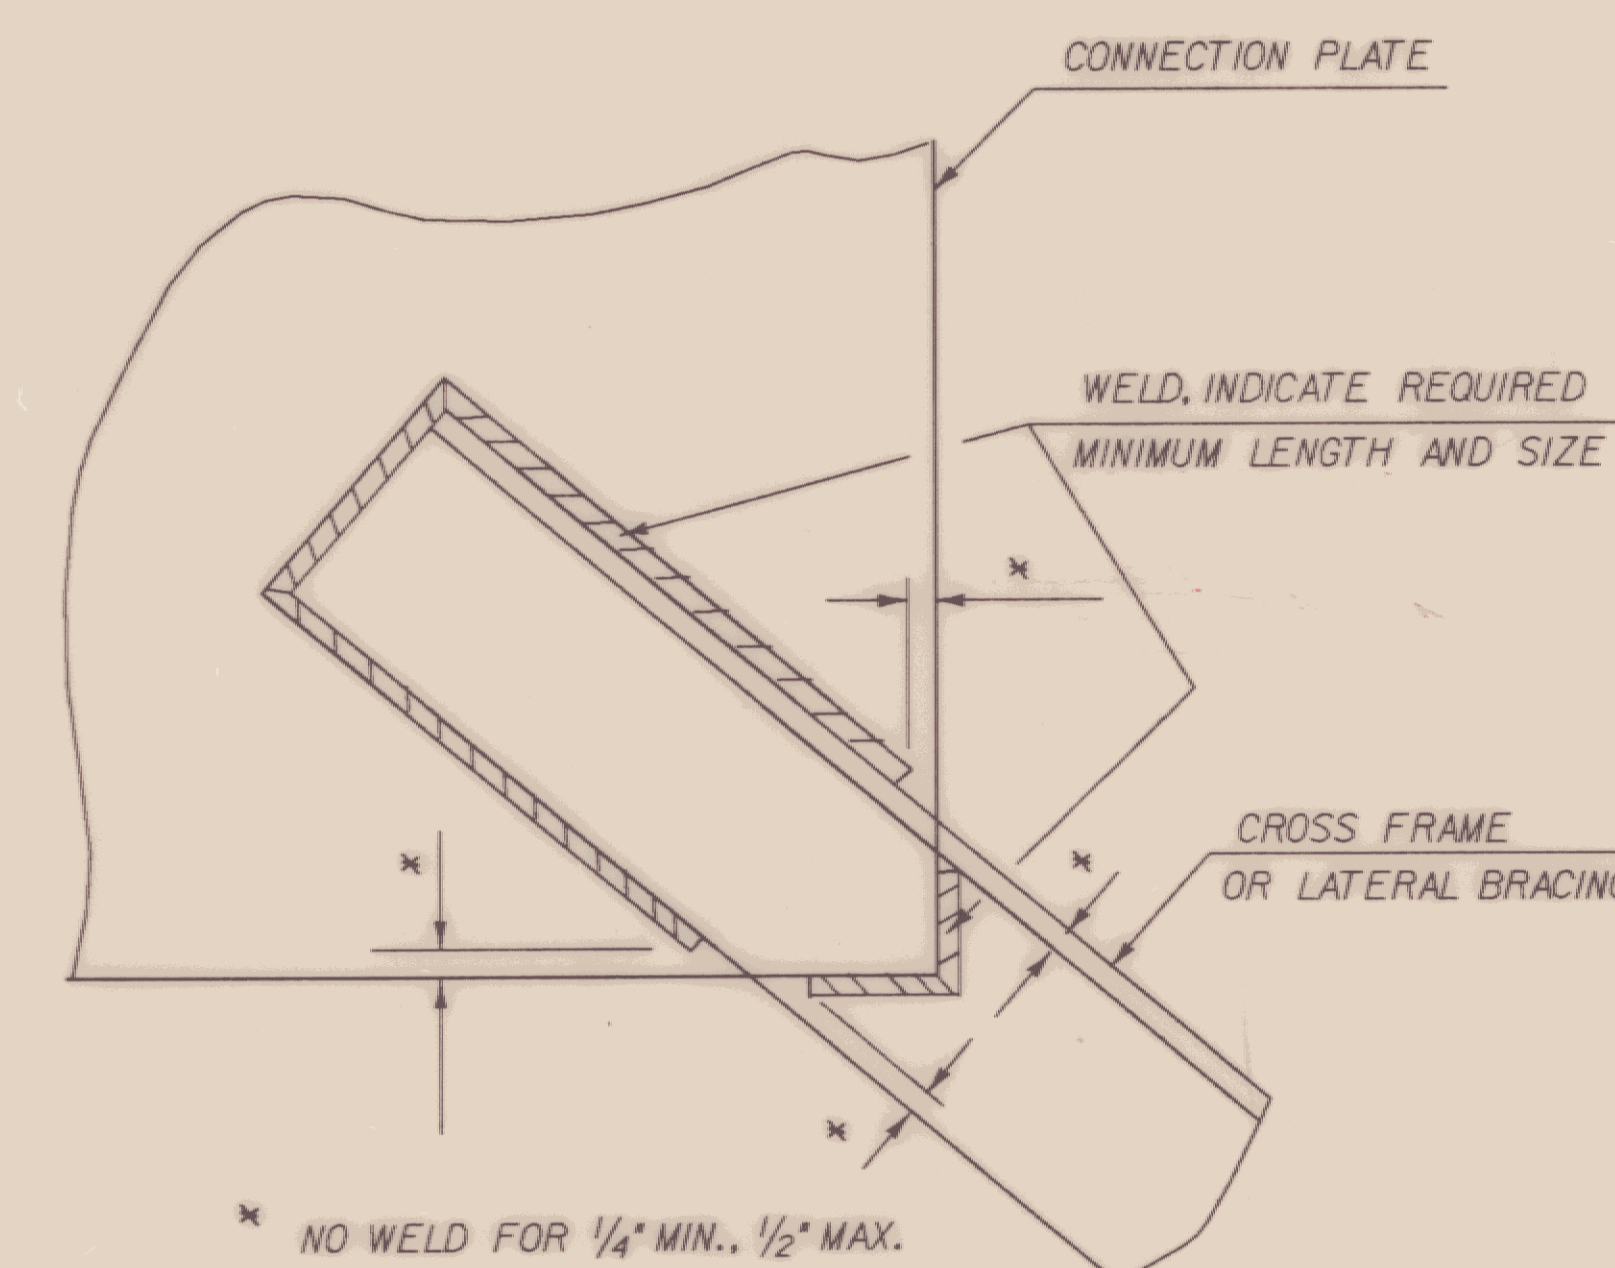

DETAILS OF WELD LOCATION AT CROSS FRAMES AND LATERAL BRACING

SEE ALSO HI-STEEL FABRICATION DRAWINGS

BUILT AS DESIGNED 5/12/94

**STATE OF VERMONT
AGENCY OF TRANSPORTATION**

Town Of	Essex	Bridge No.	13
Highway No.	Vt. RTE. 289	Log Sta.	
		Surv. Sta.	RAMP 15+00
Vt. RTE. 289 "RAMP D" OVER CVRR			
STRUCTURAL STEEL DETAILS			
Designed By		Drawn By	
Checked By	RJS	Bridge Design Supervisor	MWO
Date	10-12-90	Date	10-12-90
PROJECT	Williston - Colchester	PROJECT NO.	PB 033-1 (2)
I.G.C. Info.	ZFAH30.327B3E069DET.DGN	PRF:STRSTLDET	
Bridge Sheet No.	BR311	Sheet	176 of 400