

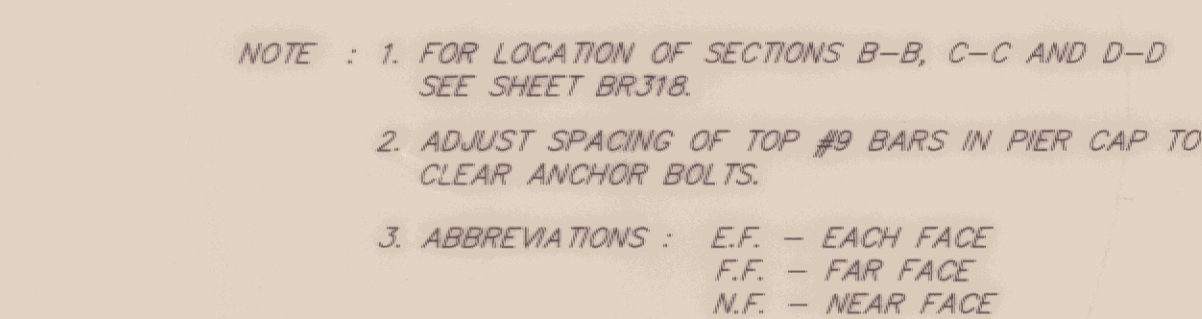
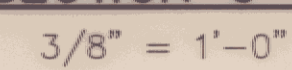
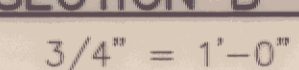


NOTES :

1.  - INDICATES LOCATION AND DIRECTION OF 1 ON 6 BATTERED PILES.
2. APPROXIMATE LENGTH OF THE PILES IS 35'
3. ALL PILES SHALL BE DRIVEN TO REFUSAL. PILES DESIGN LOAD IS 70 TONS.
4. ALL PILES TO BE HP12x74, ITEM 505.16.

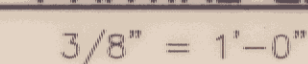

SEE WRITTEN ORDER 102
FOR REINF. STEEL CHANGES

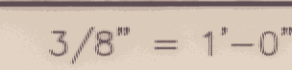

AS BUILT 5/12/94 *SL*

STATE OF VERMONT
AGENCY OF TRANSPORTATION

TOWN OF	ESSEX	Bridge No. 13
HIGHWAY NO.	VT. RTE. 289	Log Sta.
VTE. RTE. 289 "RAMP D" OVER CVRR		Surv. Sta. RAMP 15+00
PIER DETAILS		
Designed by	KRH	Drawn by
Checked by	RJS date 10/12/90	Bridge Design Supervisor
PROJECT		MWO date 10/12/90
WILLISTON - COLCHESTER		PROJECT NO.
Bridge Sheet No.	BR319	Sheet
		184 of 400