



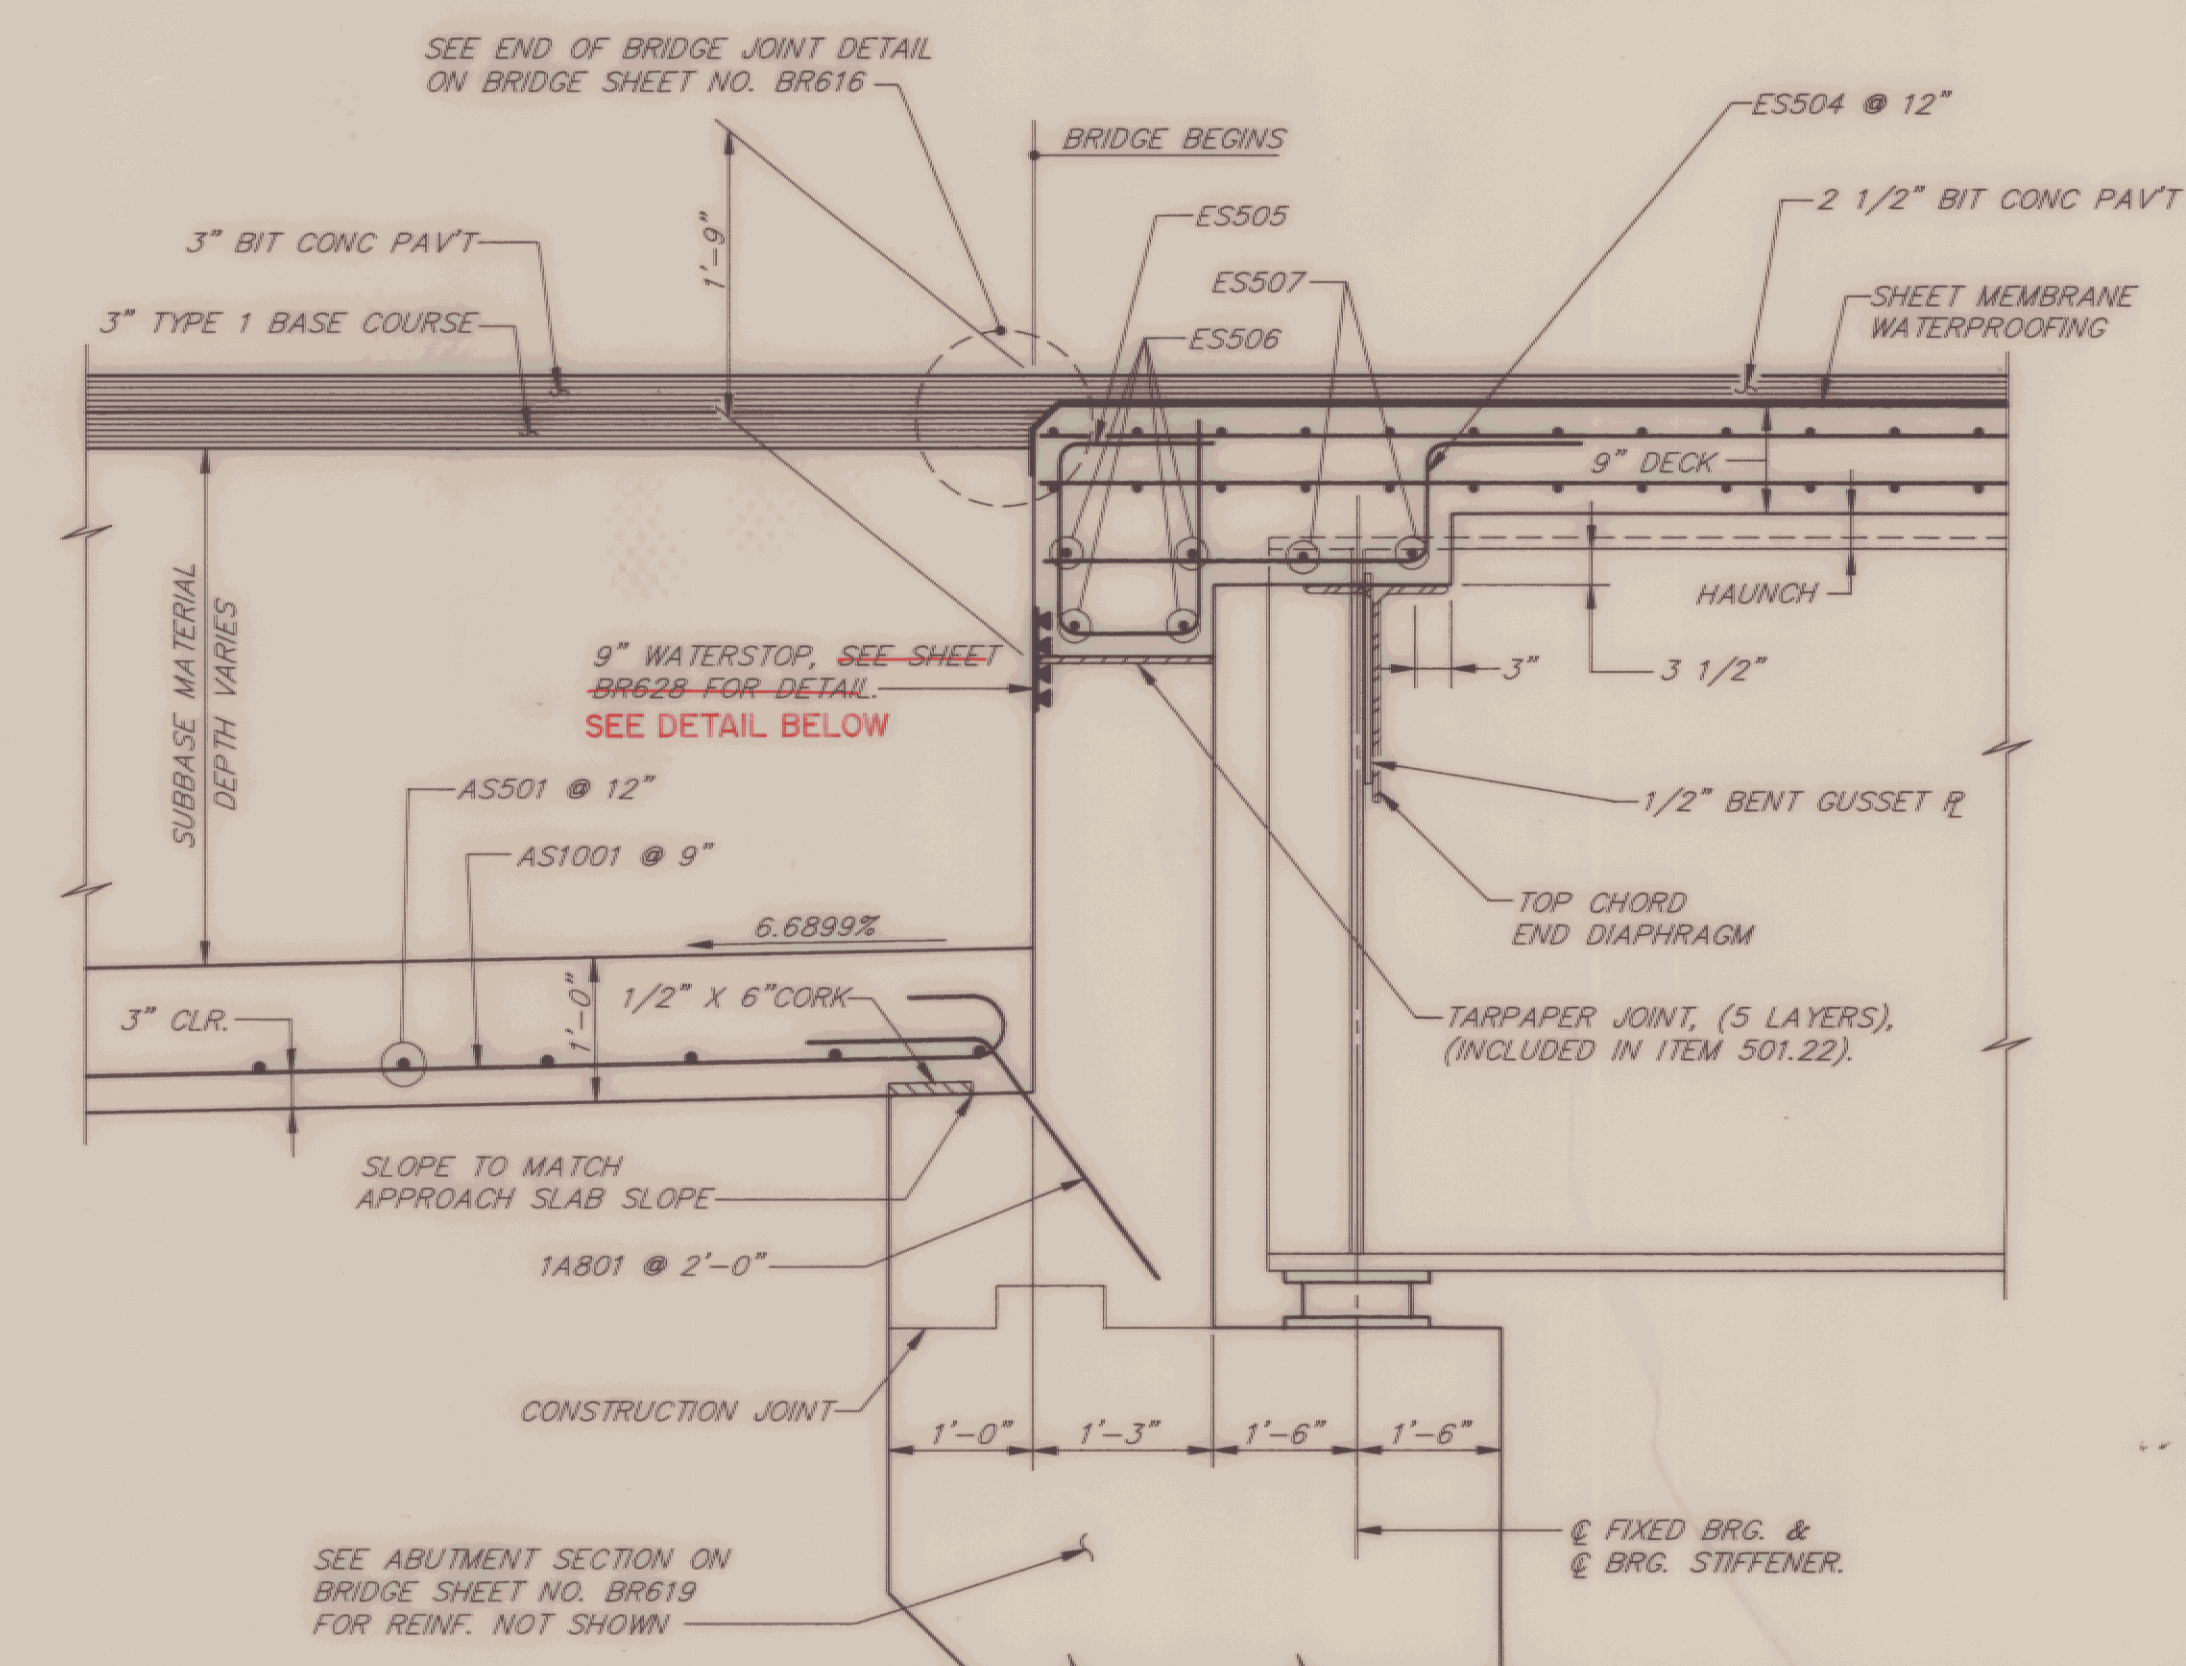

NOTE : SEE DWG. BR610 FOR APPROACH
SLAB PLAN AND SECTION.

(SEE DWG. BR612, 613 & 614 FOR ABUTMENT #2 END OF BRIDGE DETAIL.

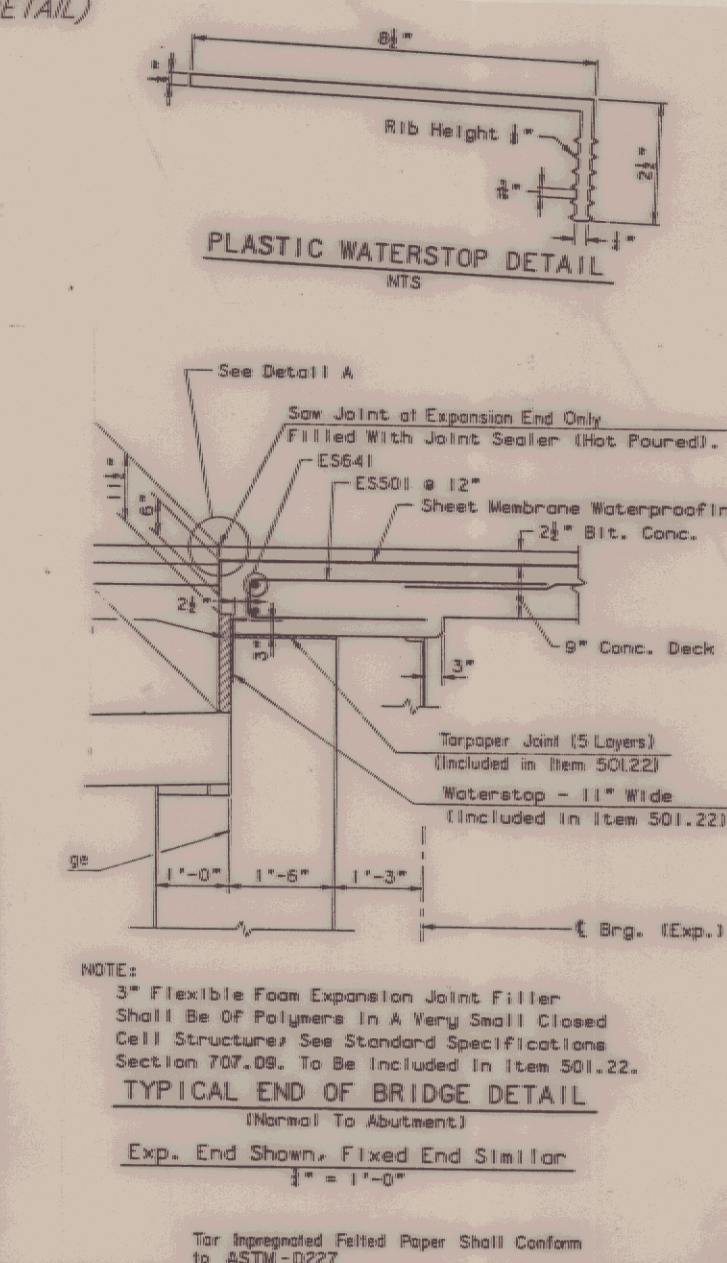

AS BUILT 5/12/94

TOWN OF	ESSEX	Bridge No.	14
HIGHWAY NO.	VT. RTE. 289	Log Sta.	
		Surv. Sta.	RAMP 15+00
VT. RTE. 289 "RAMP A" OVER CVRR			
TRANSVERSE SECTION & DECK SLAB PLAN			
Designed by	KRH/KLB	Drawn by	DJA / M.W.D.
Checked by	RJS	Bridge Design Supervisor	
	date 10/12/90	MWO	date 10/12/90
PROJECT		PROJECT NO.	
WILLISTON — COLCHESTER		PB 033 — 1(2)	
Bridge Sheet No.	RR606	Sheet	195 of 400