


CAMBER DIAGRAM

N.T.S.

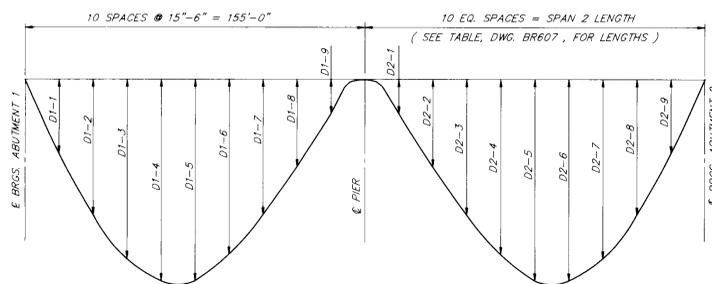


DEAD LOAD DEFLECTION DIAGRAM

N.T.S.

NOTE: DEAD LOAD DEFLECTION AS SHOWN INCLUDES STEEL, DECK CONCRETE, RAILING, AND PAVEMENT.


CAMBER TABLE																			
GIRDER	C1-1	C1-2	C1-3	C1-4	C1-5	C1-6	C1-7	C1-8	C1-9	C1-10	C2-1	C2-2	C2-3	C2-4	C2-5	C2-6	C2-7	C2-8	C2-9
G1	3 1/16	5 9/16	7 1/4	8 1/8	8 1/8	7 3/8	6 1/16	4 9/16	3 5/16	2 7/16	3 5/8	5 3/16	7 1/16	8 3/4	9 15/16	10-3/8	9 5/8	7 3/8	3 15/16
G2	2 7/8	5 1/4	6 13/16	7 9/16	7 1/2	6 11/16	5 3/8	4	2 13/16	2 1/16	3 7/16	5 1/4	7 3/8	9 3/8	10 11/16	11 3/16	10 3/8	7 15/16	4 1/4
G3	2 11/16	4 7/8	6 5/16	6 15/16	6 11/16	5 13/16	4 9/16	3 1/4	2 1/4	1 3/4	3 3/8	5 9/16	8	10 3/16	11 5/8	12 1/8	11 3/16	8 9/16	4 5/8
G4	2 7/16	4 7/16	5 5/8	6 1/8	5 13/16	4 15/16	3 11/16	2 9/16	1 3/4	1 7/16	3 5/16	5 13/16	8 1/2	10 13/16	12 1/4	12 9/16	11 9/16	8 3/4	4 3/4

DEAD LOAD DEFLECTION TABLE																		
GIRDER	D1-1	D1-2	D1-3	D1-4	D1-5	D1-6	D1-7	D1-8	D1-9	D2-1	D2-2	D2-3	D2-4	D2-5	D2-6	D2-7	D2-8	D2-9
G1	2 1/16	3 13/16	4 7/8	5 3/16	4 7/8	4	2 11/16	1 5/16	3/8	1/4	1	2 1/4	3 7/16	4 5/16	4 11/16	4 3/8	3 3/8	1 7/8
G2	2	3 9/16	4 9/16	4 13/16	4 7/16	3 1/2	2 1/4	1 1/16	1/4	7/16	1 1/2	3	4 1/2	5 9/16	5 15/16	5 1/2	4 1/4	2 3/8
G3	1 13/16	3 1/4	4 1/8	4 5/16	3 7/8	2 7/8	1 5/8	5/8	0	3/4	2 3/16	4	5 3/4	6 15/16	7 5/16	6 3/4	5 3/16	2 7/16
G4	1 5/16	2 7/16	3 9/16	3 5/8	3 1/8	2 1/8	1	3/16	-1/4	1	2 13/16	4 15/16	6 13/16	8	8 1/4	7 1/2	5 3/4	3 3/16

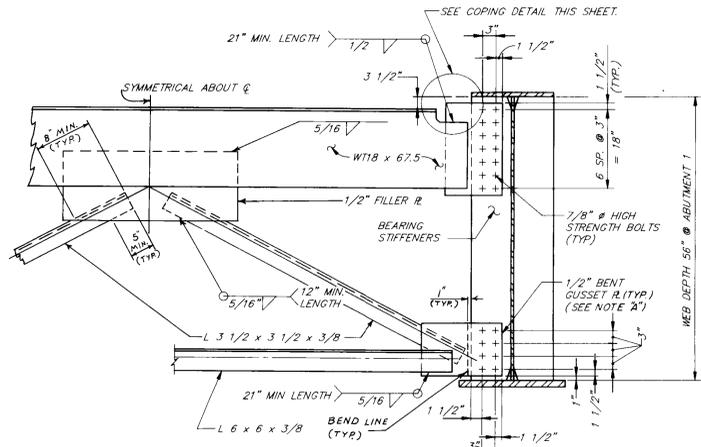

ABUTMENT 1 CROSSFRAME


N.T.S.

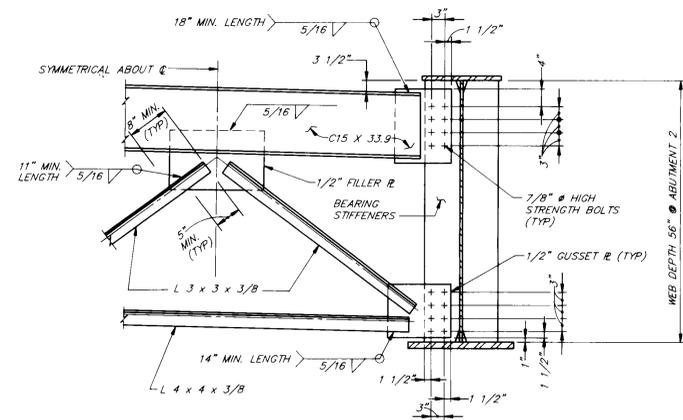

ABUTMENT 2 CROSSFRAME

N.T.S.


NOTE: ABUTMENT NO 2 CROSSFRAMES SHALL BE PAINTED DARK BROWN IN ACCORDANCE WITH SECTION 506 STRUCTURAL STEEL.

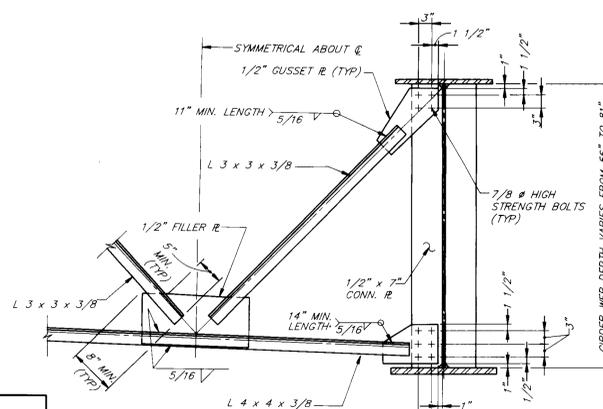

INTERMEDIATE CROSSFRAME

N.T.S.


NOTE: INTERMEDIATE CROSSFRAMES IN THE VICINITY OF THE PIER AND GIRDER HAUNCH WILL HAVE A VARIABLE HEIGHT DUE TO THE CROSSING OF THE HAUNCHES ON THE SKEW. ALL CONNECTING BOLTS AND WELDS REMAIN THE SAME.

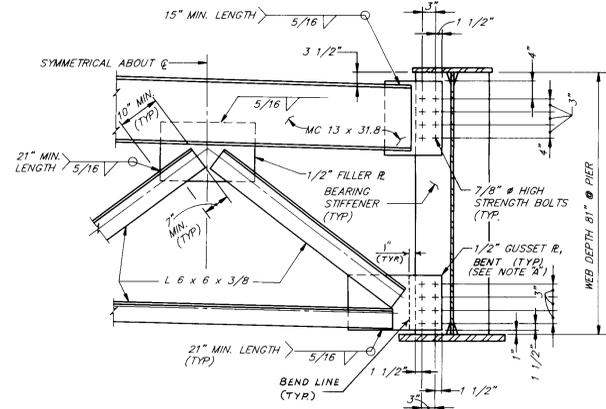

PIER CROSSFRAME

N.T.S.

A9 BUILT 5/12/94 40

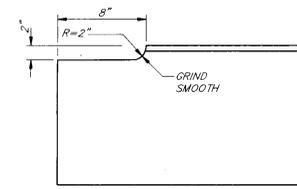

COPING DETAIL

N.T.S.

SEE ALSO HI-STEEL FABRICATION DRAWINGS

NOTE A:
GUSSET PLATES CONNECTING BEARING STIFFENERS TO CROSS FRAMES AT ABUTMENT 1 AND PIER TO BE BENT IN ACCORDANCE WITH 1989 AASHTO STANDARD SPECIFICATIONS FOR HIGHWAY BRIDGES, DIVISION 11, SECTION 10.23.2 AND ANY CURRENT REVISIONS. AT ABUTMENT 1, CARE SHOULD BE TAKEN TO AVOID INTERFERENCE WITH BEARING STIFFENERS AND ANCHOR BOLTS. (SEE BR611)

STATE OF VERMONT		AGENCY OF TRANSPORTATION	
TOWN OF ESSEX	Bridge No. 14	Log Sta.	
HIGHWAY NO. VT. RTE. 289	Surv. Sta. RAMP 15+00	VT. RTE. 289 "RAMP A" OVER CVRR	
GIRDER DETAILS			
Designed by YS/PJB	Drawn by M.W.D.	Checked by RJS date 10-12-90	
PROJECT WILLISTON - COLCHESTER		PROJECT NO. PB 033-1(2)	
Bridge Sheet No. BR608		Sheet 197 of 400	