




SECTION D-D
1" = 1'-0"

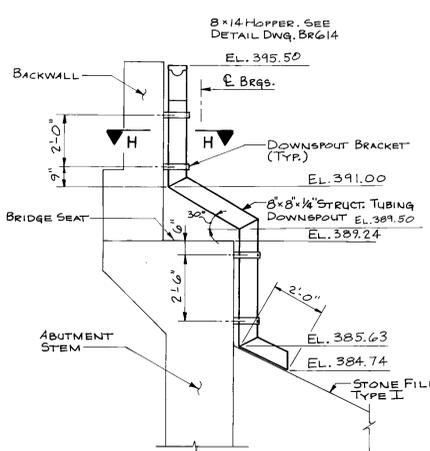

DOWNSPOUT DETAIL
3/8" = 1'-0"

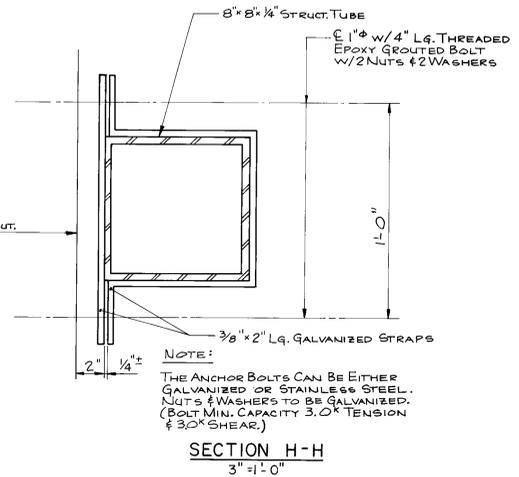


SECTION H-H
3" = 1'-0"

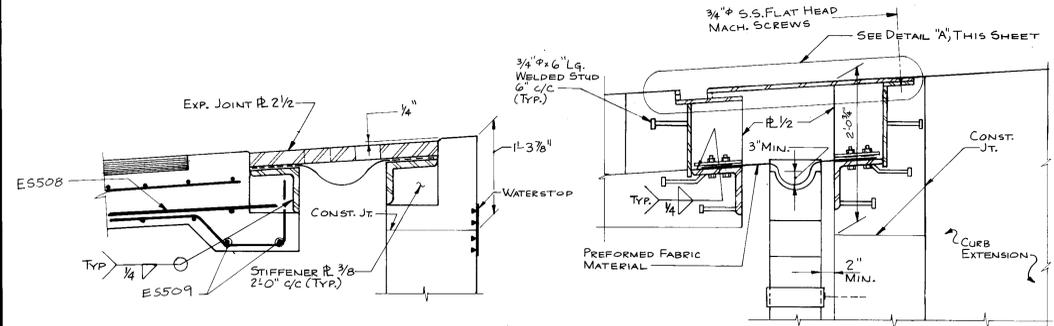

SECTION C-C
1" = 1'-0"

SECTION B-B
1" = 1'-0"

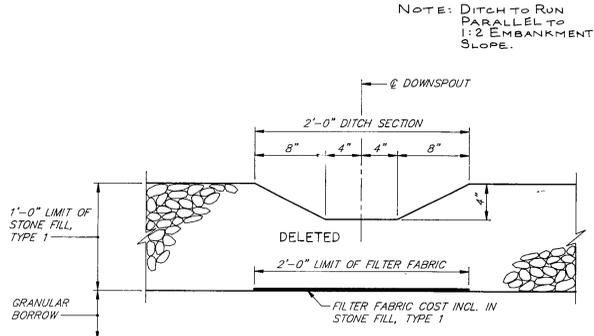

EXPANSION JOINT DOWNSPOUT DITCH
SCALE: 1 1/2" = 1'-0"


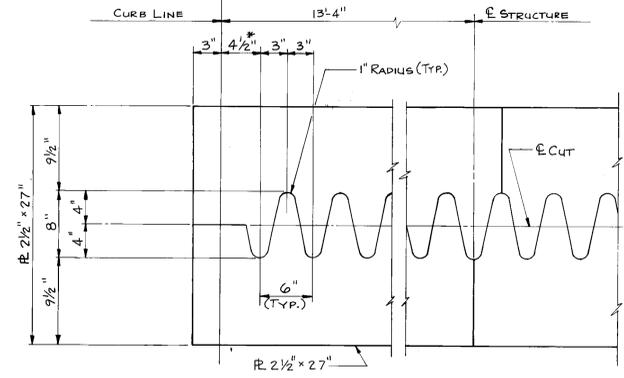


PLATE CUTTING DETAIL
1 1/2" = 1'-0"

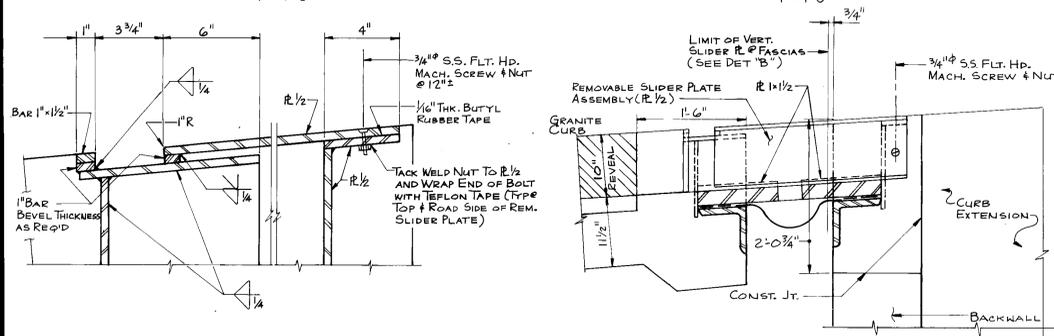

DETAIL A
3" = 1'-0"

SECTION E-E
1" = 1'-0"

SEE ALSO MERRIMACK SHEET METAL FABRICATION DRAWINGS

- NOTE:
1. FOR LOCATION OF SECTION C-C, D-D & E-E SEE SHEET BRG12.
 - * SEE BRIDGE EXPANSION JOINT PLAN, BRG12
 2. FOR LOCATION OF SEC. B-B SEE SHT. BRG14.
 3. FOR CURB EXTENSION DETAILS SEE SHT. BRG17.

AS BUILT 5/12/94

**STATE OF VERMONT
AGENCY OF TRANSPORTATION**

TOWN OF	ESSEX	Bridge No. 14
HIGHWAY NO. VT. RTE. 289		Log Sta.
VT. RTE. 289 "RAMP A" OVER CVRR		
BRIDGE EXPANSION JOINT DETAILS - 2		
Designed by	B. W.	Drawn by
Checked by	R. J. S. date 10/12/90	Bridge Design Supervisor
PROJECT	WILLISTON - COLCHESTER	PROJECT NO.
Bridge Sheet No.	BRG13	Sheet
		202 of 400

BRG13-48131-4051

BR-2