



DETAIL B
1 1/2" = 1'-0"


NOTE: DOWNSPOUT AT EAST CURBLINE ONLY.

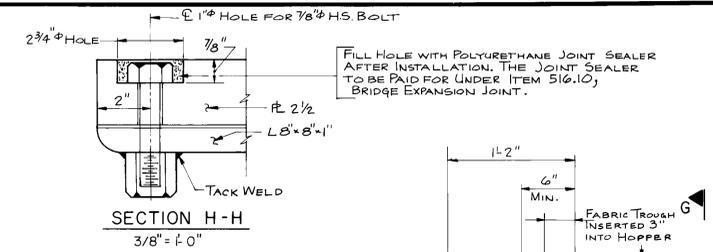


FILL HOLE WITH POLYURETHANE JOINT SEALER AFTER INSTALLATION. THE JOINT SEALER TO BE PAID FOR UNDER ITEM 516.10, BRIDGE EXPANSION JOINT.

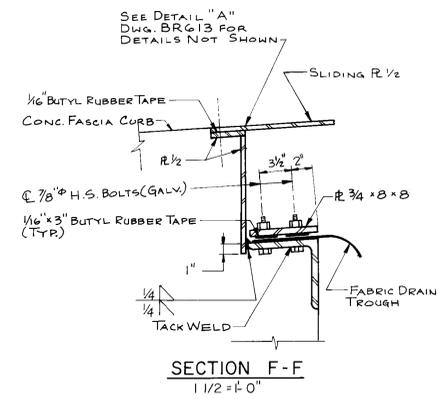

SECTION F-F
1 1/2" = 1'-0"

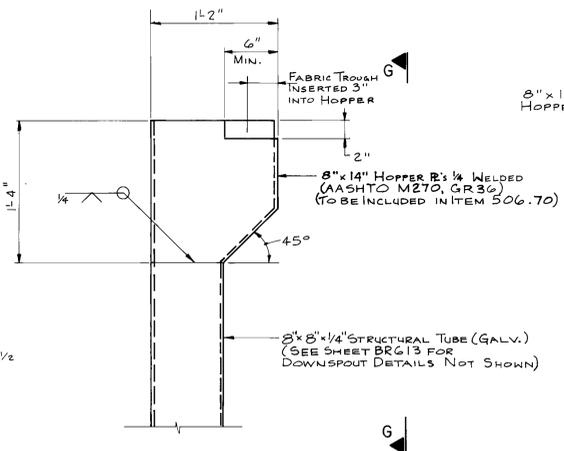

HOPPER DETAIL
1 1/2" = 1'-0"

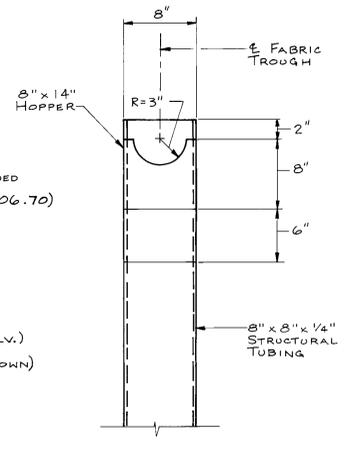

VIEW G-G
1 1/2" = 1'-0"

SEE ALSO MERRIMACK SHEET METAL SHOP DRAWINGS

NOTE:
FOR SECTION B-B SEE SHEET BR613

AS BUILT 5/12/94

STATE OF VERMONT	
AGENCY OF TRANSPORTATION	
TOWN OF	ESSEX
BRIDGE NO.	14
HIGHWAY NO. VT. RTE	289
LOG STA.	RAMP 15+00
V.T. RTE. 289 "RAMP A" OVER CVRR	
BRIDGE EXPANSION JOINT DETAILS - 3	
DESIGNED BY	B.W.
DRAWN BY	B.W.
CHECKED BY	R.J.S. date 10/12/90
BRIDGE DESIGN SUPERVISOR	M.W.O. date 10/12/90
PROJECT	WILLISTON - COLCHESTER
PROJECT NO.	PB 033 - 1 (2)
BRIDGE SHEET NO.	BR614
SHEET	203 OF 400

BR-2