


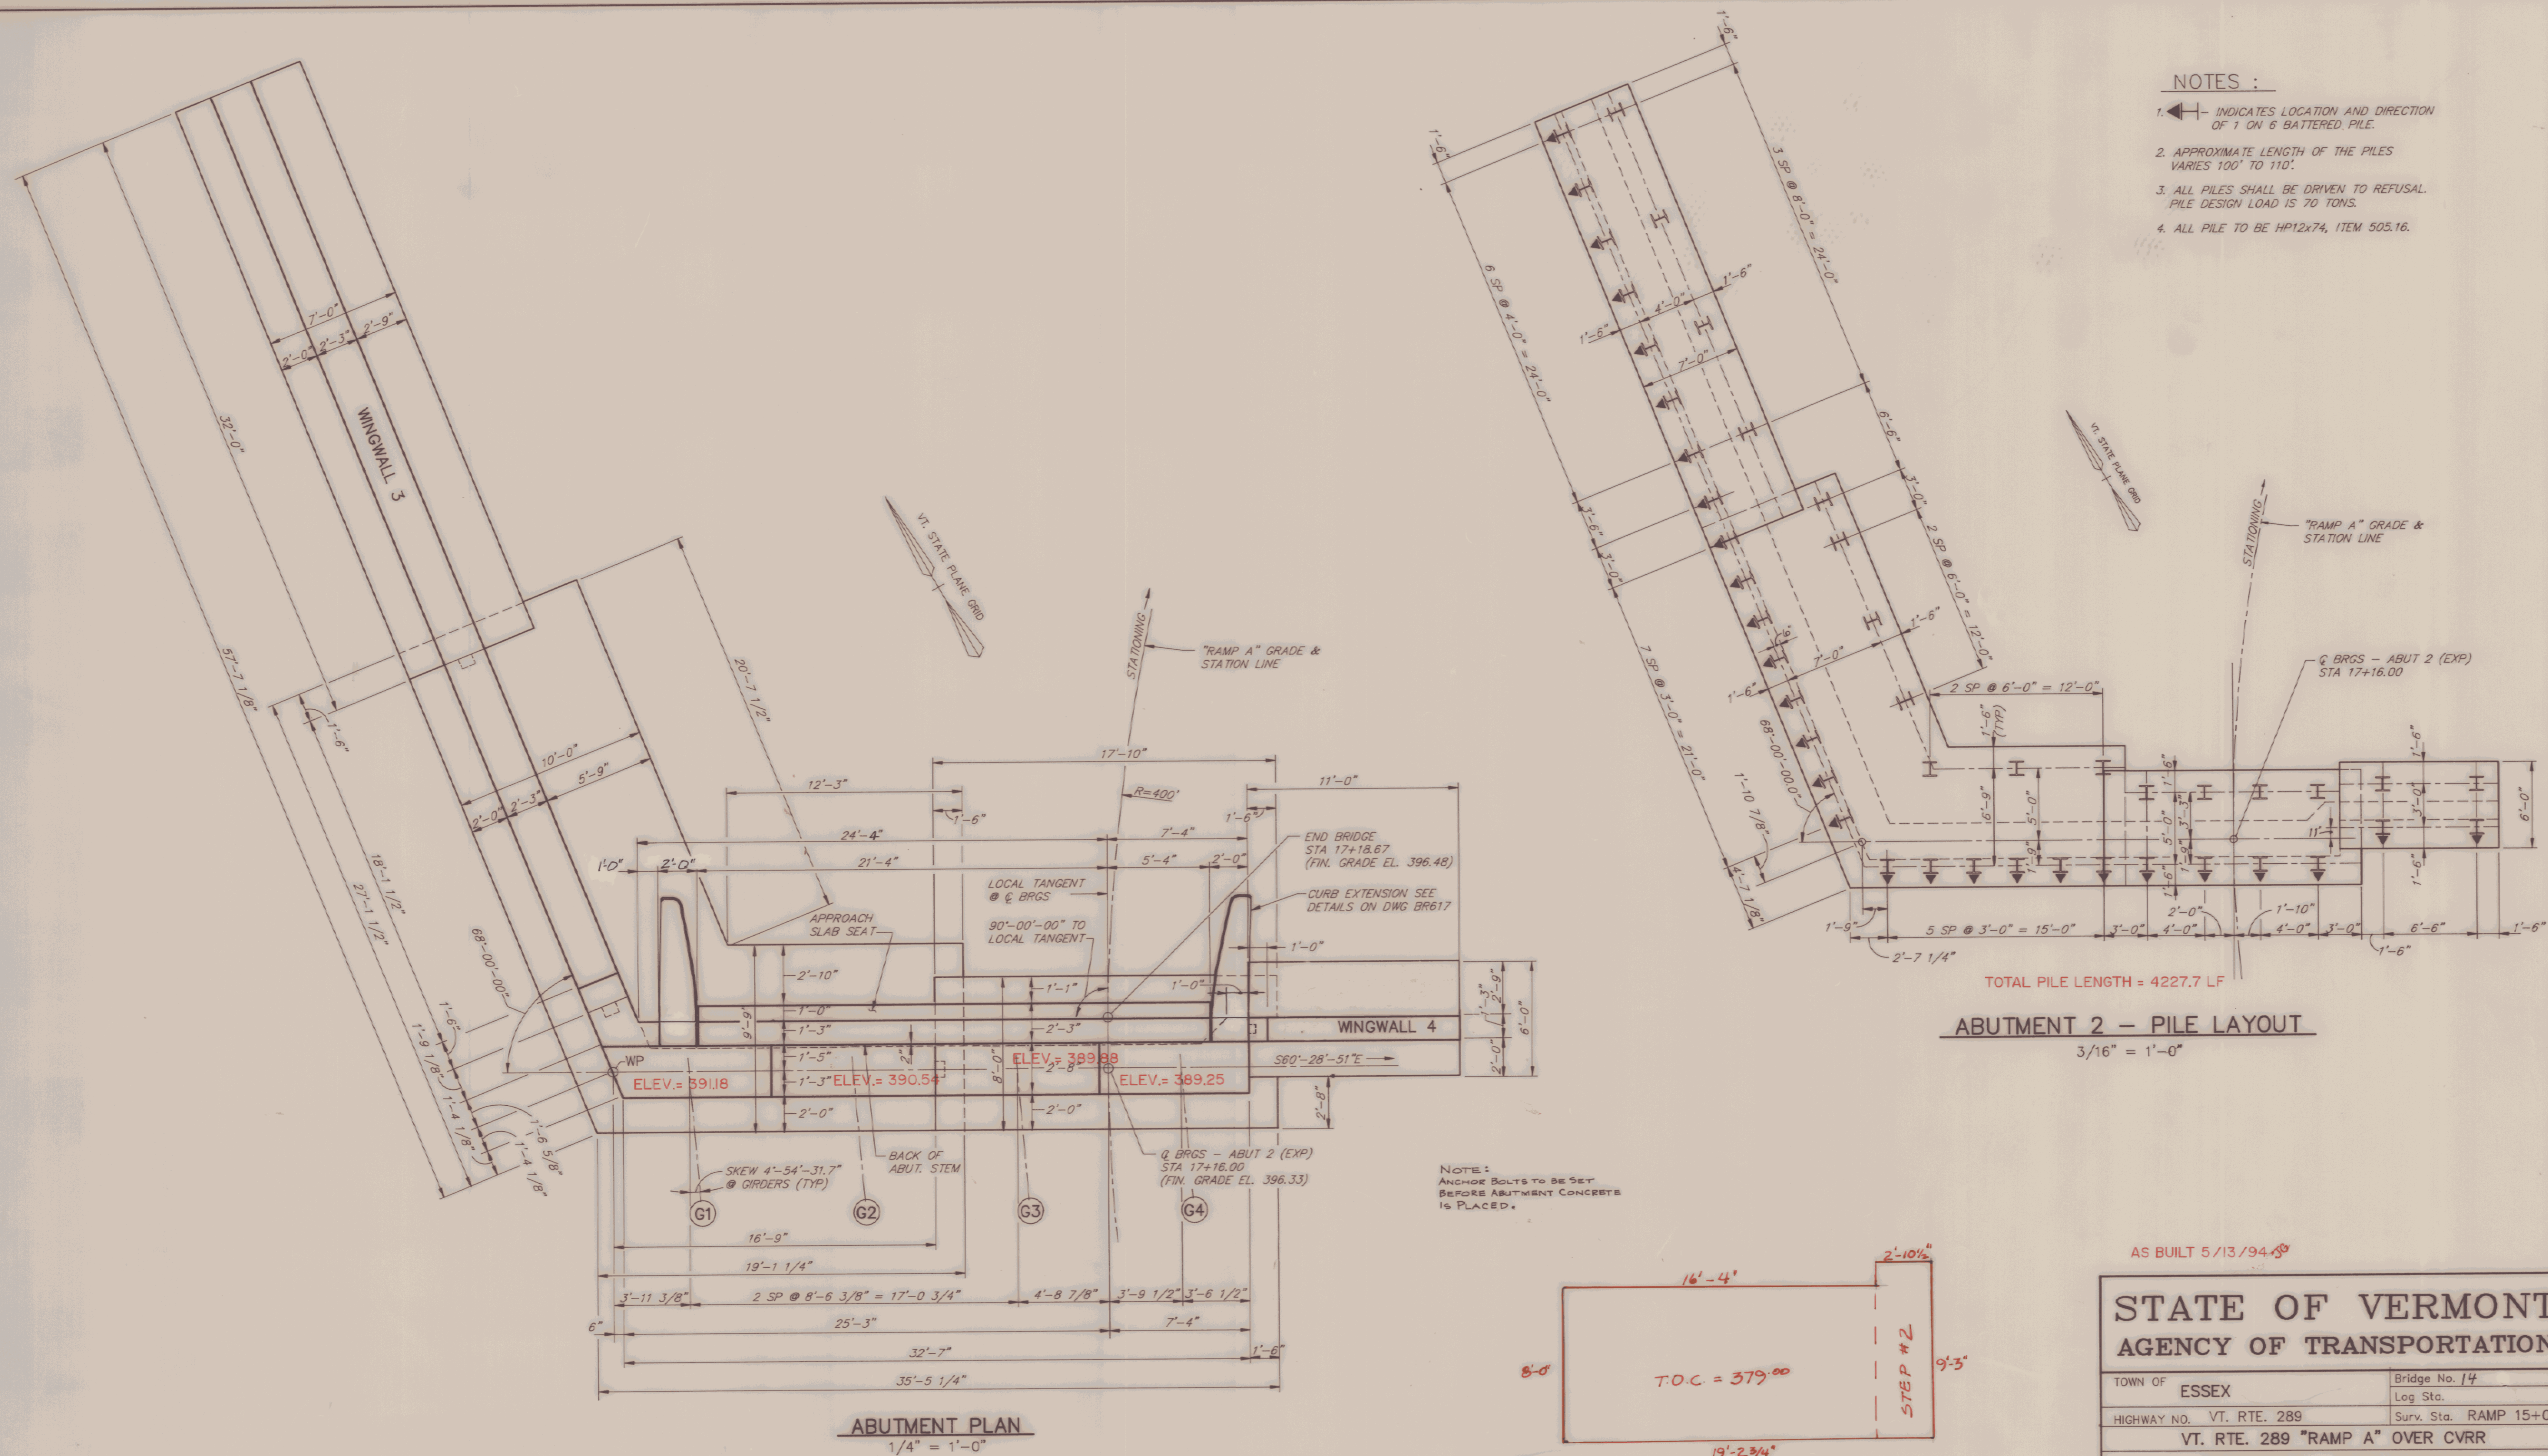

AS BUILT 5/13/94

STATE OF VERMONT AGENCY OF TRANSPORTATION			
TOWN OF	ESSEX	Bridge No.	14
HIGHWAY NO.	VT. RTE. 289	Log Sta.	
VT. RTE. 289 "RAMP A" OVER CVRR		Surv. Sta.	RAMP 15+00
ABUTMENT 2 - PLAN & DETAILS			
Designed by	KRH	Drawn by	JDH Sr.
Checked by	RJS	Bridge Design Supervisor	MWO
	date 10/12/90		date 10/12/90
PROJECT	WILLISTON - COLCHESTER	PROJECT NO.	PB 033 - 1(2)
Bridge Sheet No.	BR622	Sheet	211 of 400