




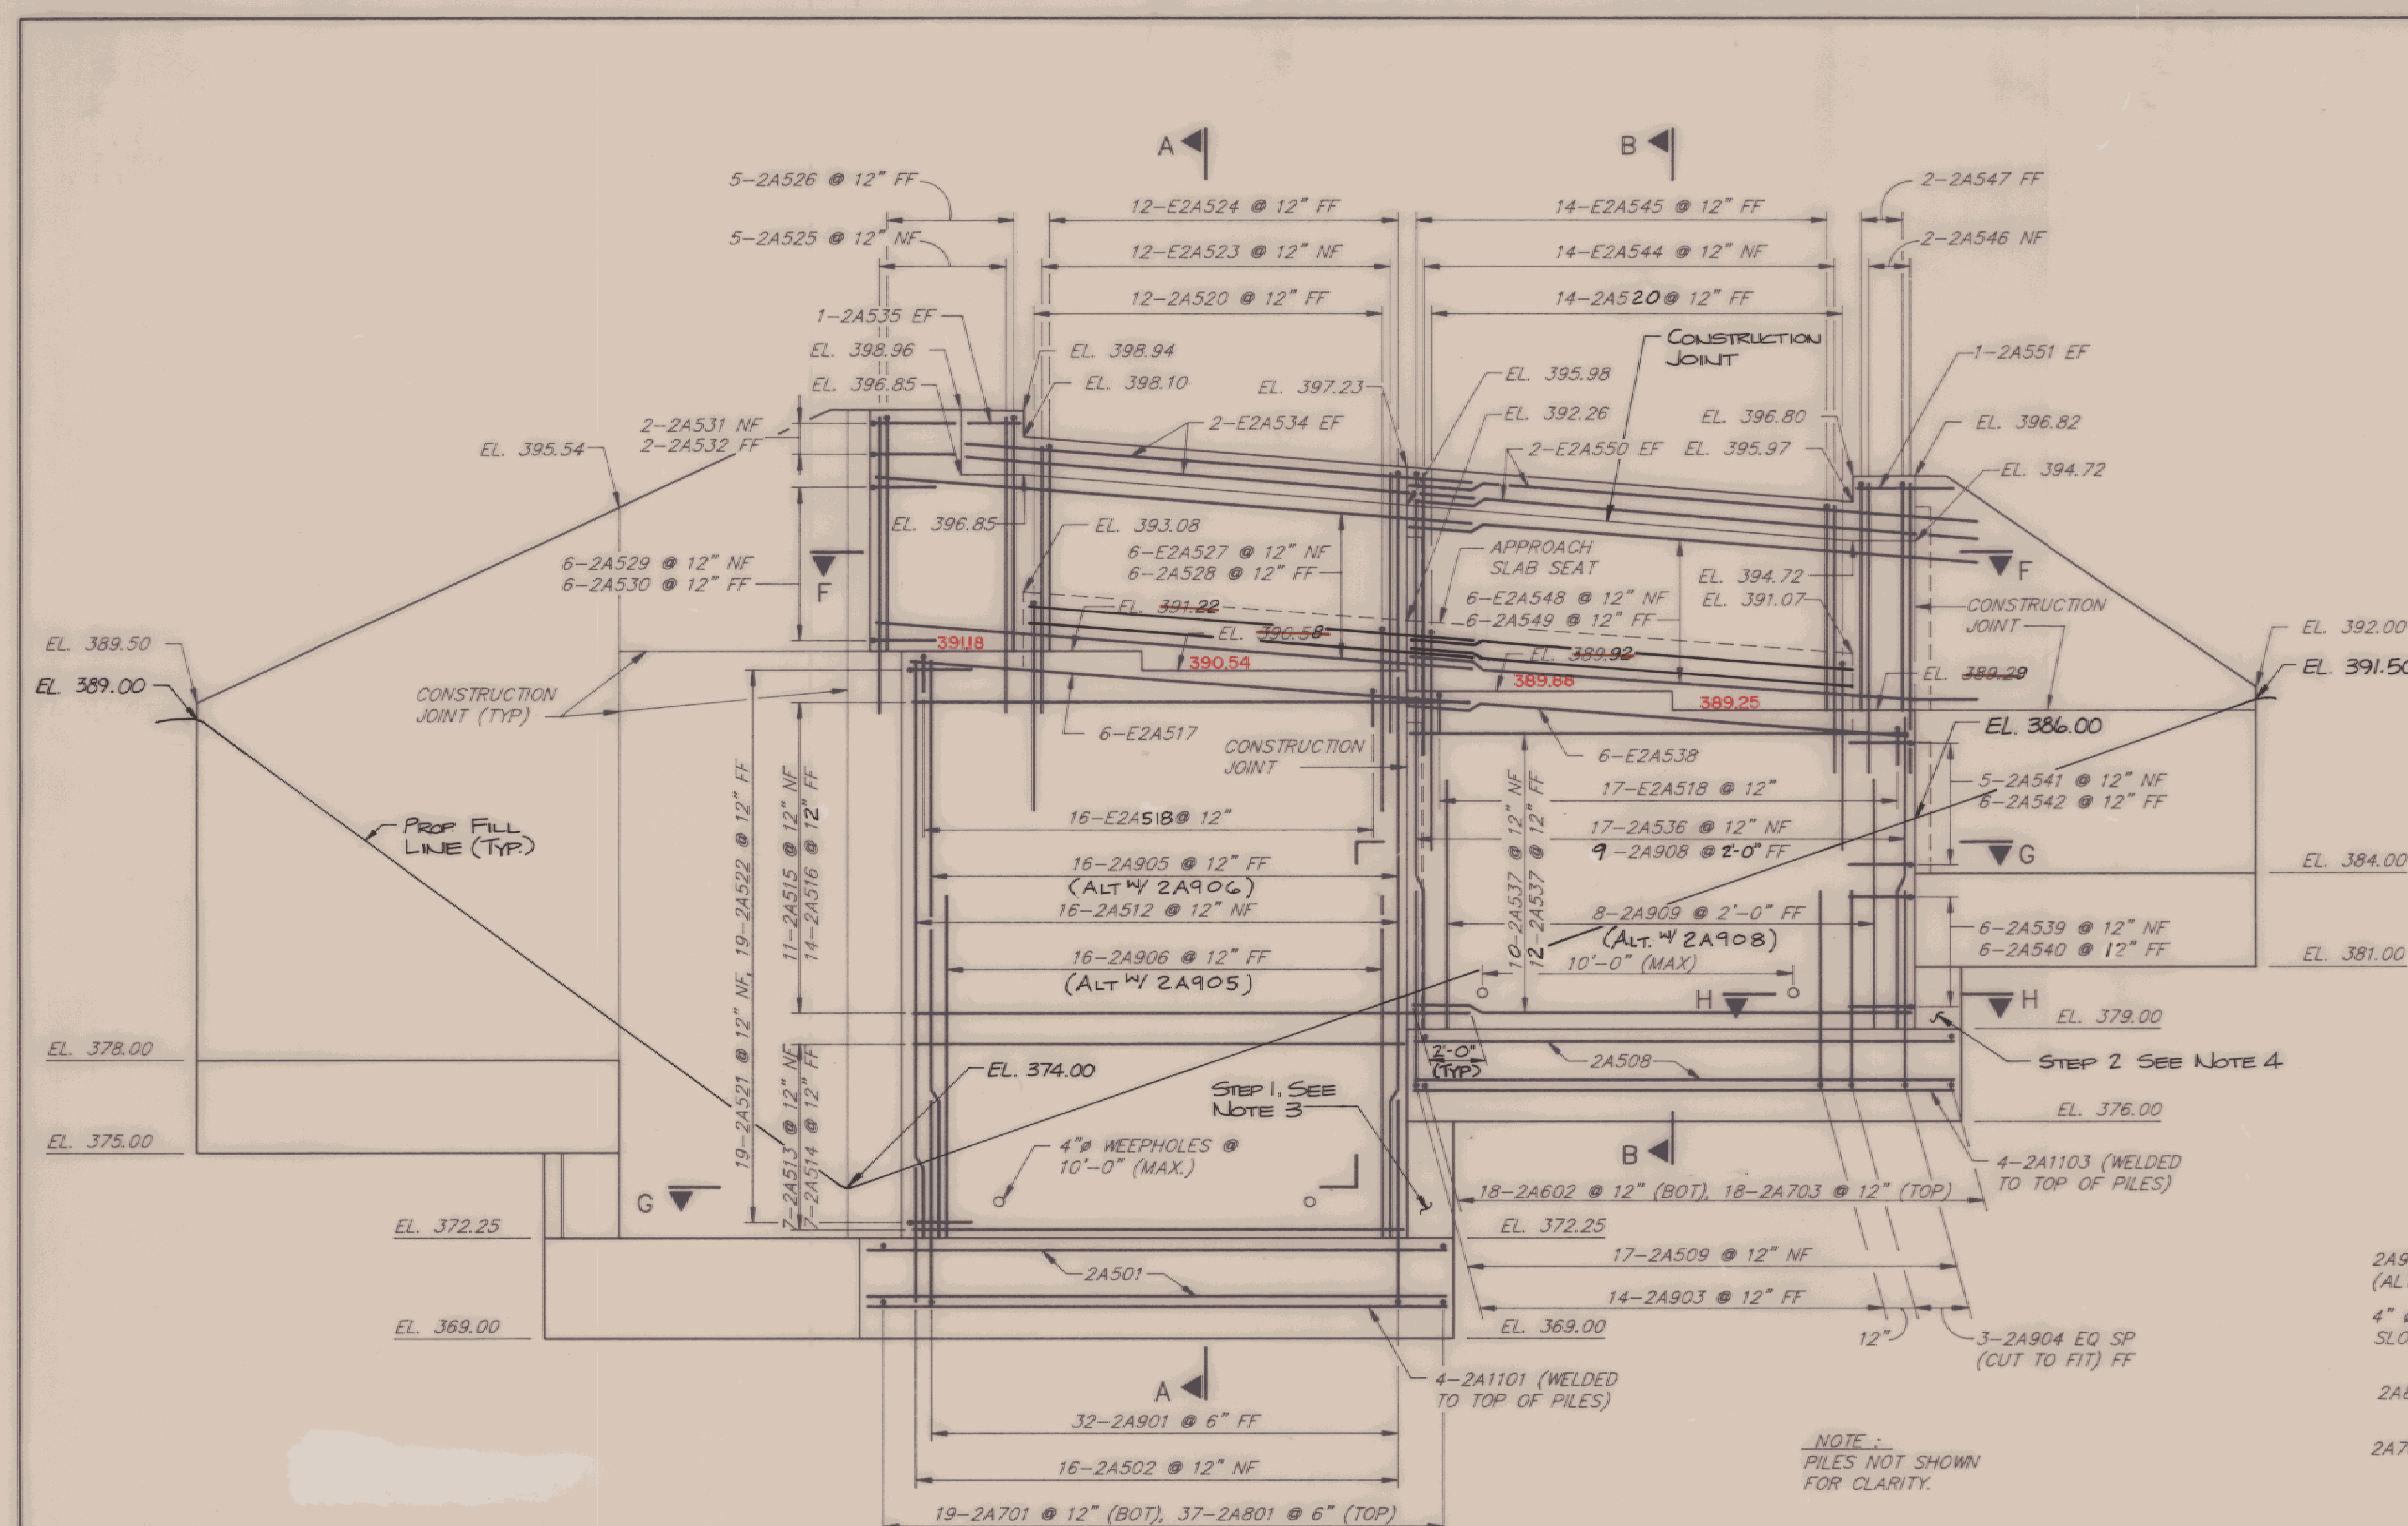

ABUTMENT 2 - ELEVATION
1/4" = 1'-0"

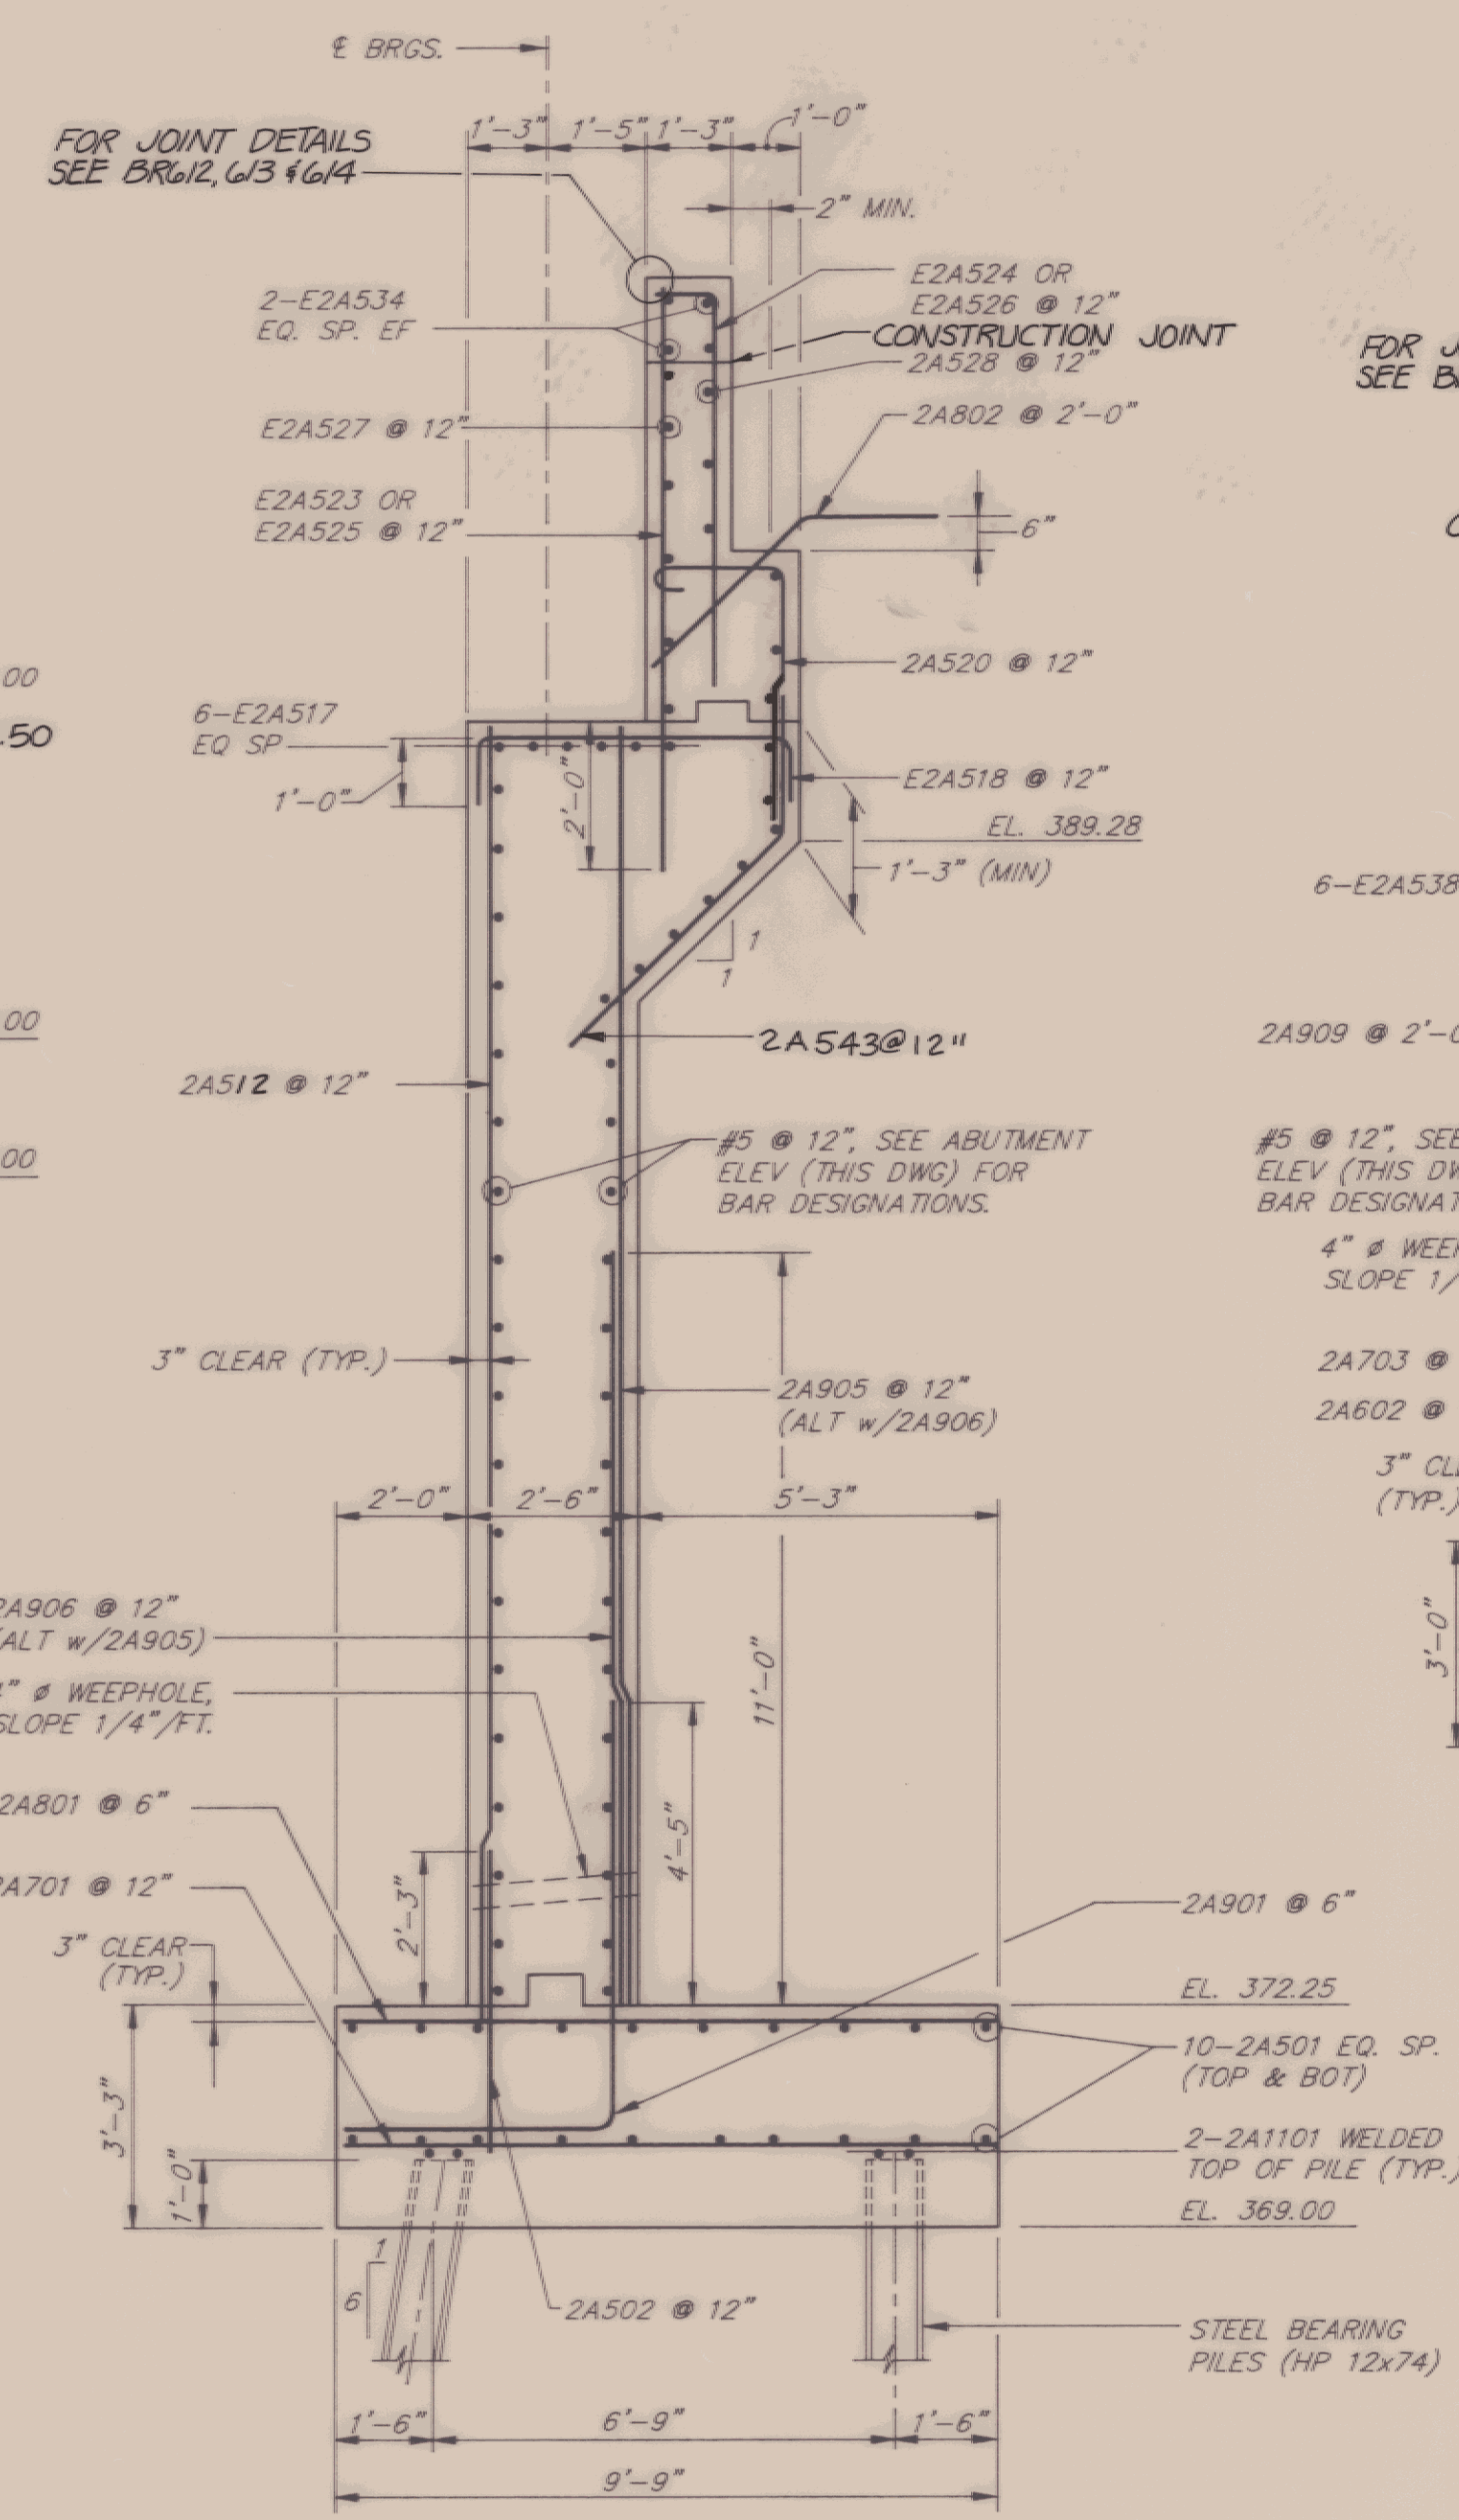

ABUTMENT 2 - SECTION A-A
3/8" = 1'-0"

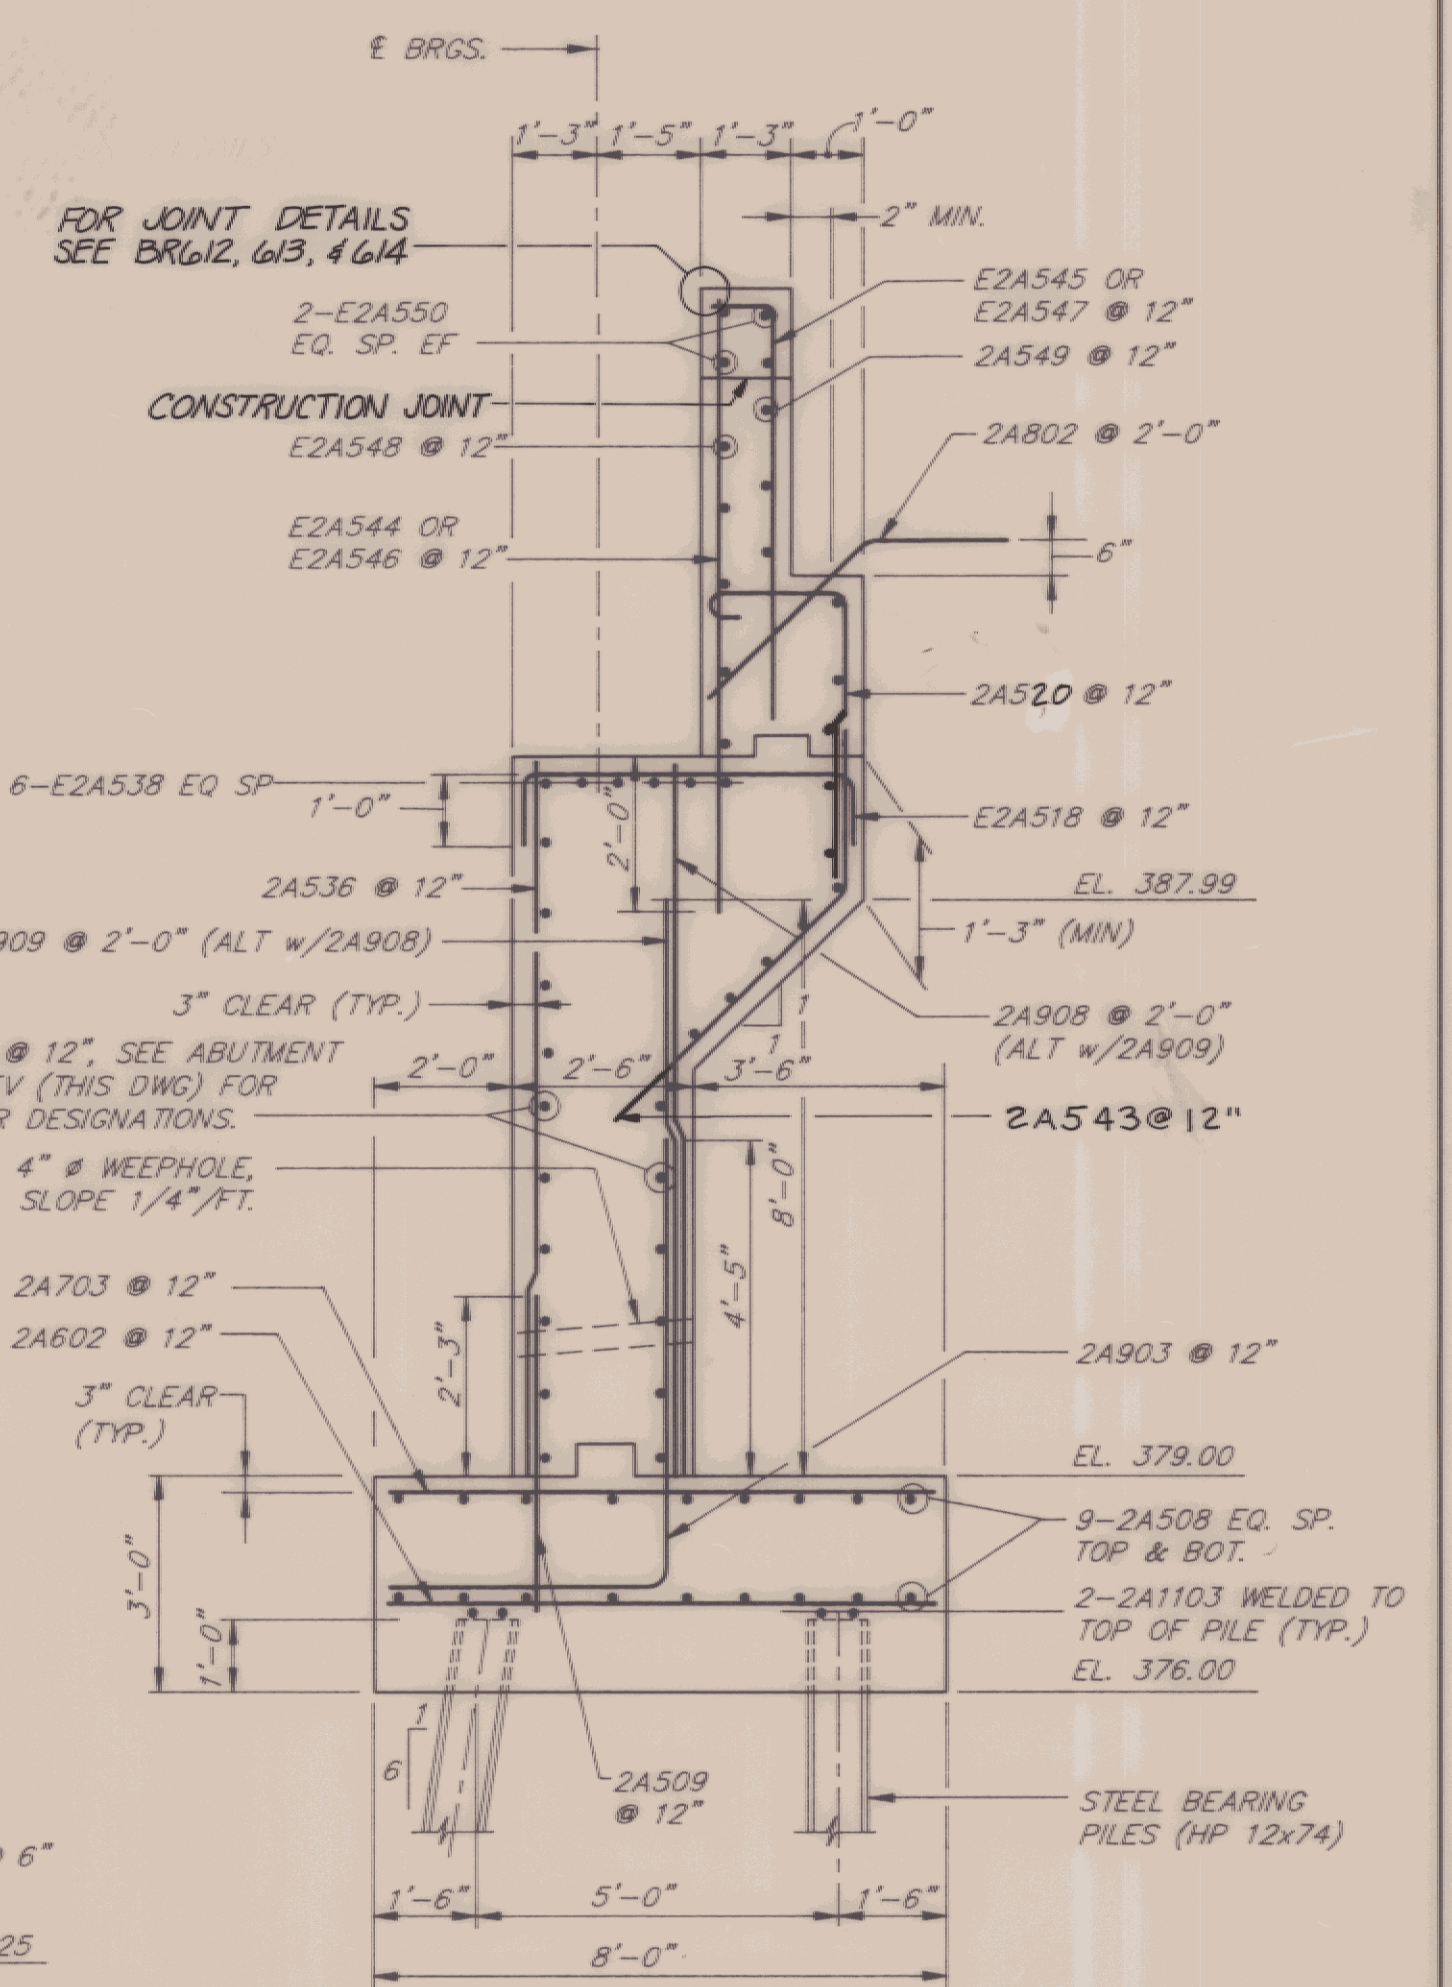

ABUTMENT 2 - SECTION B-B
3/8" = 1'-0"

- NOTES:**
1. FOR SECTIONS F-F, G-G, AND H-H SEE DWG BRG24.
 2. PREFIX "E" DENOTES BARS TO BE EPOXY COATED.
 3. FOR REINF SEE STEP 1 DETAIL, DWG BRG25.
 4. FOR REINF SEE STEP 2 DETAIL, DWG BRG25.

AS BUILT 5/13/94

STATE OF VERMONT	
AGENCY OF TRANSPORTATION	
TOWN OF ESSEX	Bridge No. 14
HIGHWAY NO. VT. RTE. 289	Log Sta. RAMP 15+00
VT. RTE. 289 "RAMP A" OVER CVRR	
ABUTMENT 2 - ELEVATION & SECTIONS	
Designed by KRH	Drawn by JDH SR./DJA
Checked by RJS date 10/12/90	Bridge Design Supervisor MWD date 10/12/90
PROJECT WILLISTON - COLCHESTER	PROJECT NO. PB 033 - 1(2)
Bridge Sheet No. BRG23	Sheet 212 of 400