
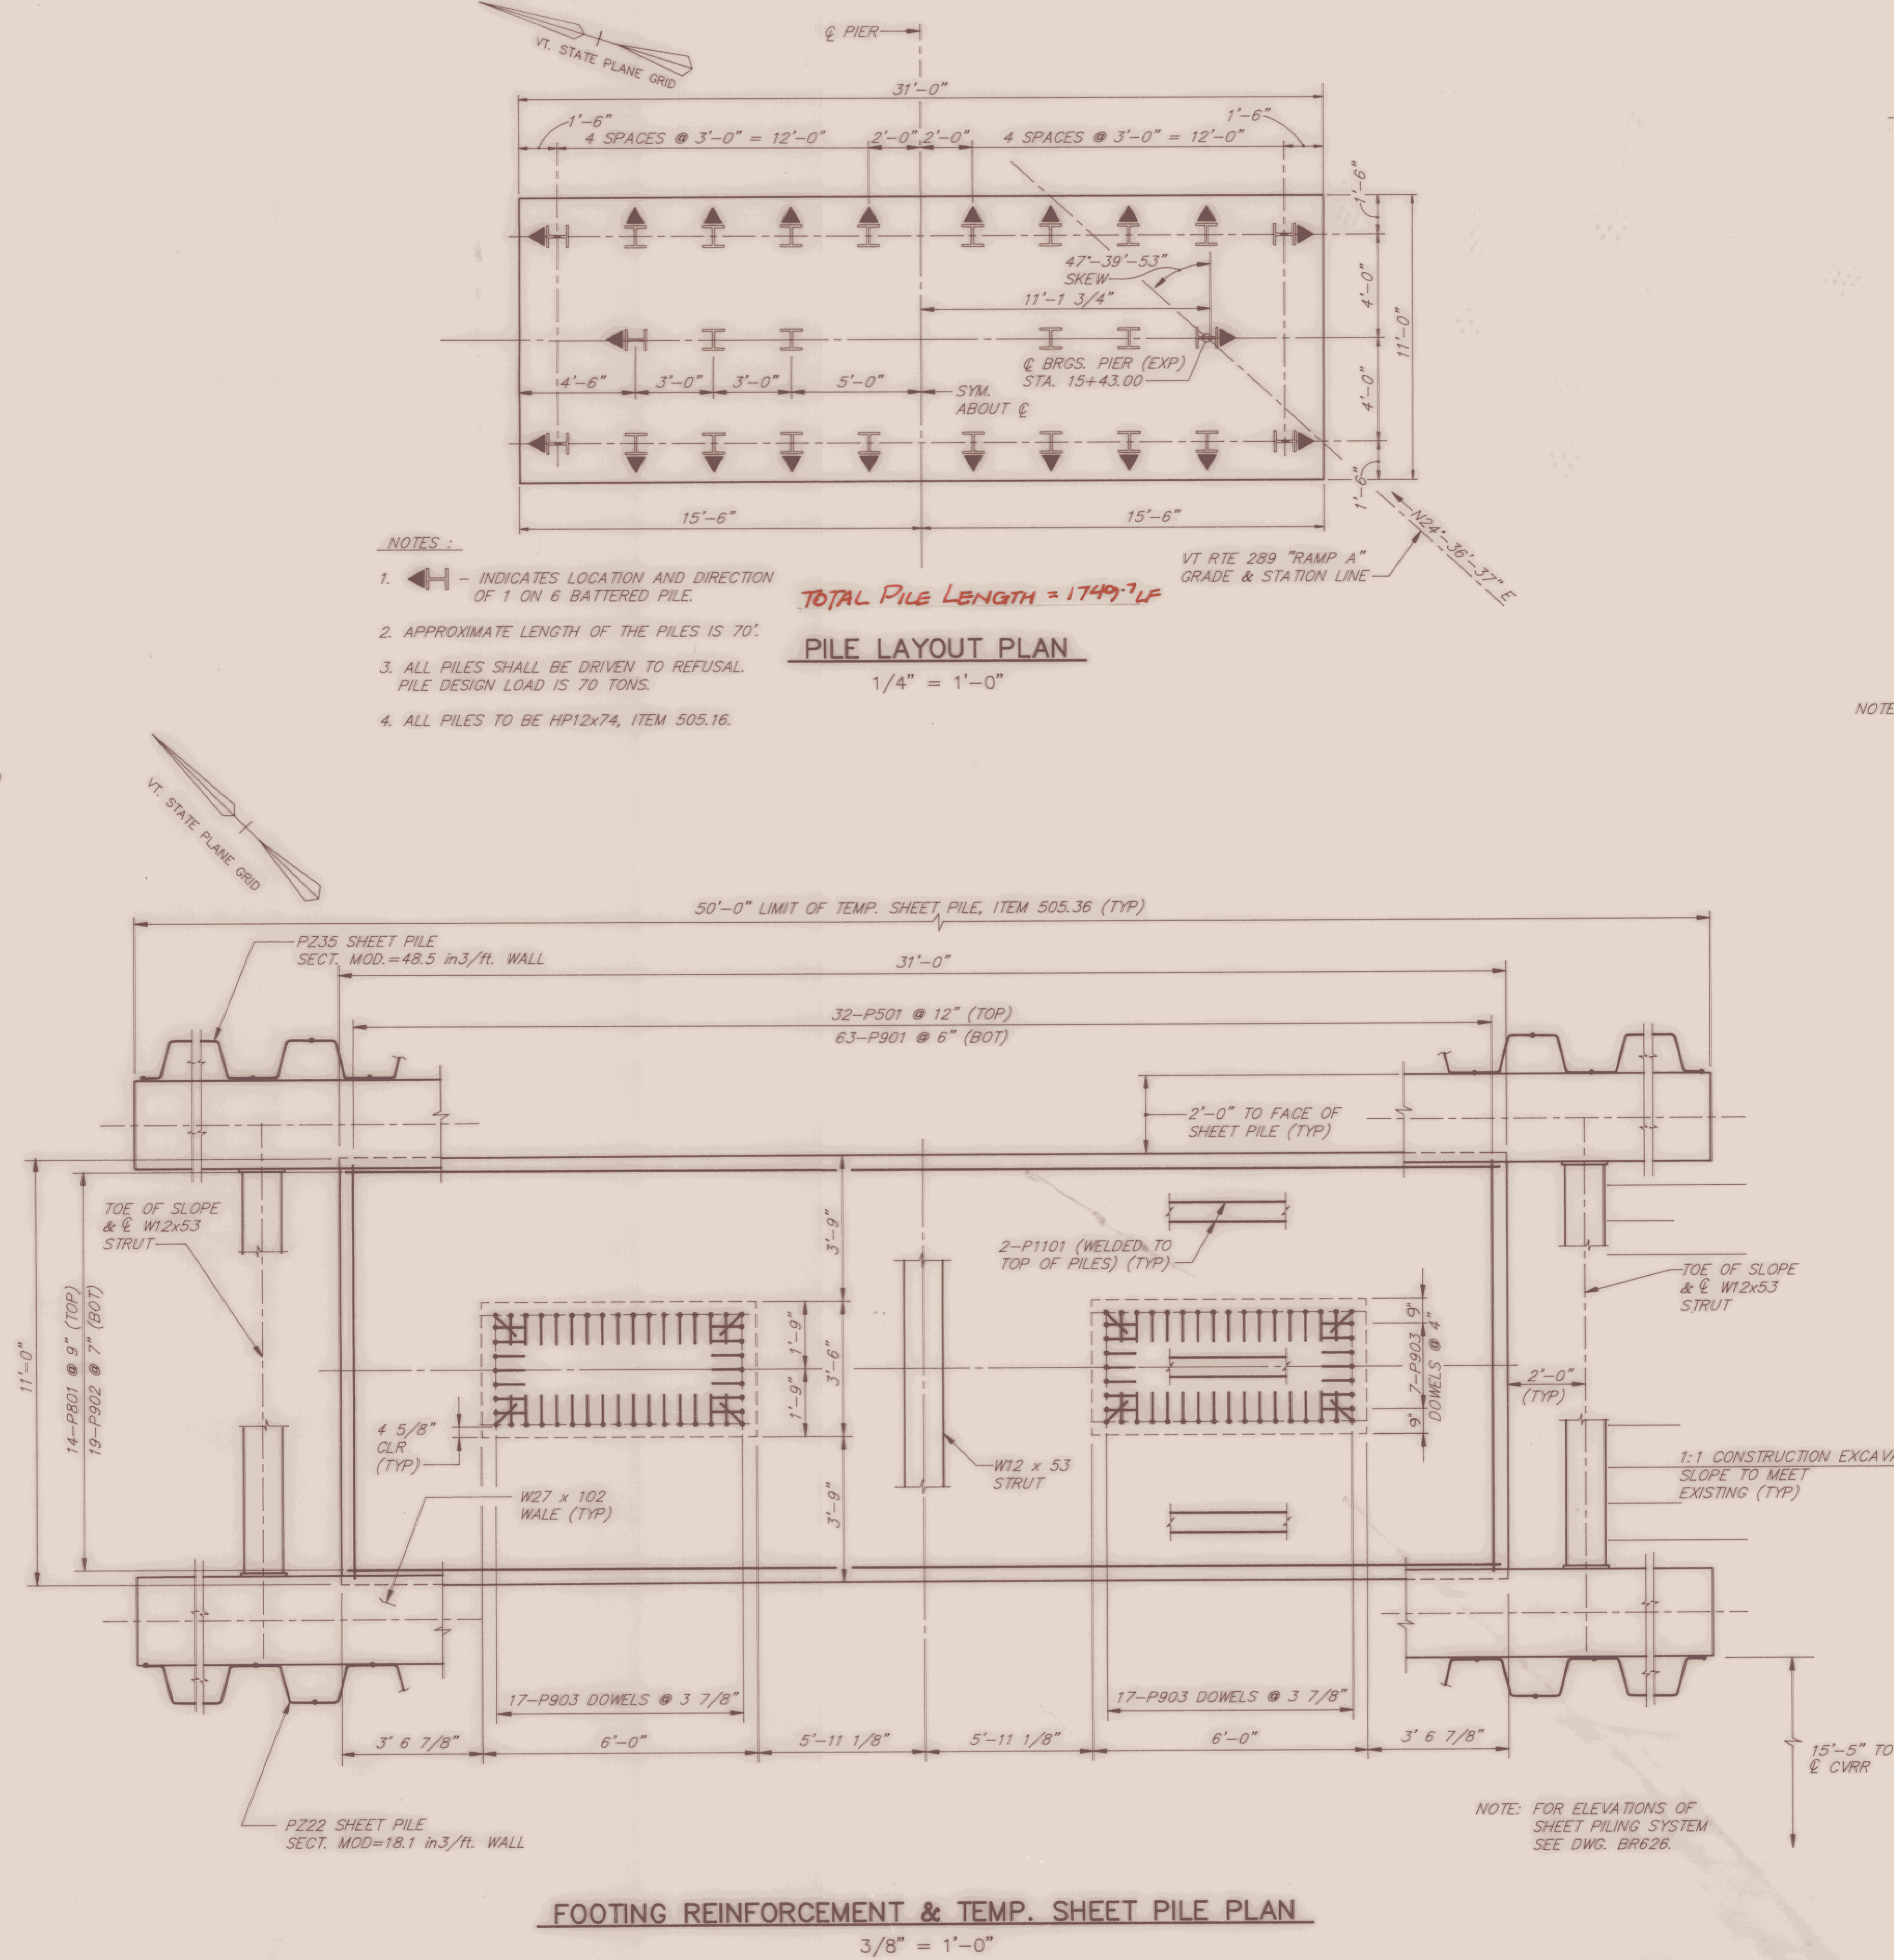


SEE WRITTEN ORDER 102
FOR REINF. STEEL CHANGES

NOTE : 1. FOR LOCATION OF SECTIONS C-G, AND D-D
SEE SHEET BR626.

2. FOR THIS STRUCTURE UNIT (PIER), COARSE AGGREGATE
FOR CONCRETE, CLASS B SHALL BE LIMITED TO 3/4"
STONE (MAX.) IN ACCORDANCE WITH TABLE 704.02B OF
THE VERMONT STANDARD SPECIFICATIONS FOR CONSTRUCTION.

3. ANCHOR BOLTS SHALL BE SET BEFORE PIER
CONCRETE IS PLACED.

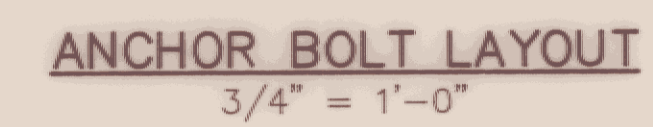

AS BUILT 5/13/94 JG

STATE OF VERMONT
AGENCY OF TRANSPORTATION

TOWN OF ESSEX		Bridge No. <u>14</u>	
		Log Sta.	
HIGHWAY NO. VT. RTE. 289		Surv. Sta. RAMP 15+00	
VT. RT. 289 "RAMP A" OVER CVRR			
PIER DETAILS			
Designed by YS		Drawn by RFU / M.W.D.	
Checked by RJS date 10/12/90		Bridge Design Supervisor MWO date 10/12/90	
PROJECT		PROJECT NO.	
WILLISTON - COLCHESTER		PB 033-1(2)	
Bridge Sheet No. BR627		Sheet 216 of 400	