


VERMONT ROUTE 289

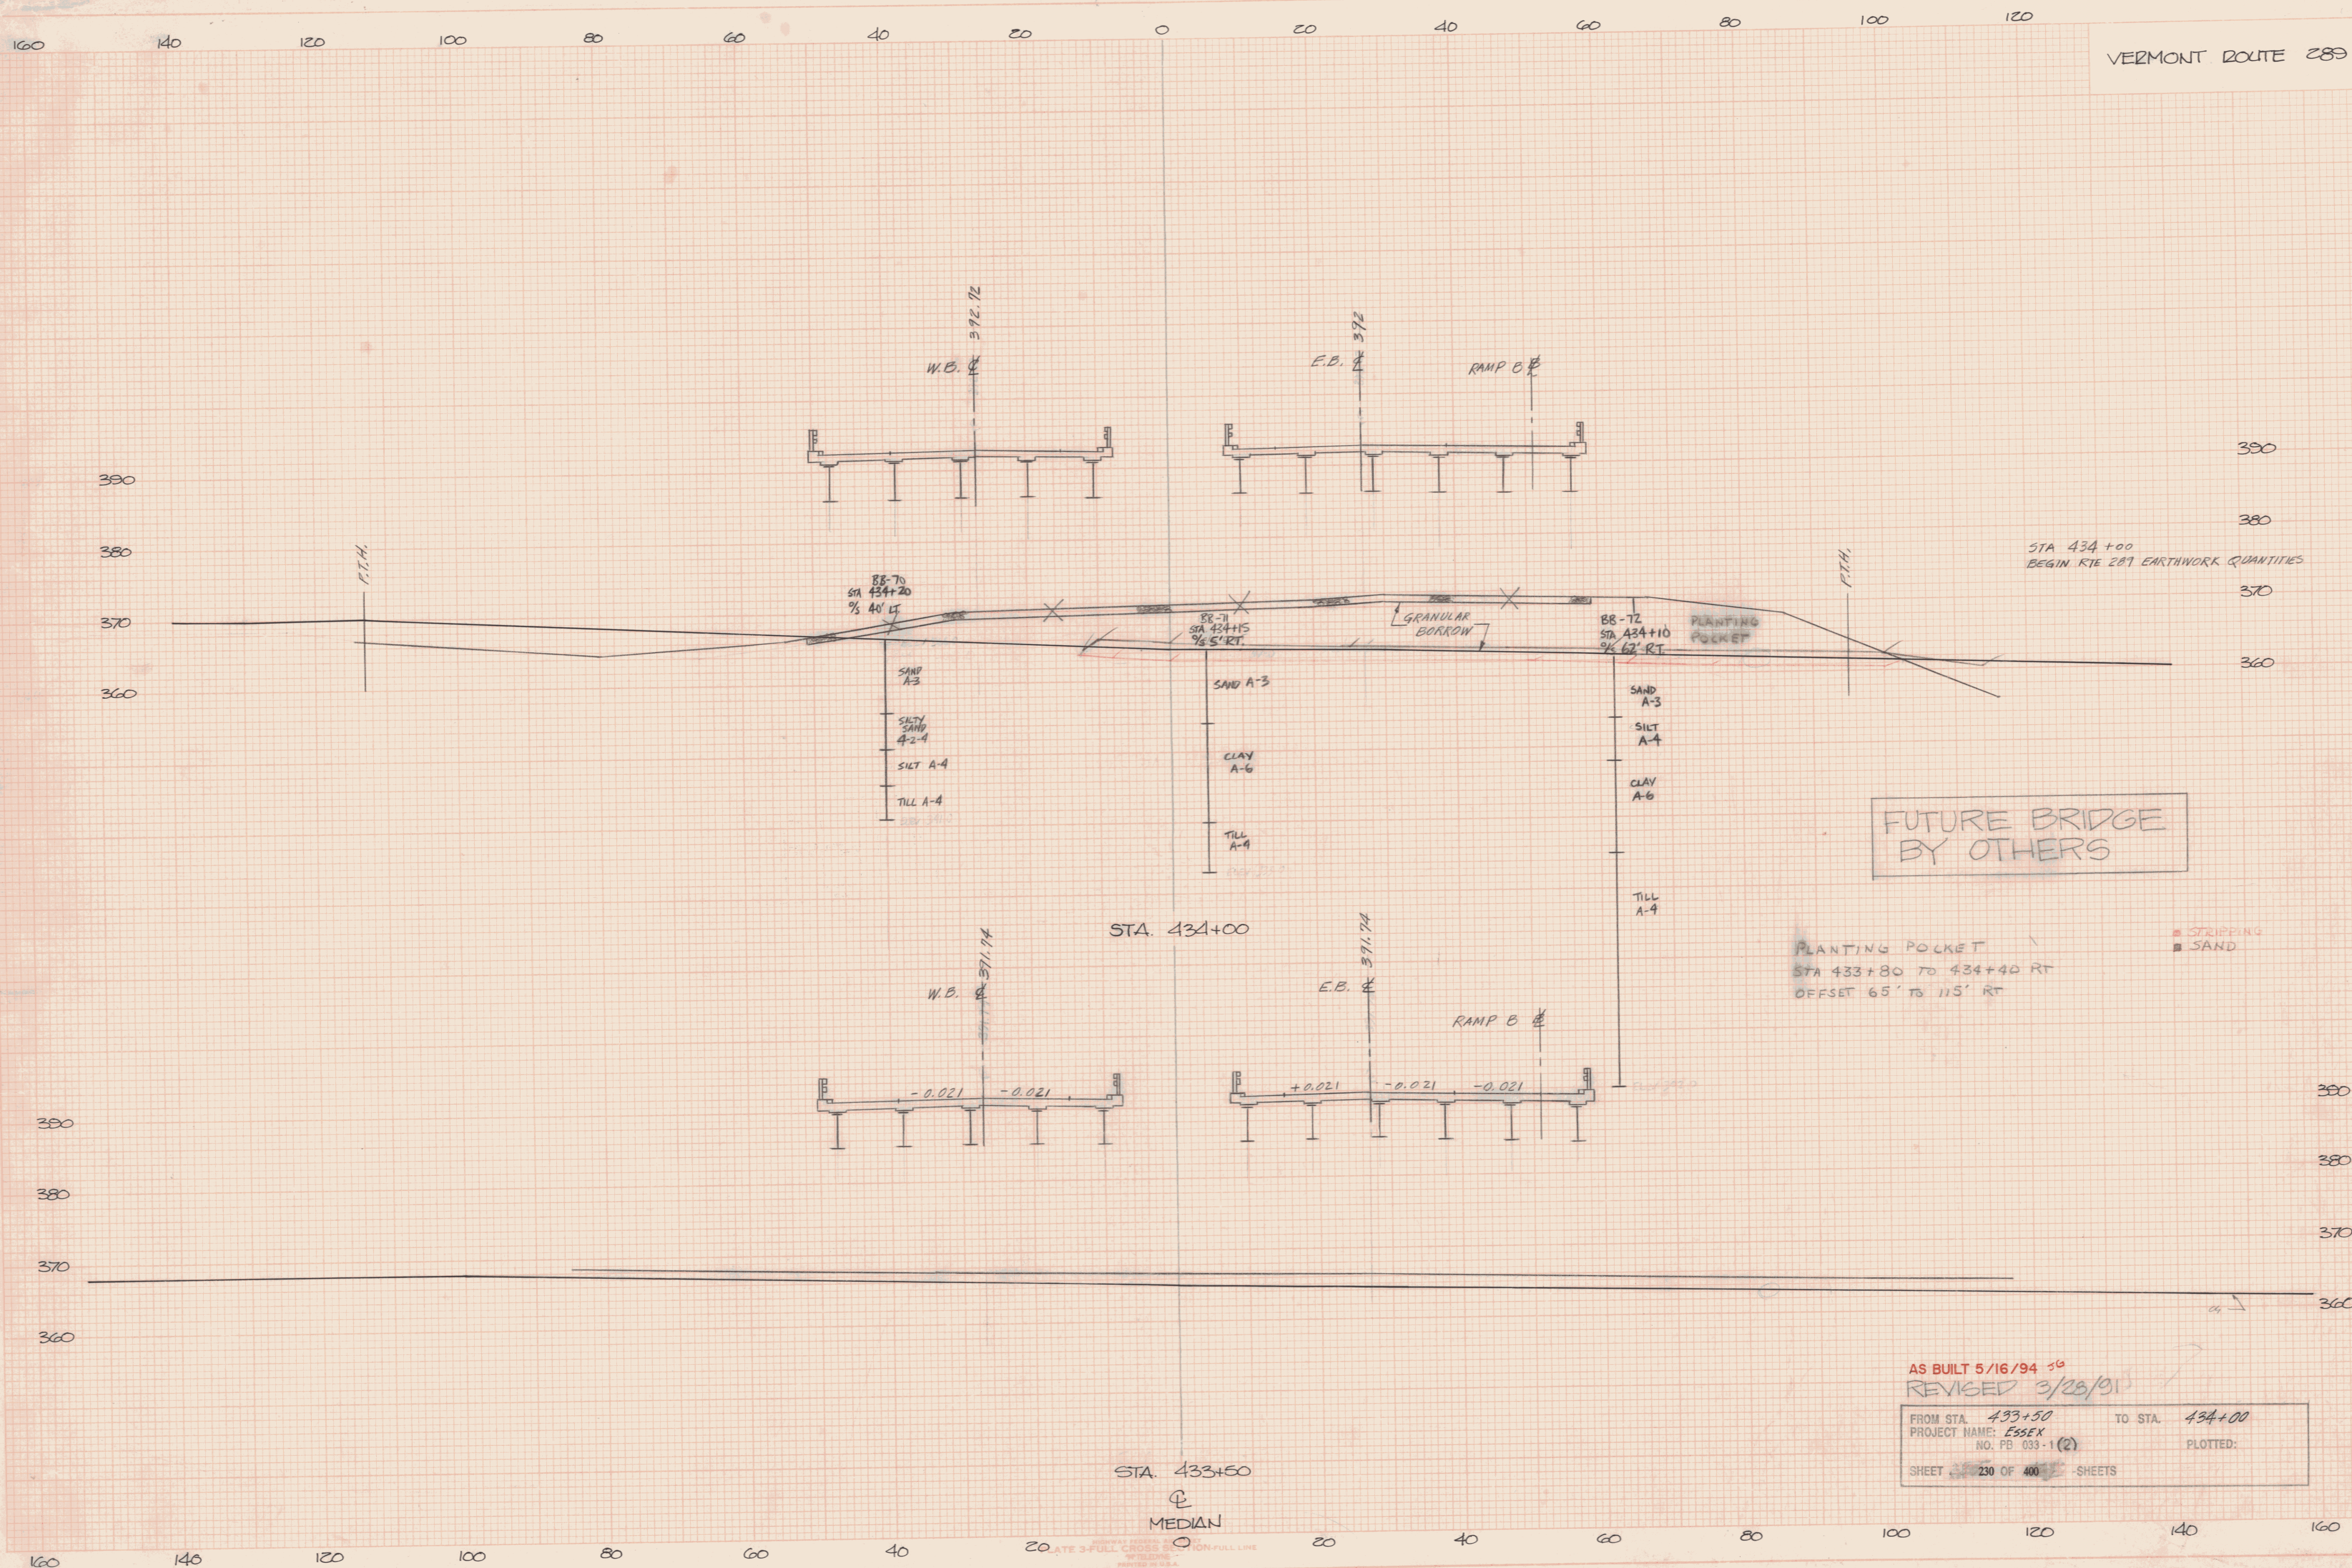

AS BUILT 5/16/94
REVISED 3/28/91
FROM STA. 433+50 TO STA. 434+00
PROJECT NAME: ESSEX
NO. PB 033-1 (2)
PLOTTED:
SHEET 230 OF 400 SHEETS