


VERMONT ROUTE 289

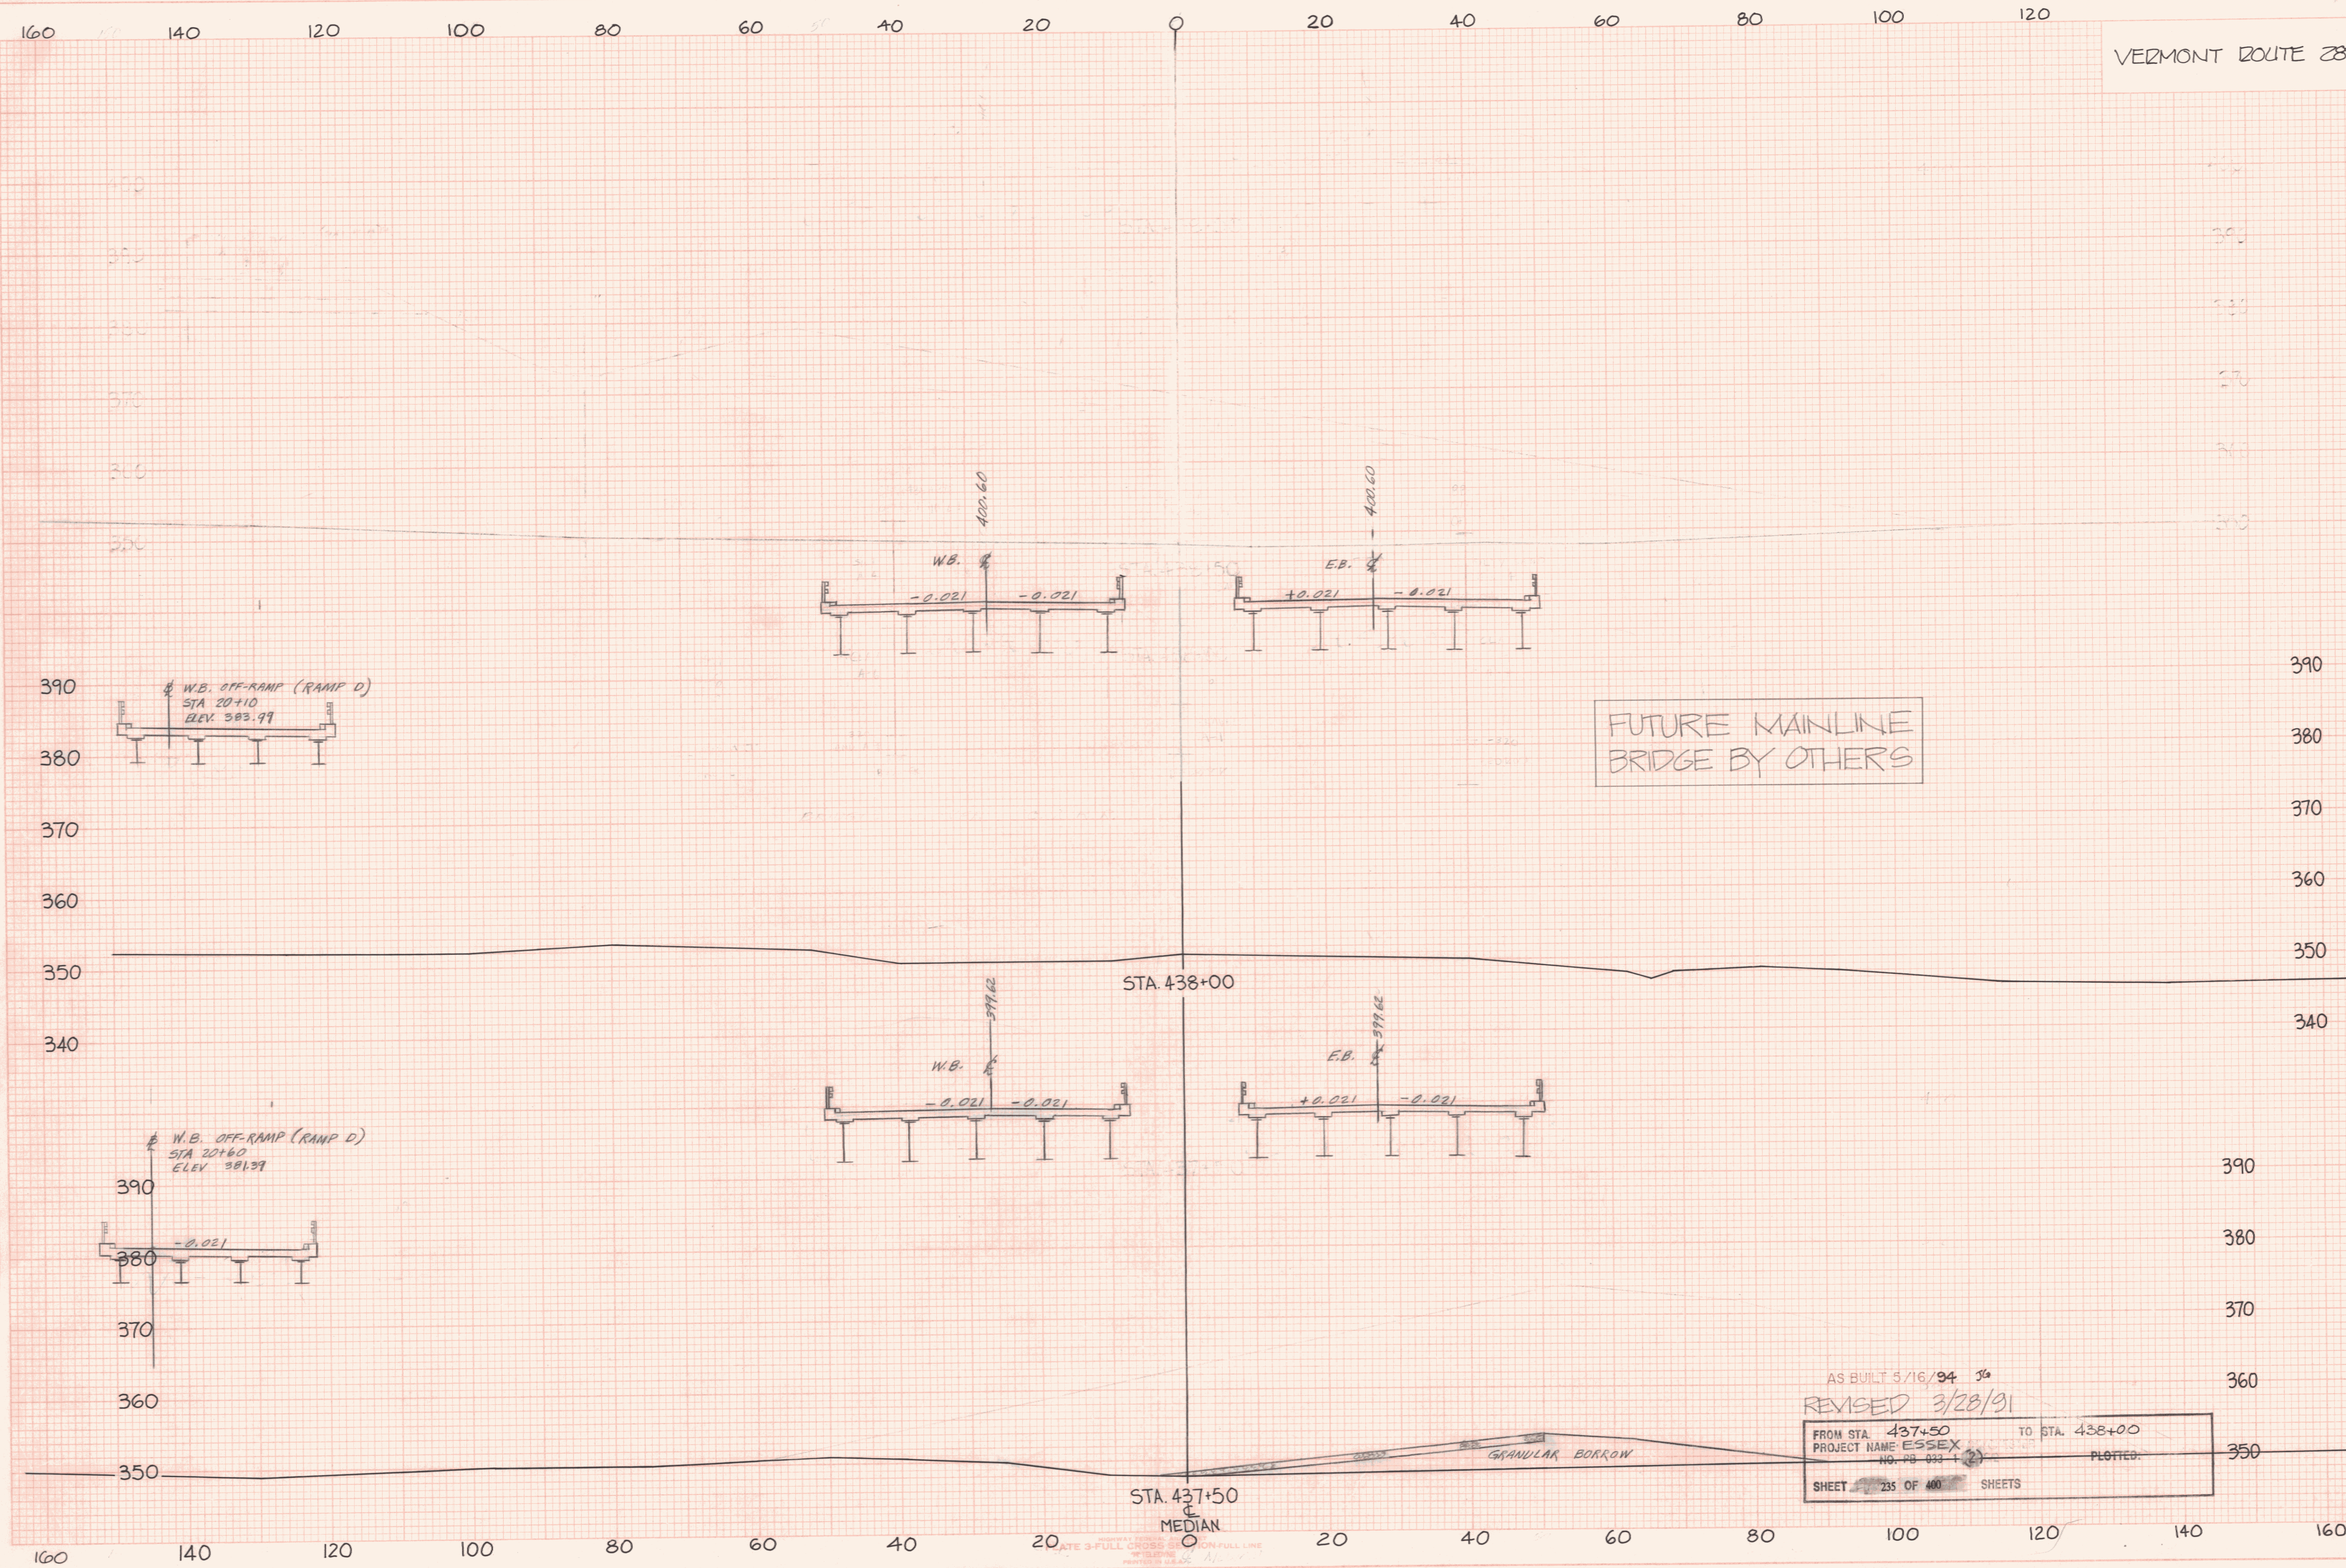

AS BUILT 5/16/94
REVISED 3/28/91
FROM STA 437+50 TO STA 438+00
PROJECT NAME ESSEX
NO. 23 OF 40 SHEETS
PLOTTER