


DATE: _____
 BY: _____
 CHECKED: _____
 ORIGINAL SURVEY PLANNED BY: _____
 NOTE BOOK: _____
 NO. _____

DATE: _____
 BY: _____
 CHECKED: _____
 ORIGINAL SURVEY PLANNED BY: _____
 NOTE BOOK: _____
 NO. _____

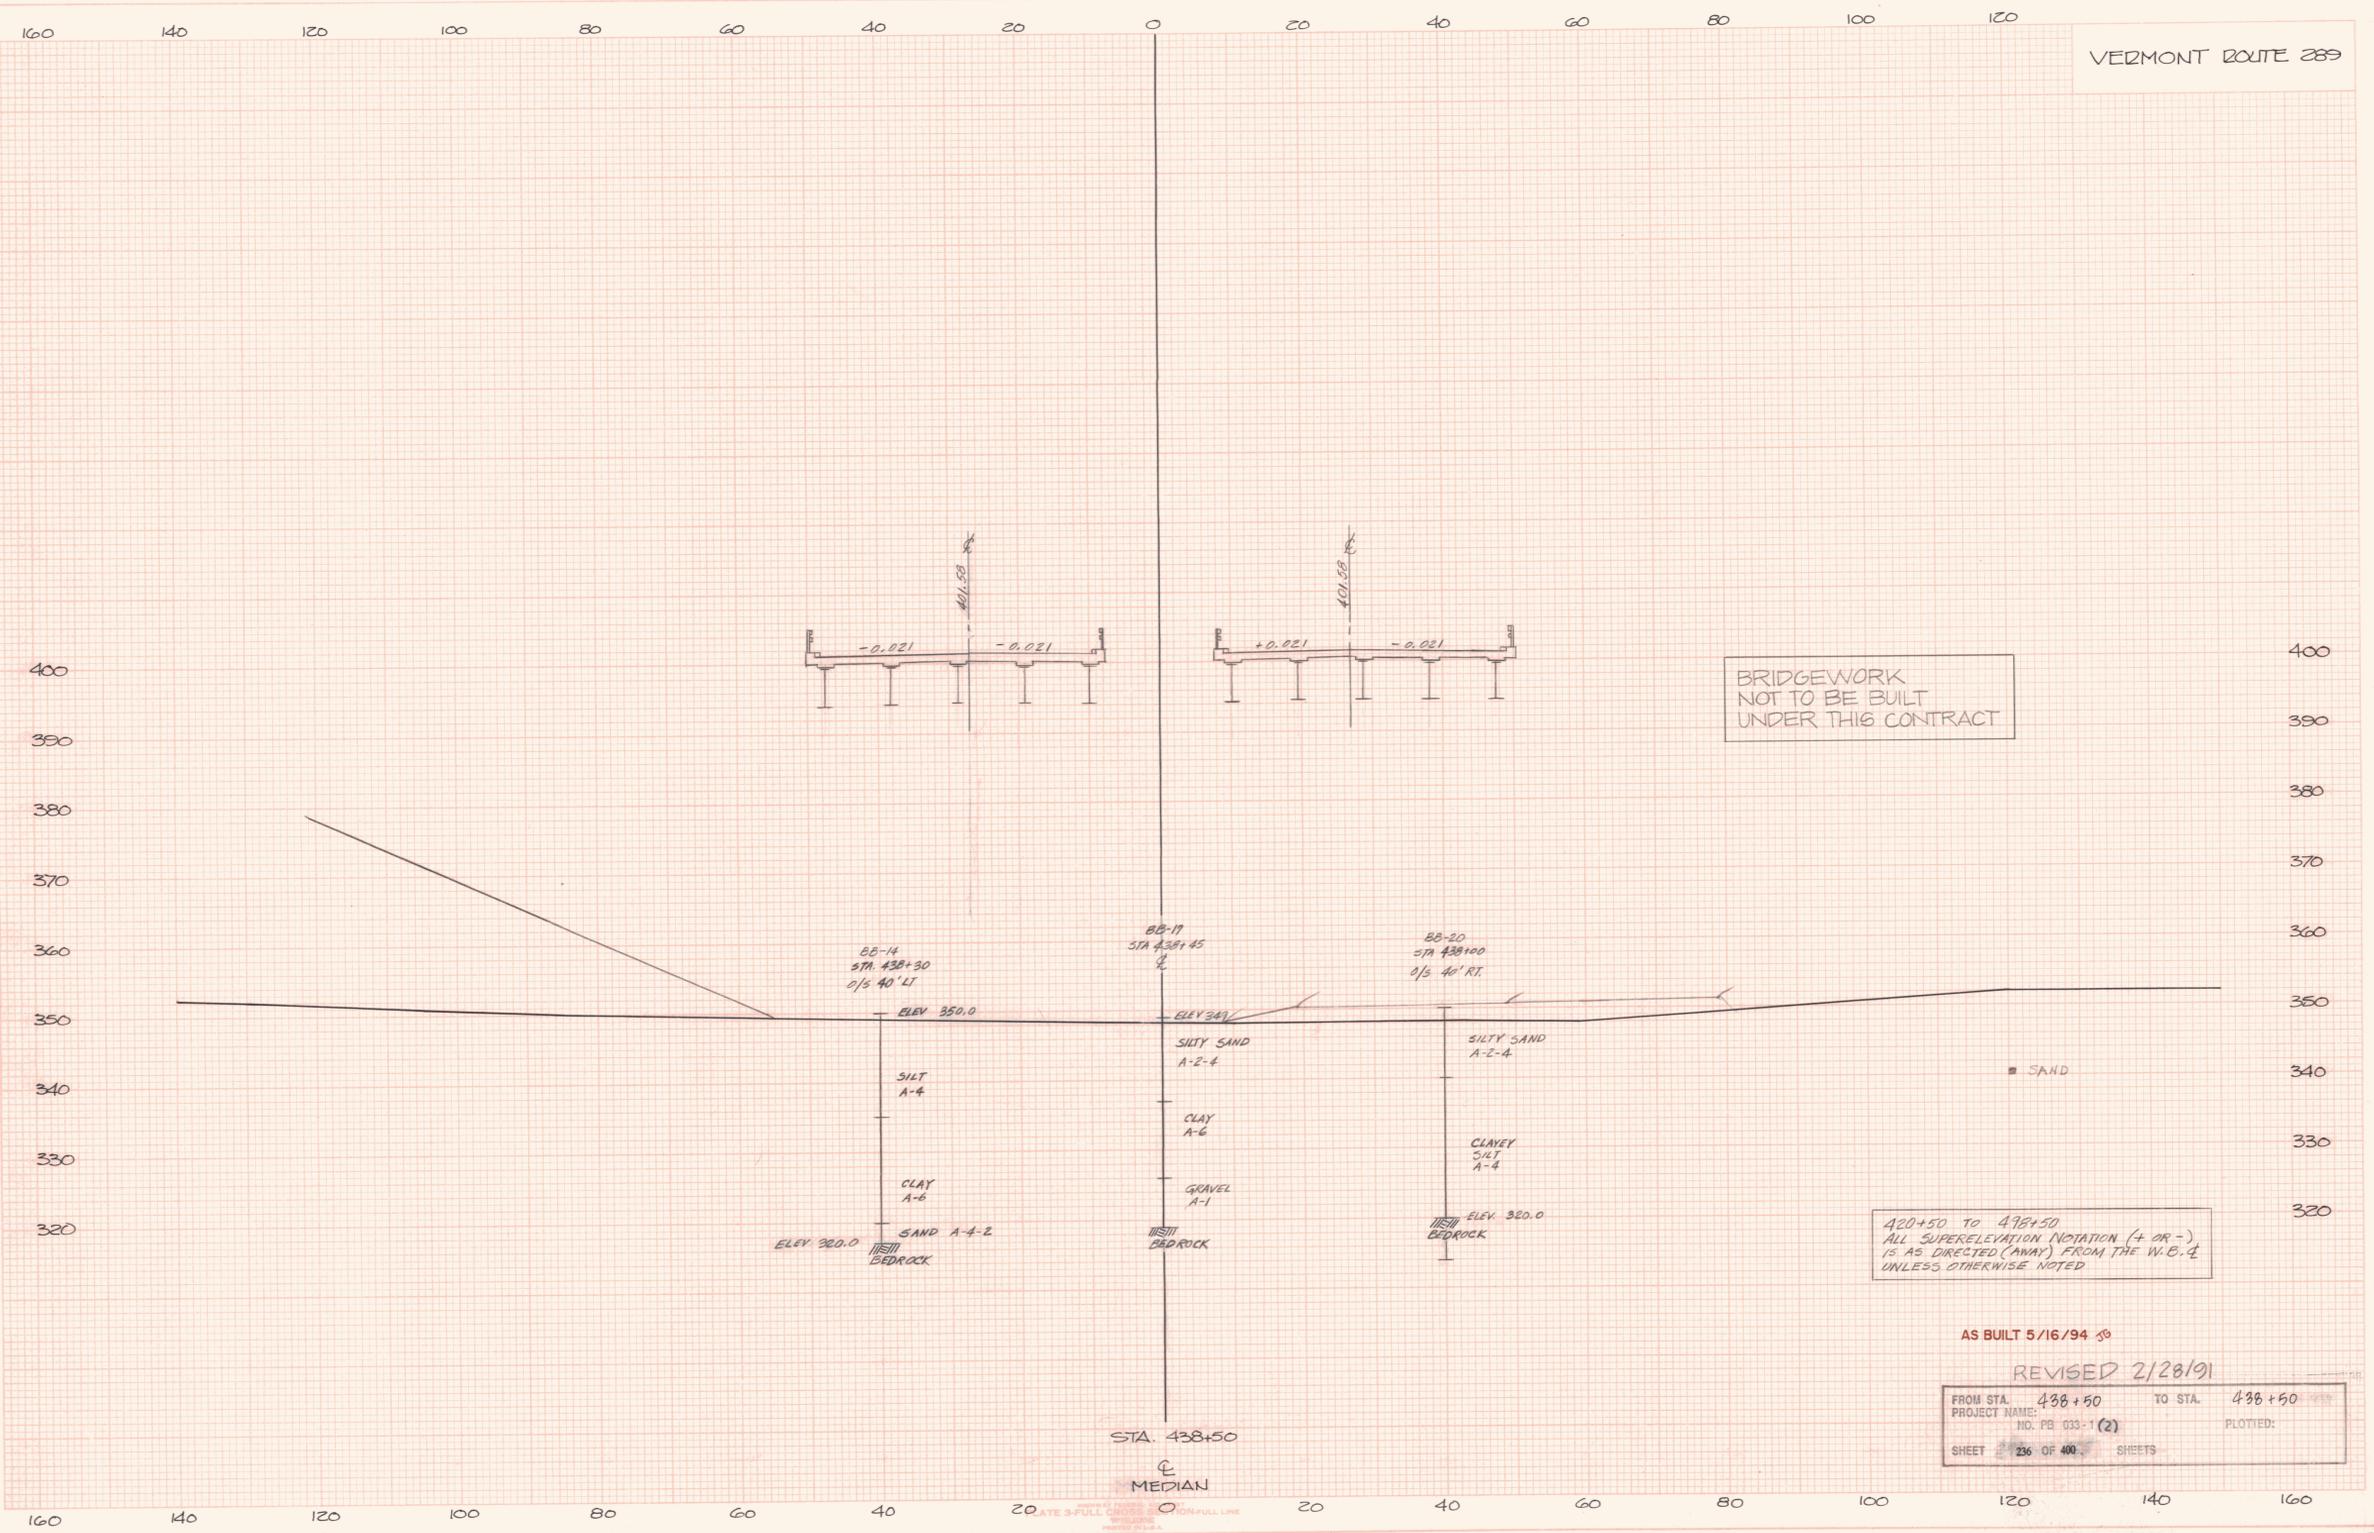

420+50 TO 498+50
 ALL SUPERELEVATION NOTATION (+ OR -)
 IS AS DIRECTED (AWAY) FROM THE W.B. &
 UNLESS OTHERWISE NOTED

AS BUILT 5/16/94

REVISED 2/28/91

FROM STA.	438+50	TO STA.	438+50
PROJECT NAME:			
NO. PG.	033-1 (2)	PLOTTED:	
SHEET	236 OF 400	SHEETS	