


160 140 120 100 80 60 40 20 0 20 40 60 80 100 120

GUARD RAIL APPROACH SECTION TYPE I  
STA 439+66.43 TO 440+16.43 LT.  
STA 440+16.43 LT.  
BEGIN STEEL BEAM GUARD RAIL

GUARD RAIL APPROACH SECTION TYPE I  
STA 439+60.15 TO 440+10.15 MED. LT.  
STA 440+10.15 MED. LT.  
BEGIN STEEL BEAM GUARD RAIL


GUARD RAIL APPROACH SECTION TYPE II  
STA 439+65.54 TO 439+78.04 MED. RT.  
STA 439+78.04 MED. RT.  
BEGIN STEEL BEAM GUARD RAIL  
STA 439+71.50  
END STRUCTURE # 5  
RESUME ROADWAY

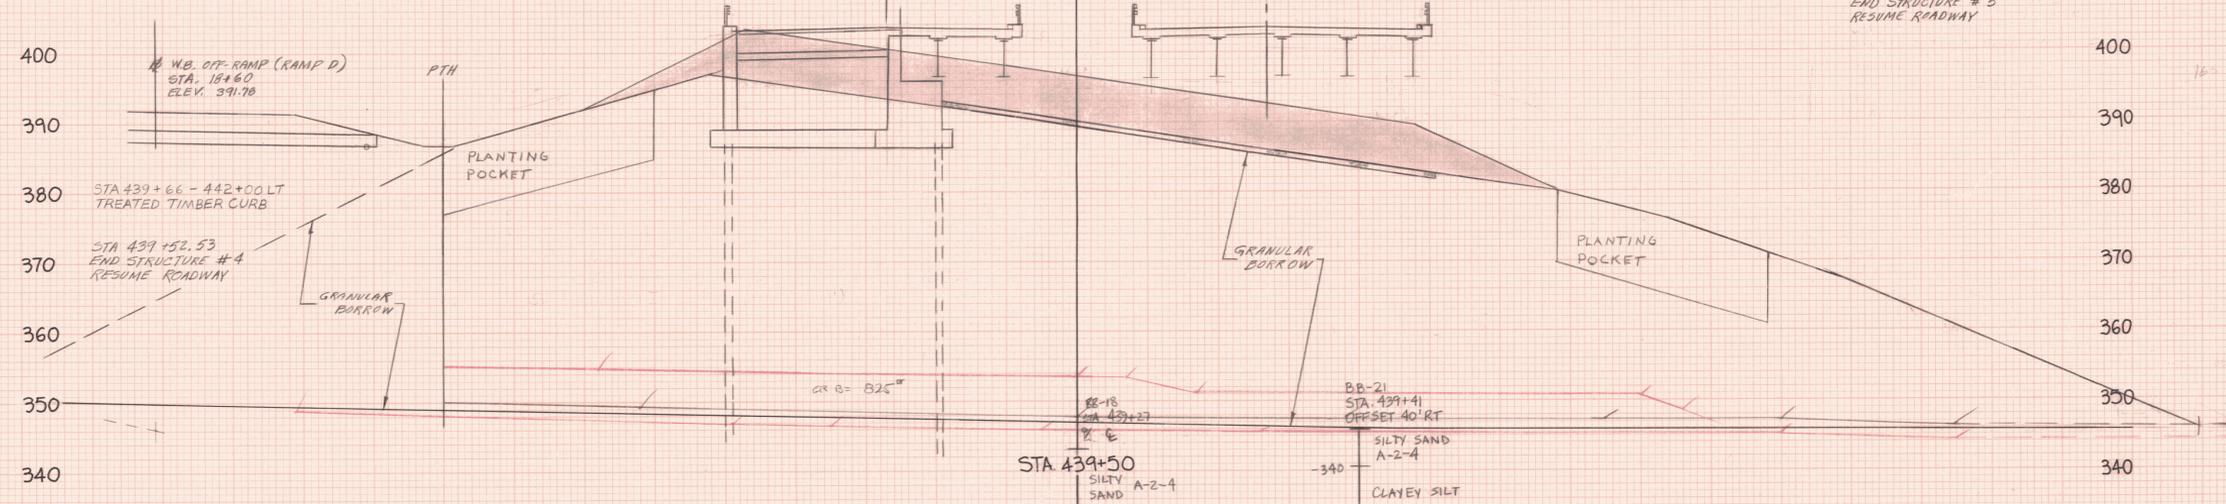

PLANTING POCKET  
STA 439+00 TO 442+25 LT  
OFFSET 60' TO 90' LEFT (STA 439+00)  
OFFSET 60' TO 75' LEFT (STA 442+25)

PLANTING POCKET  
STA 439+25 TO 441+75 RT  
OFFSET 70' TO 100' RT (STA 439+25)  
OFFSET 55' TO 80' RT (STA 441+75)

BRIDGEWORK  
NOT TO BE BUILT  
UNDER THIS CONTRACT

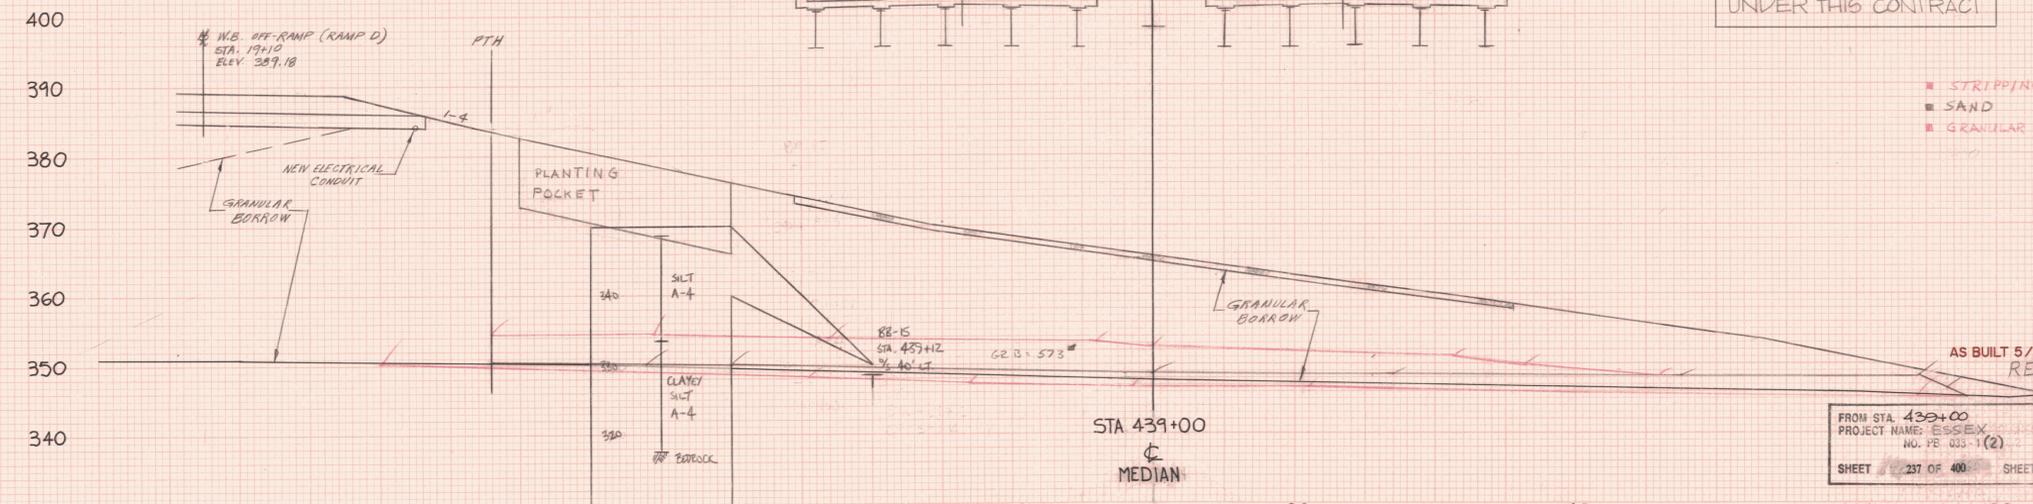

- STRIPPING
- SAND
- GRANULAR BORROW

FROM STA. 439+00 TO STA. 439+50  
PROJECT NAME: ESSEX  
NO. PE 033-1(2) PLOTTED:  
SHEET 237 OF 400 SHEETS

DATE: \_\_\_\_\_  
BY: \_\_\_\_\_  
CHECKED: \_\_\_\_\_  
APPROVED: \_\_\_\_\_  
NO. \_\_\_\_\_  
DATE: \_\_\_\_\_

DATE: \_\_\_\_\_  
BY: \_\_\_\_\_  
CHECKED: \_\_\_\_\_  
APPROVED: \_\_\_\_\_  
NO. \_\_\_\_\_  
DATE: \_\_\_\_\_