


VERMONT ROUTE 289

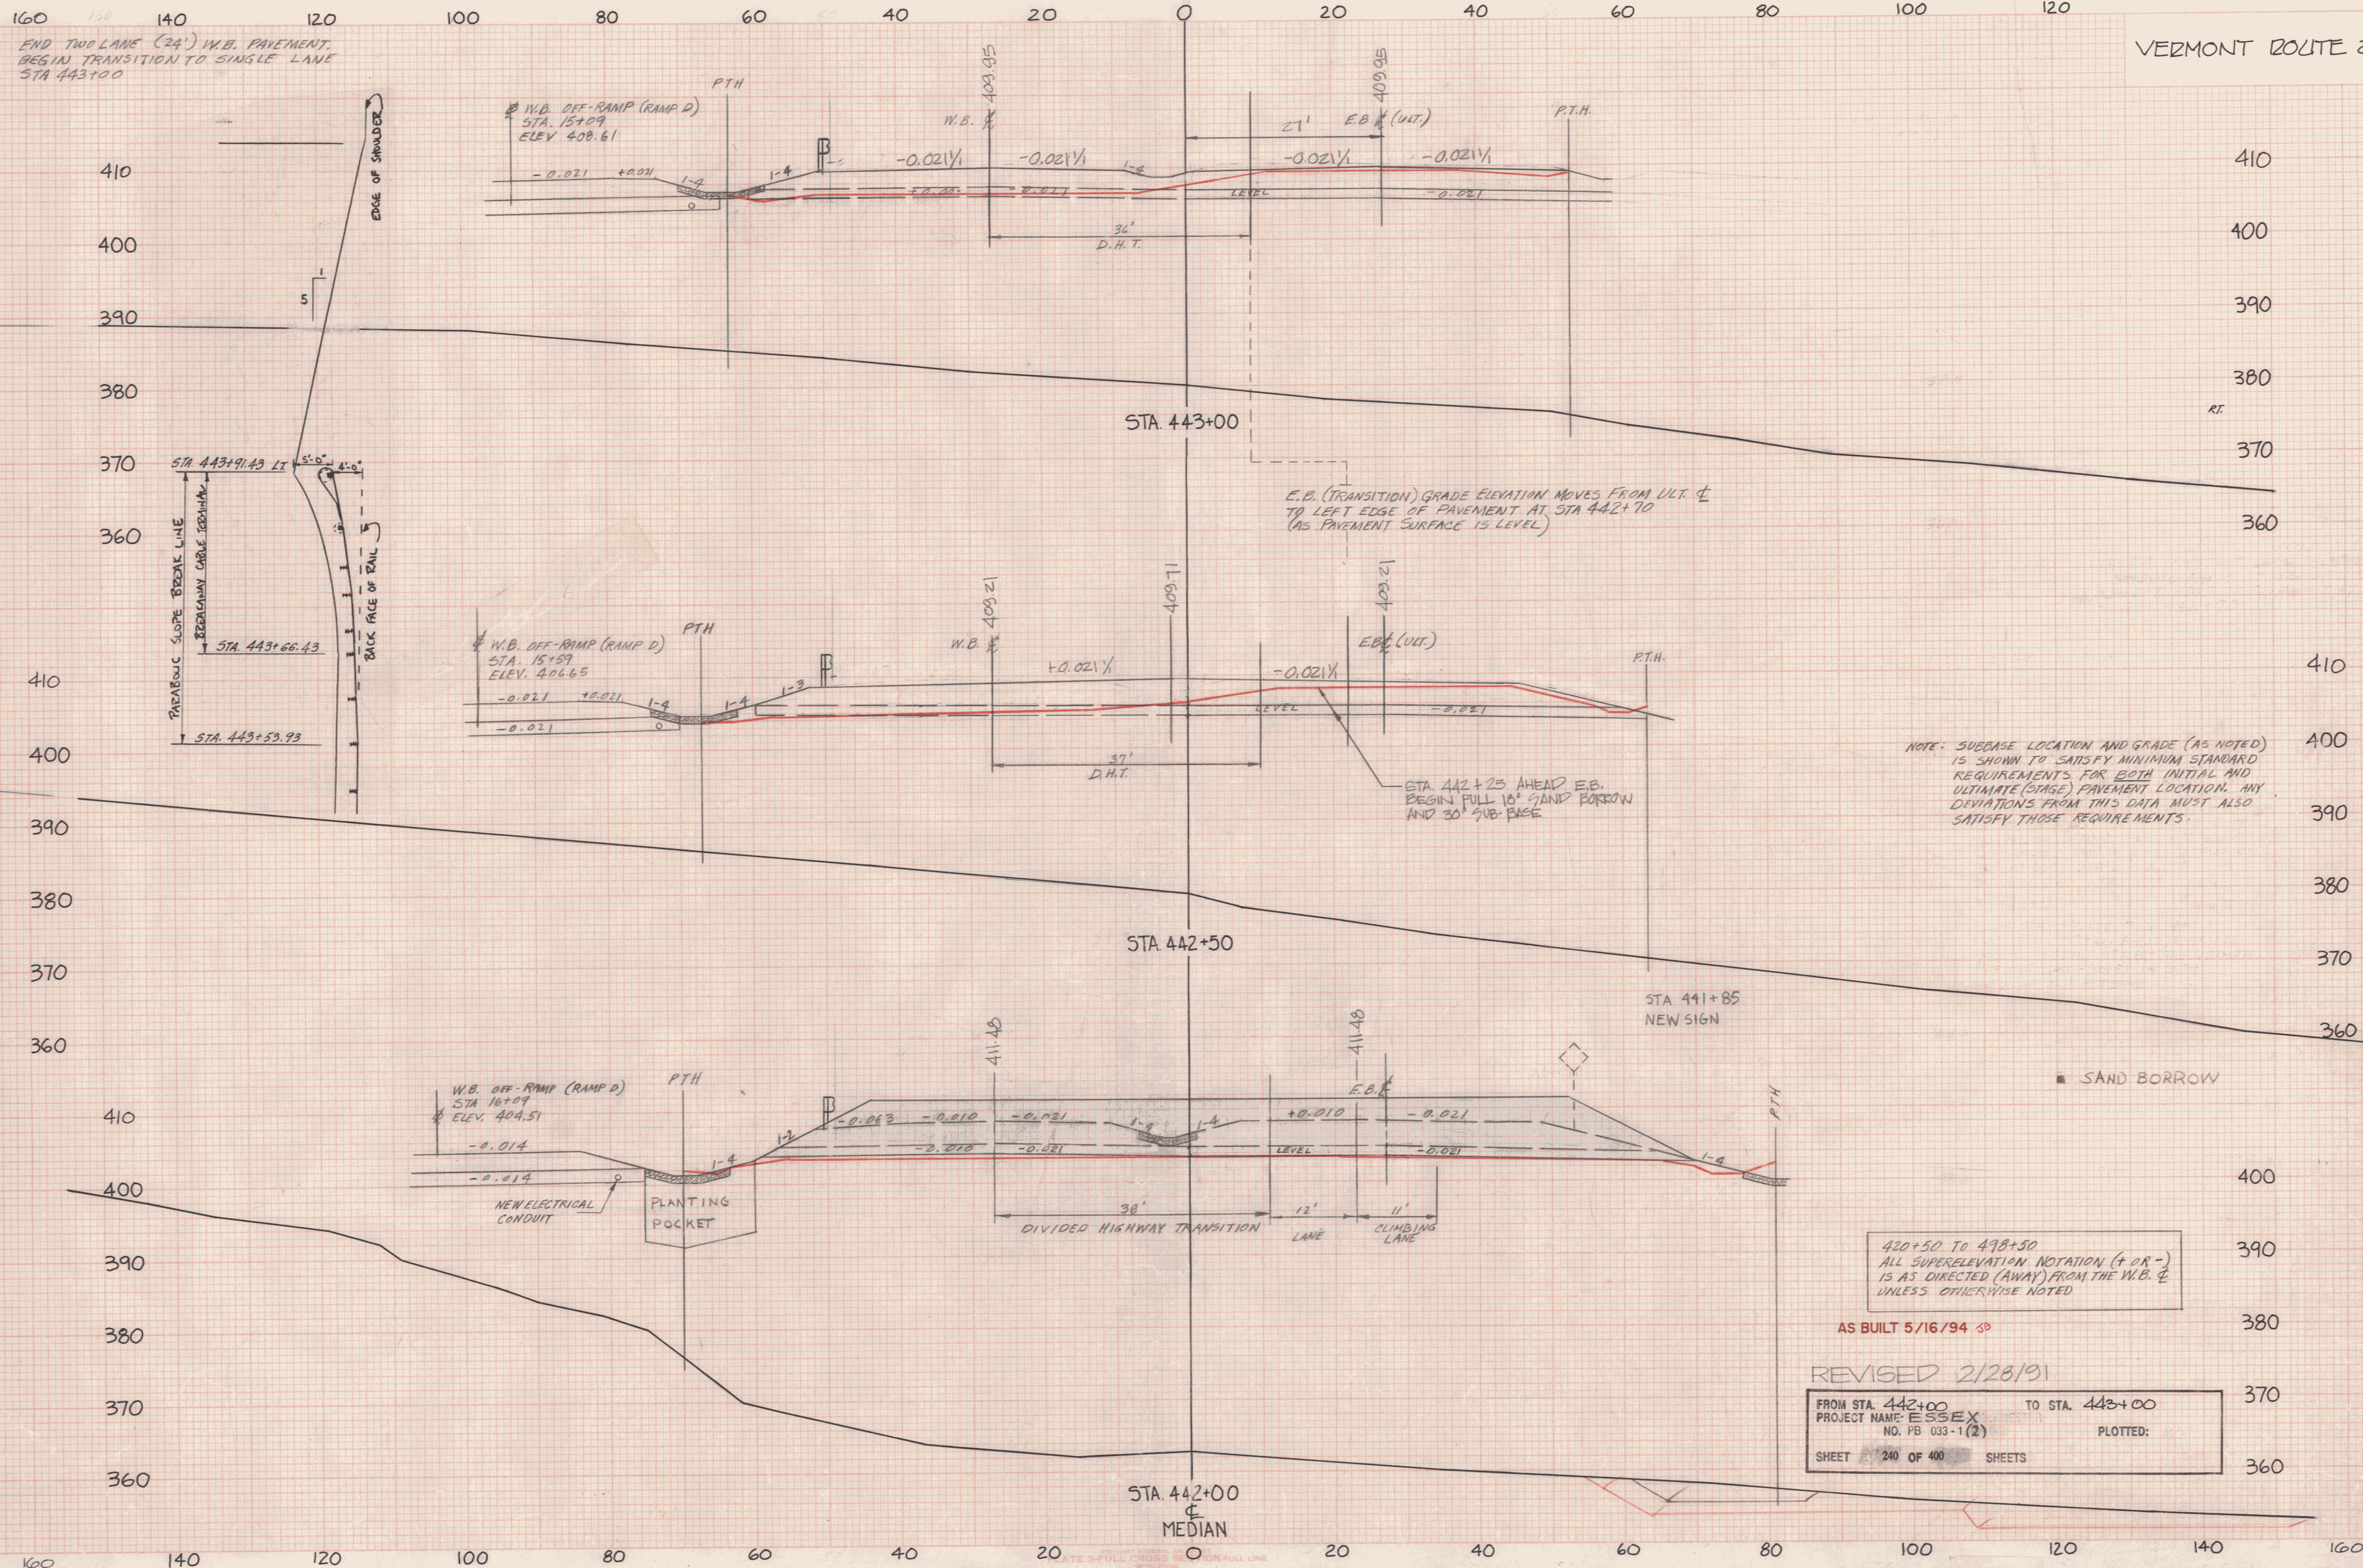

NOTE: SUBBASE LOCATION AND GRADE (AS NOTED) IS SHOWN TO SATISFY MINIMUM STANDARD REQUIREMENTS FOR BOTH INITIAL AND ULTIMATE (STAGE) PAVEMENT LOCATION. ANY DEVIATIONS FROM THIS DATA MUST ALSO SATISFY THOSE REQUIREMENTS.

420+50 TO 498+50
ALL SUPERELEVATION NOTATION (+ OR -)
IS AS DIRECTED (AWAY) FROM THE W.B. E
UNLESS OTHERWISE NOTED

AS BUILT 5/16/94 39

REVISED 2/28/91

FROM STA. 442+00 TO STA. 443+00
PROJECT NAME: ESSEX
NO. PB 033-1 (2)
SHEET 240 OF 400 SHEETS
PLOTTED: