


VERMONT ROUTE 289

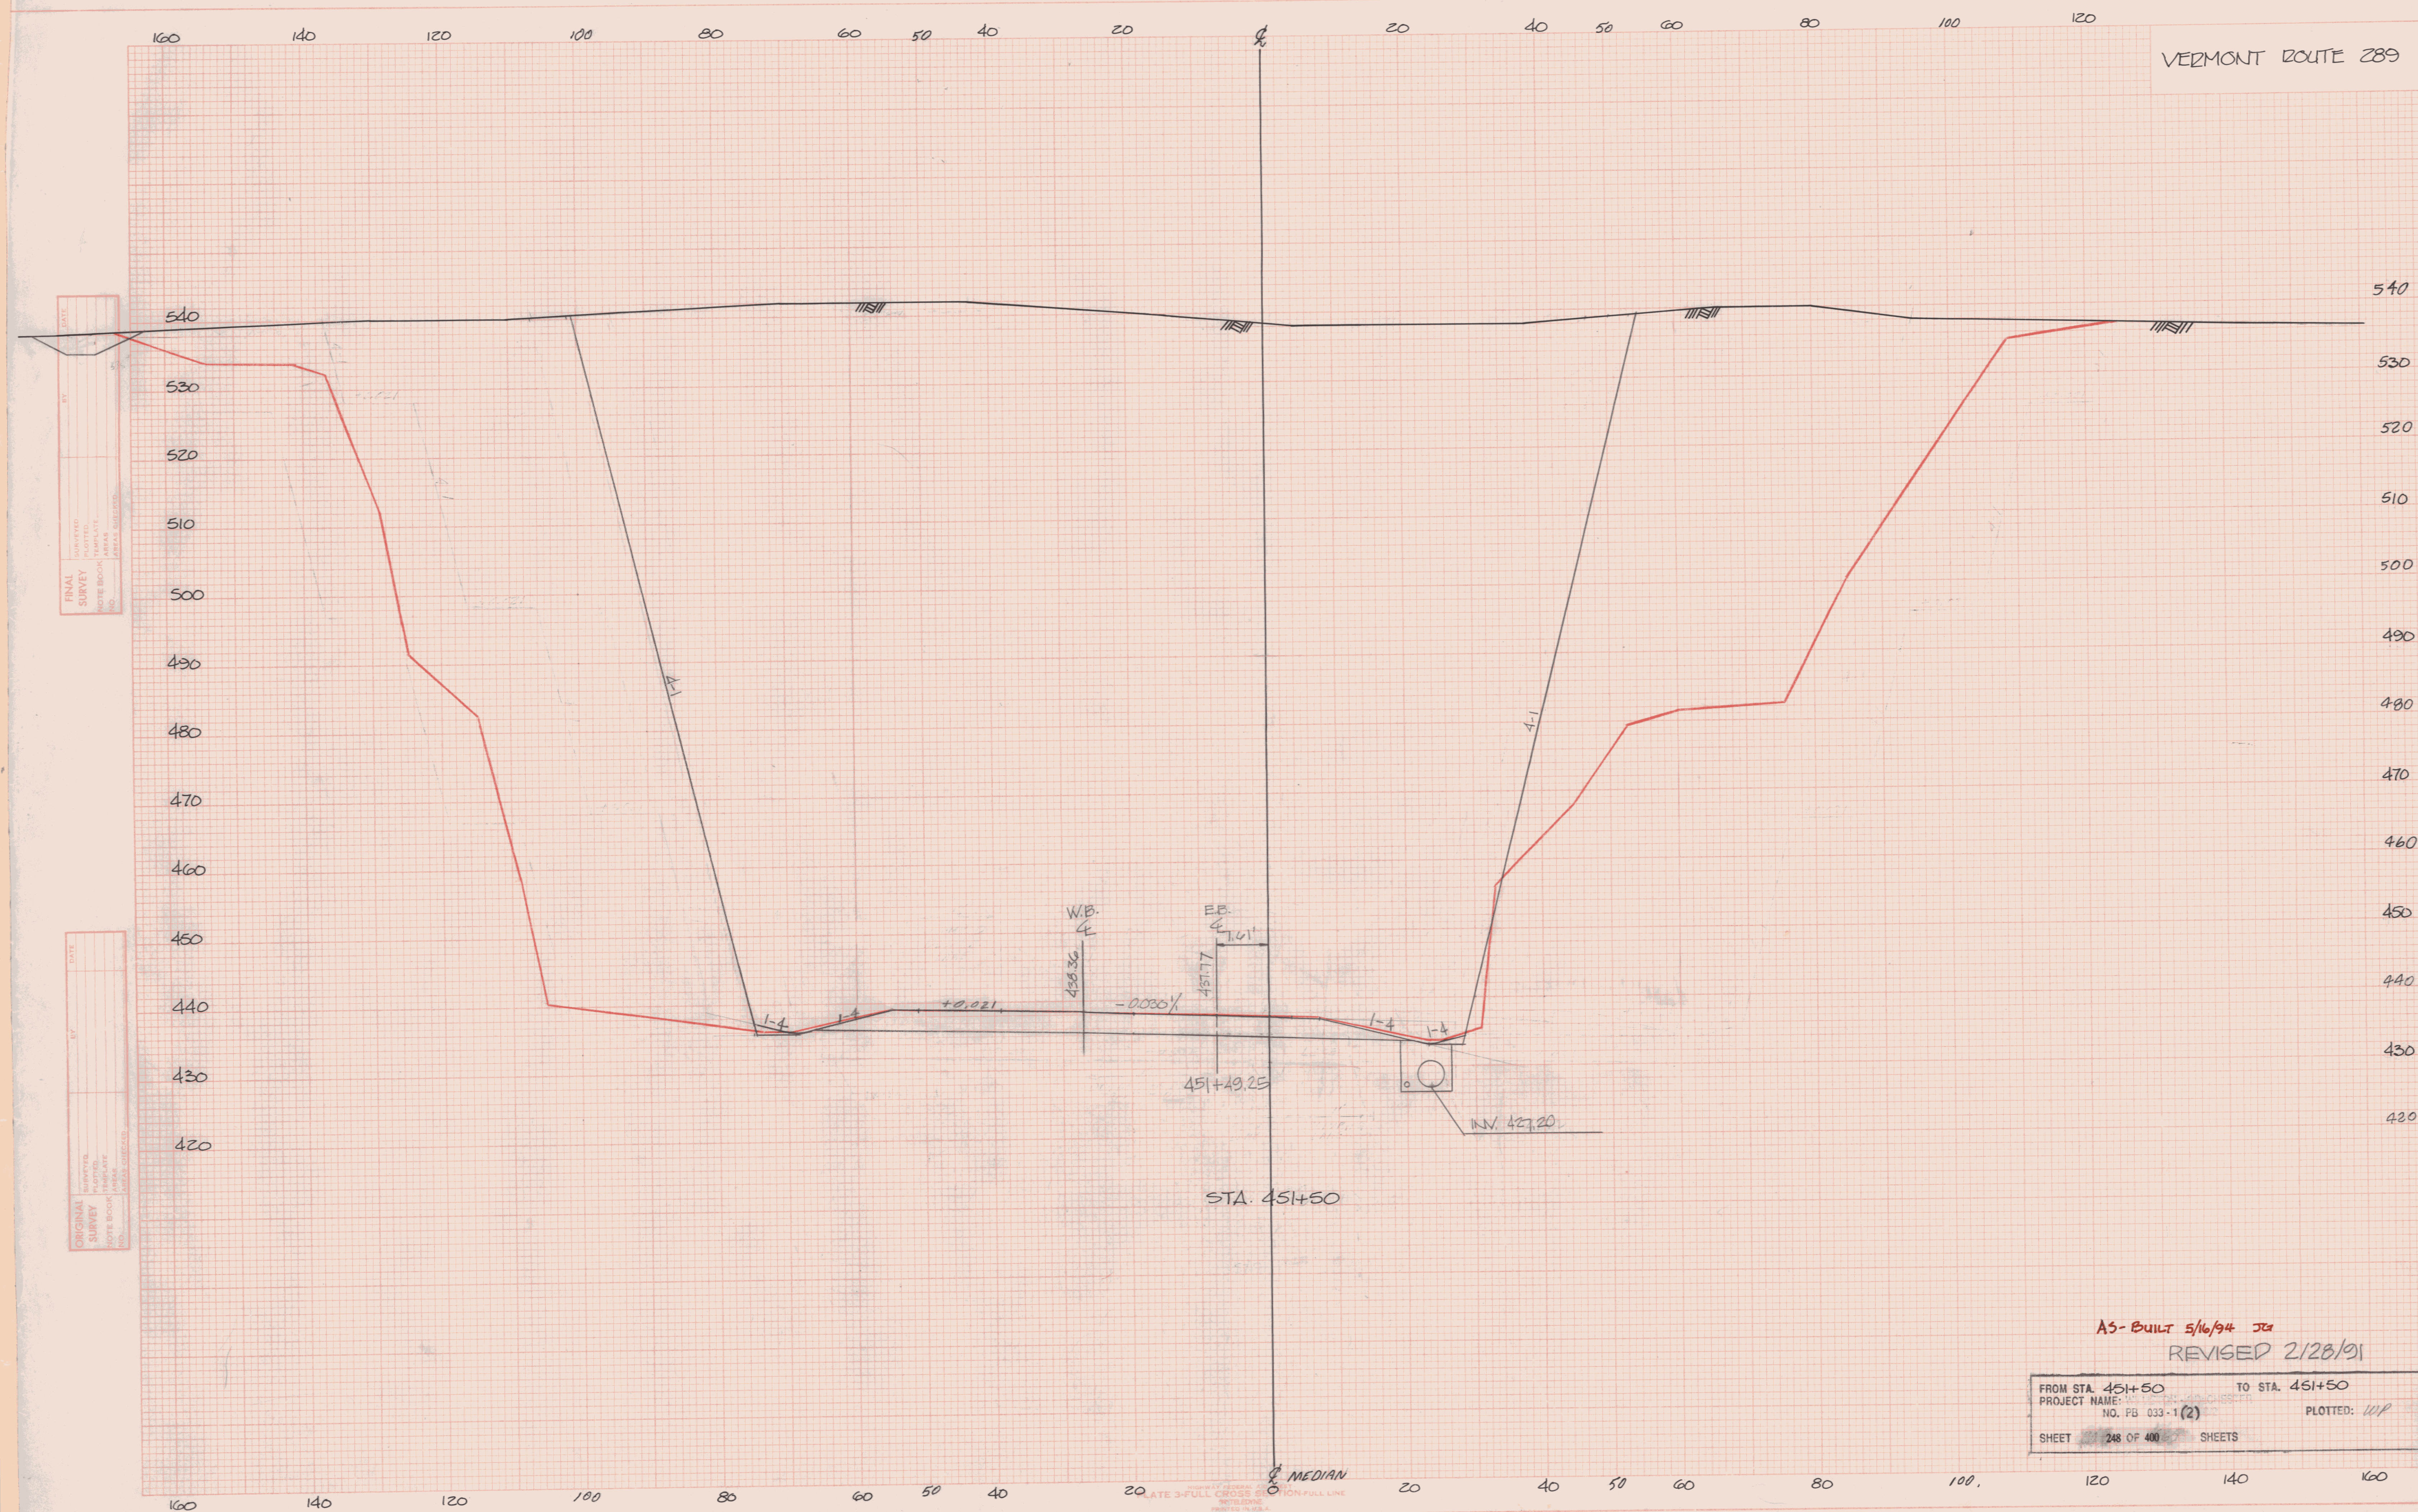

AS-BUILT 5/16/94 JG
REVISED 2/28/91

FROM STA. 451+50 TO STA. 451+50
PROJECT NAME: *W. 10th St. Interchange*
NO. PG 033-1 (2) PLOTTED: *W/P*
SHEET 248 OF 400 SHEETS