


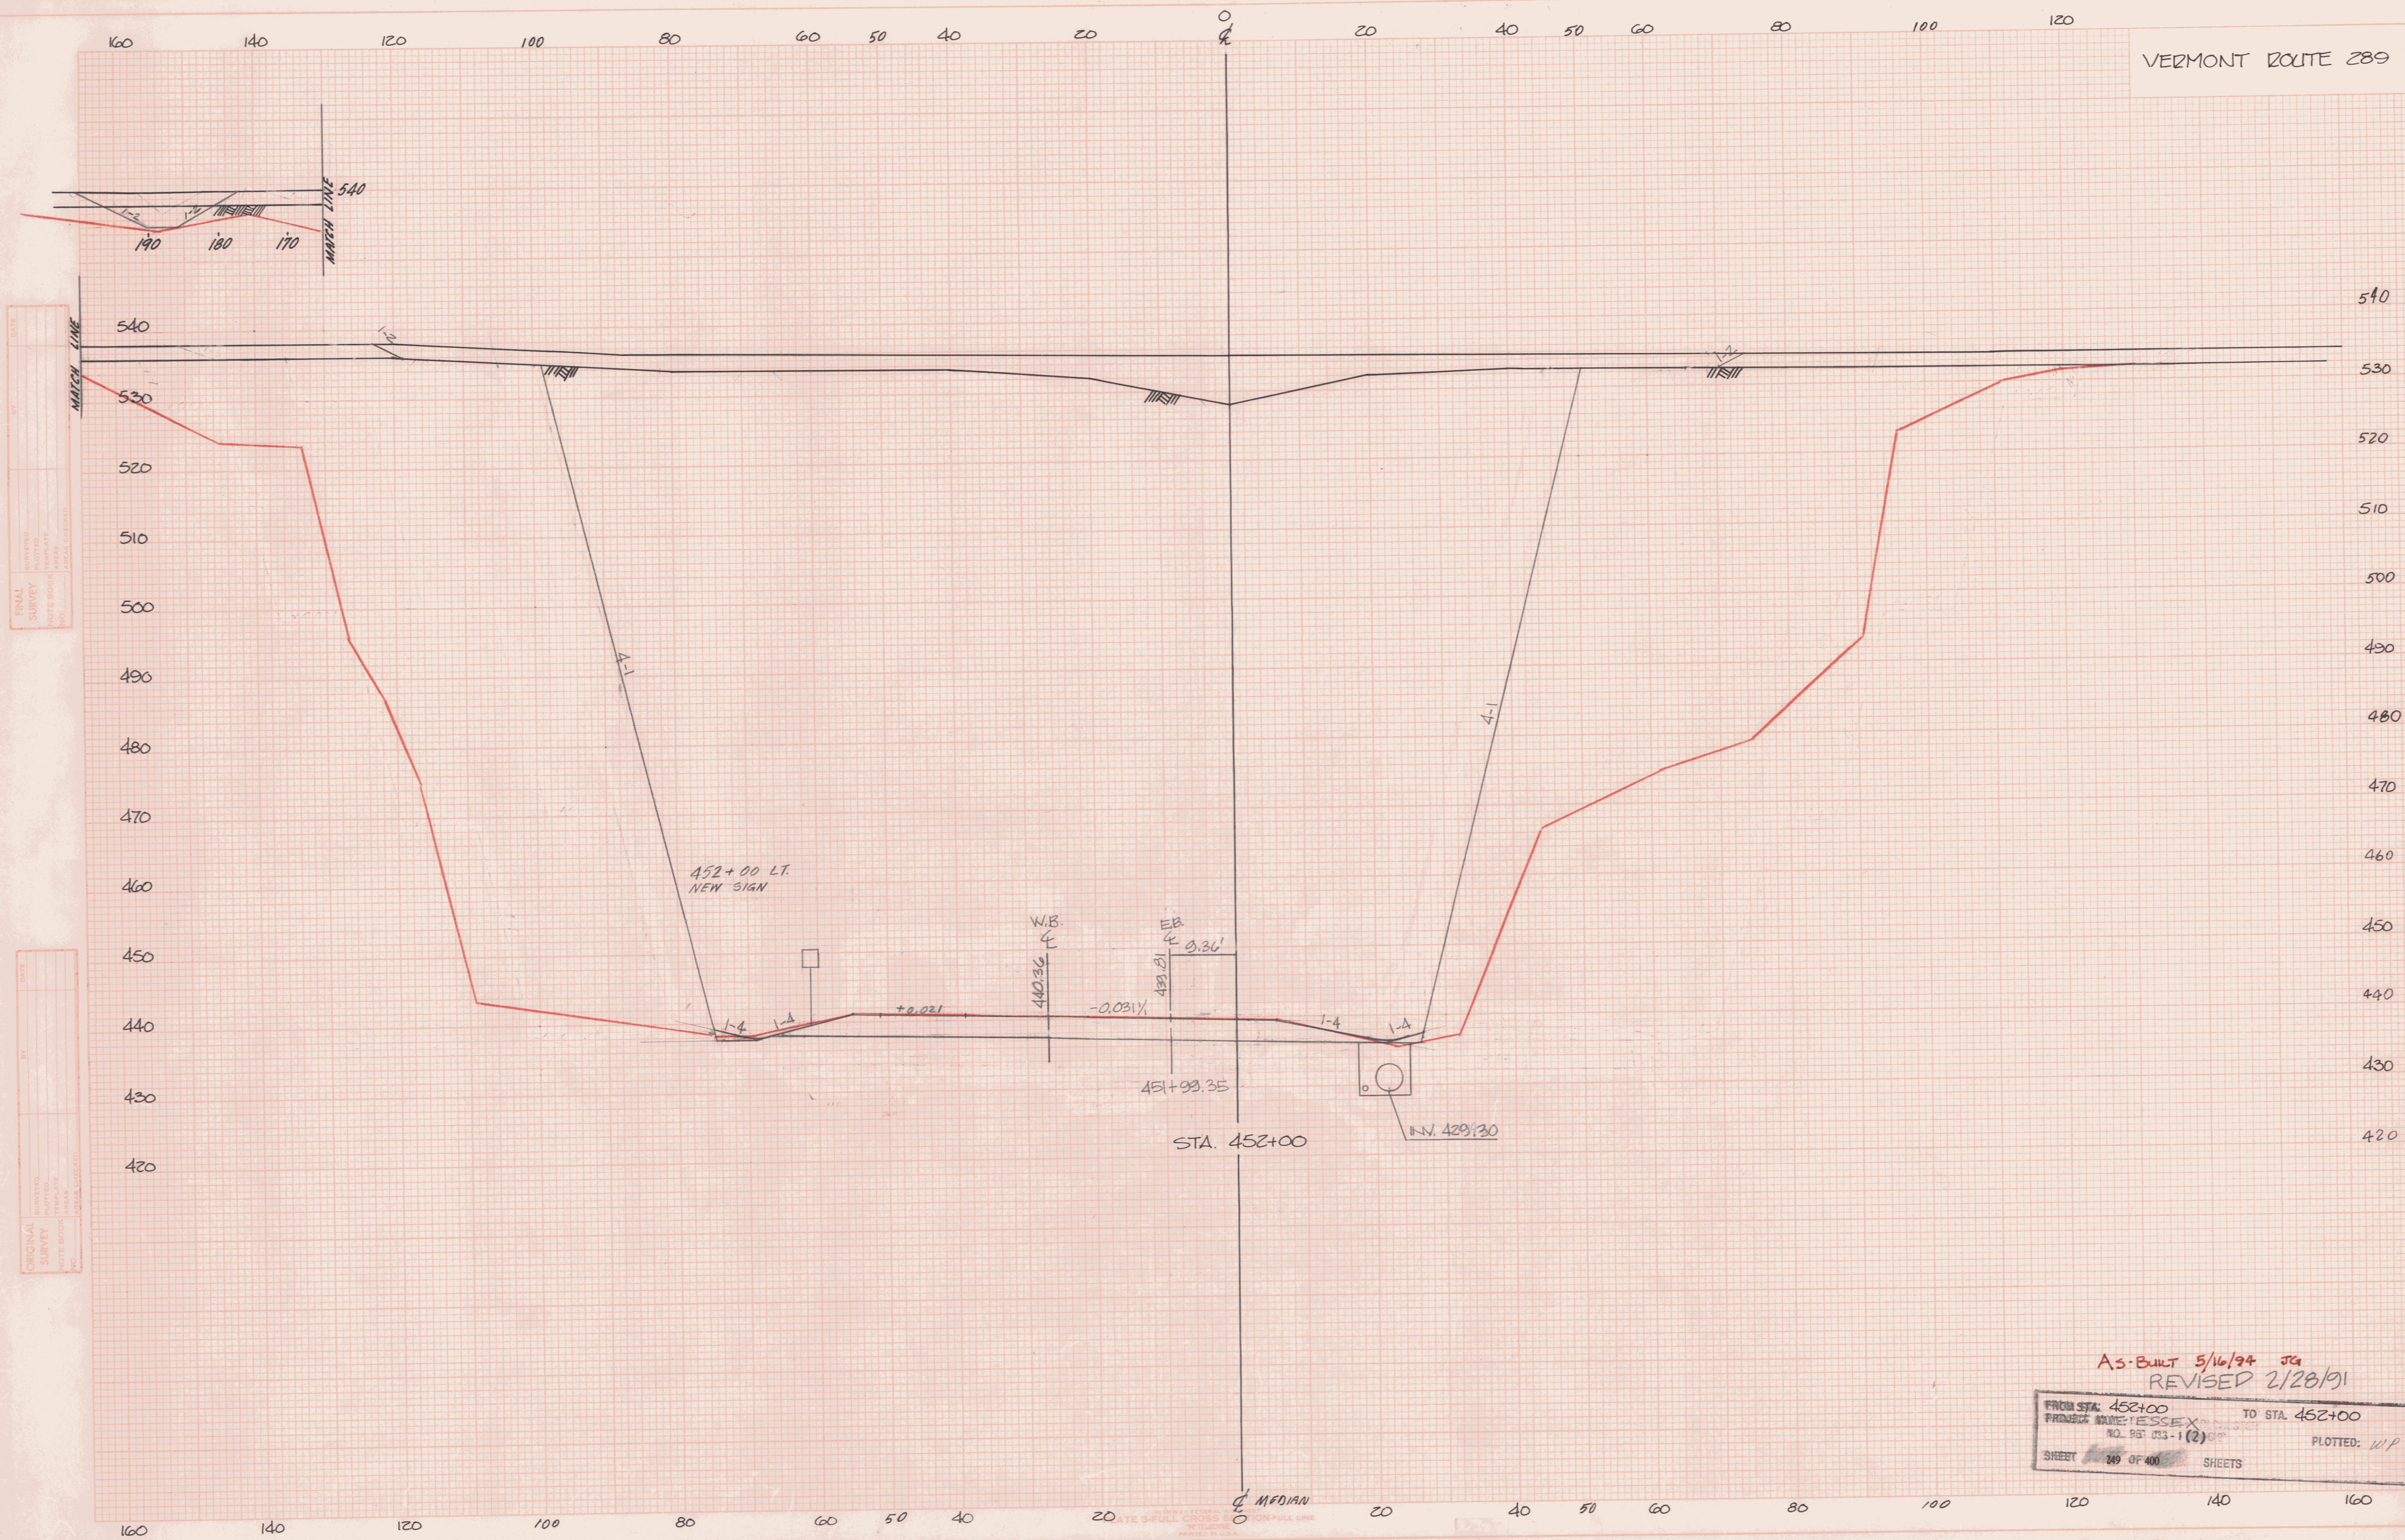

FROM STA. 452+00 TO STA. 452+00
PROJECT NAME: JESSEX
NO. 58: 033-1 (2)
SHEET 249 OF 400
PLOTTED: W/P
SHEETS

304 0-8 465