


VERMONT ROUTE 289

DATE	
BY	
CHECKED	
DESIGNED	
PLANNED	
NOTED	
NO.	

DATE	
BY	
CHECKED	
DESIGNED	
PLANNED	
NOTED	
NO.	

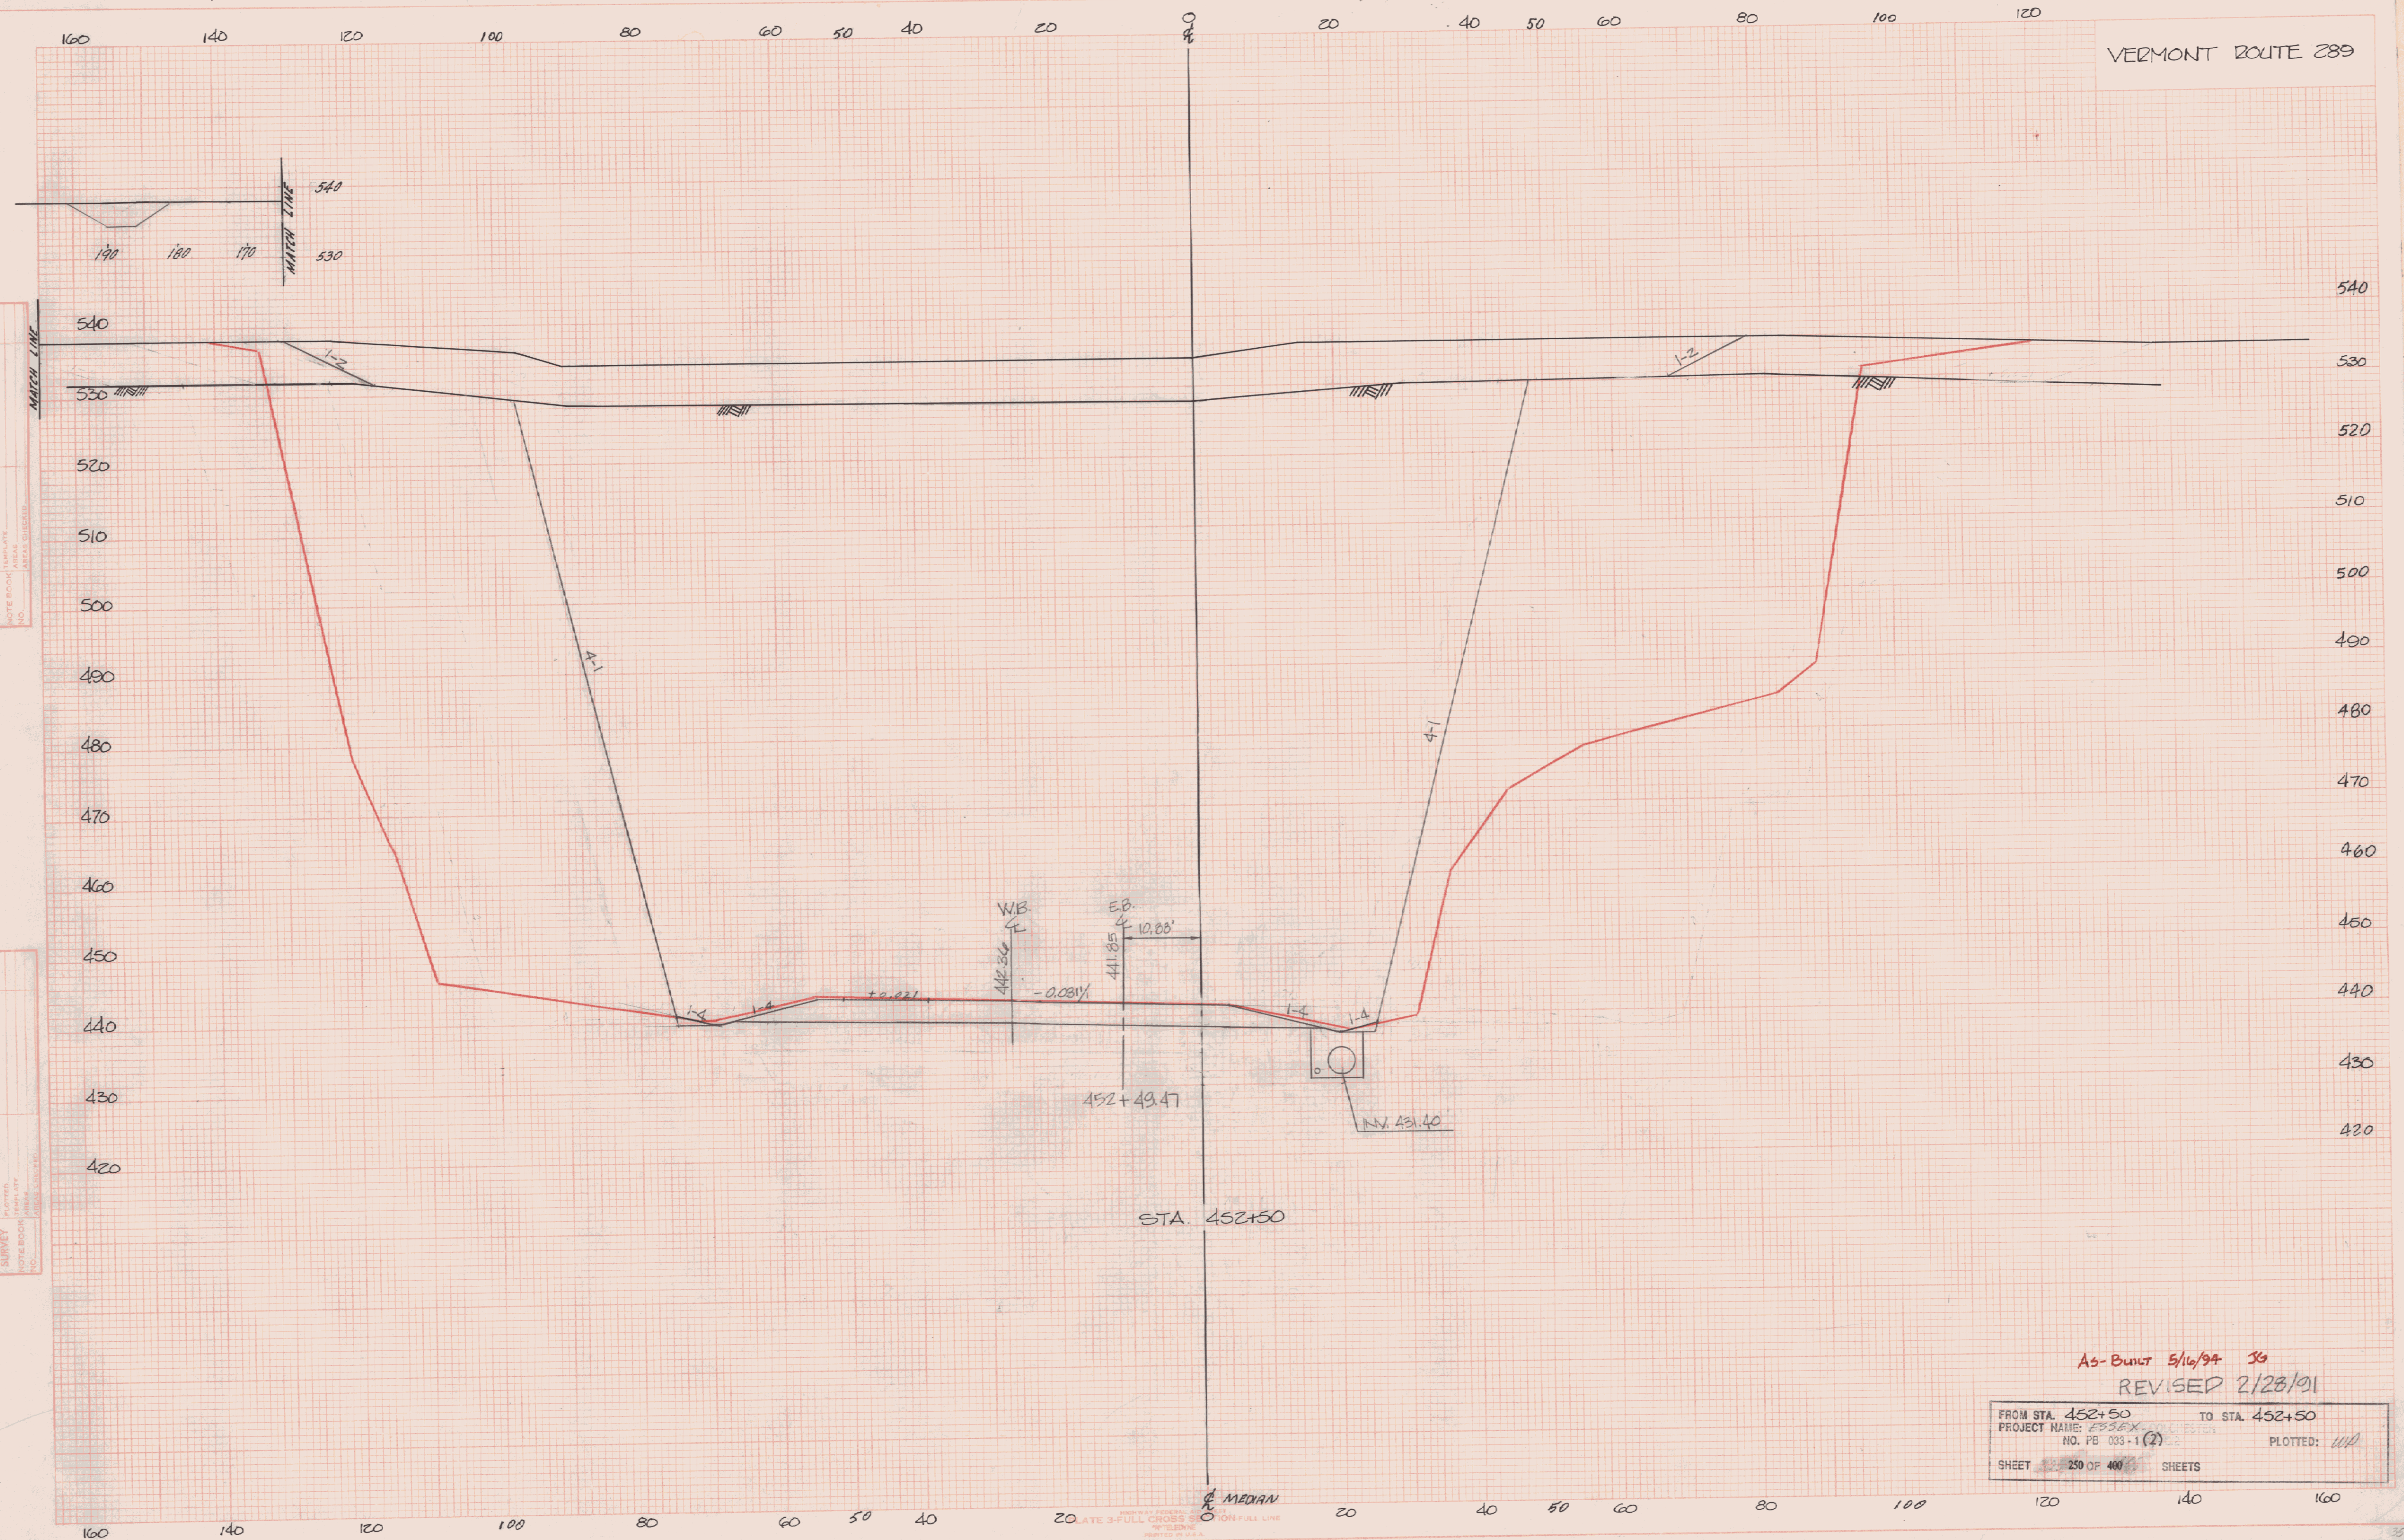

As-Built 5/16/94
REVISED 2/28/91

FROM STA. 452+50	TO STA. 452+50
PROJECT NAME: 2352X	NO. FB 033-1 (2)
SHEET 250 OF 400	SHEETS
PLOTTED: 11/11	

305 01465