


VERMONT ROUTE 289

DATE	
BY	
REVIEWED	
PLOTTED	
NOTE BOOK	
NO.	
AREA	

DATE	
BY	
REVIEWED	
PLOTTED	
NOTE BOOK	
NO.	
AREA	

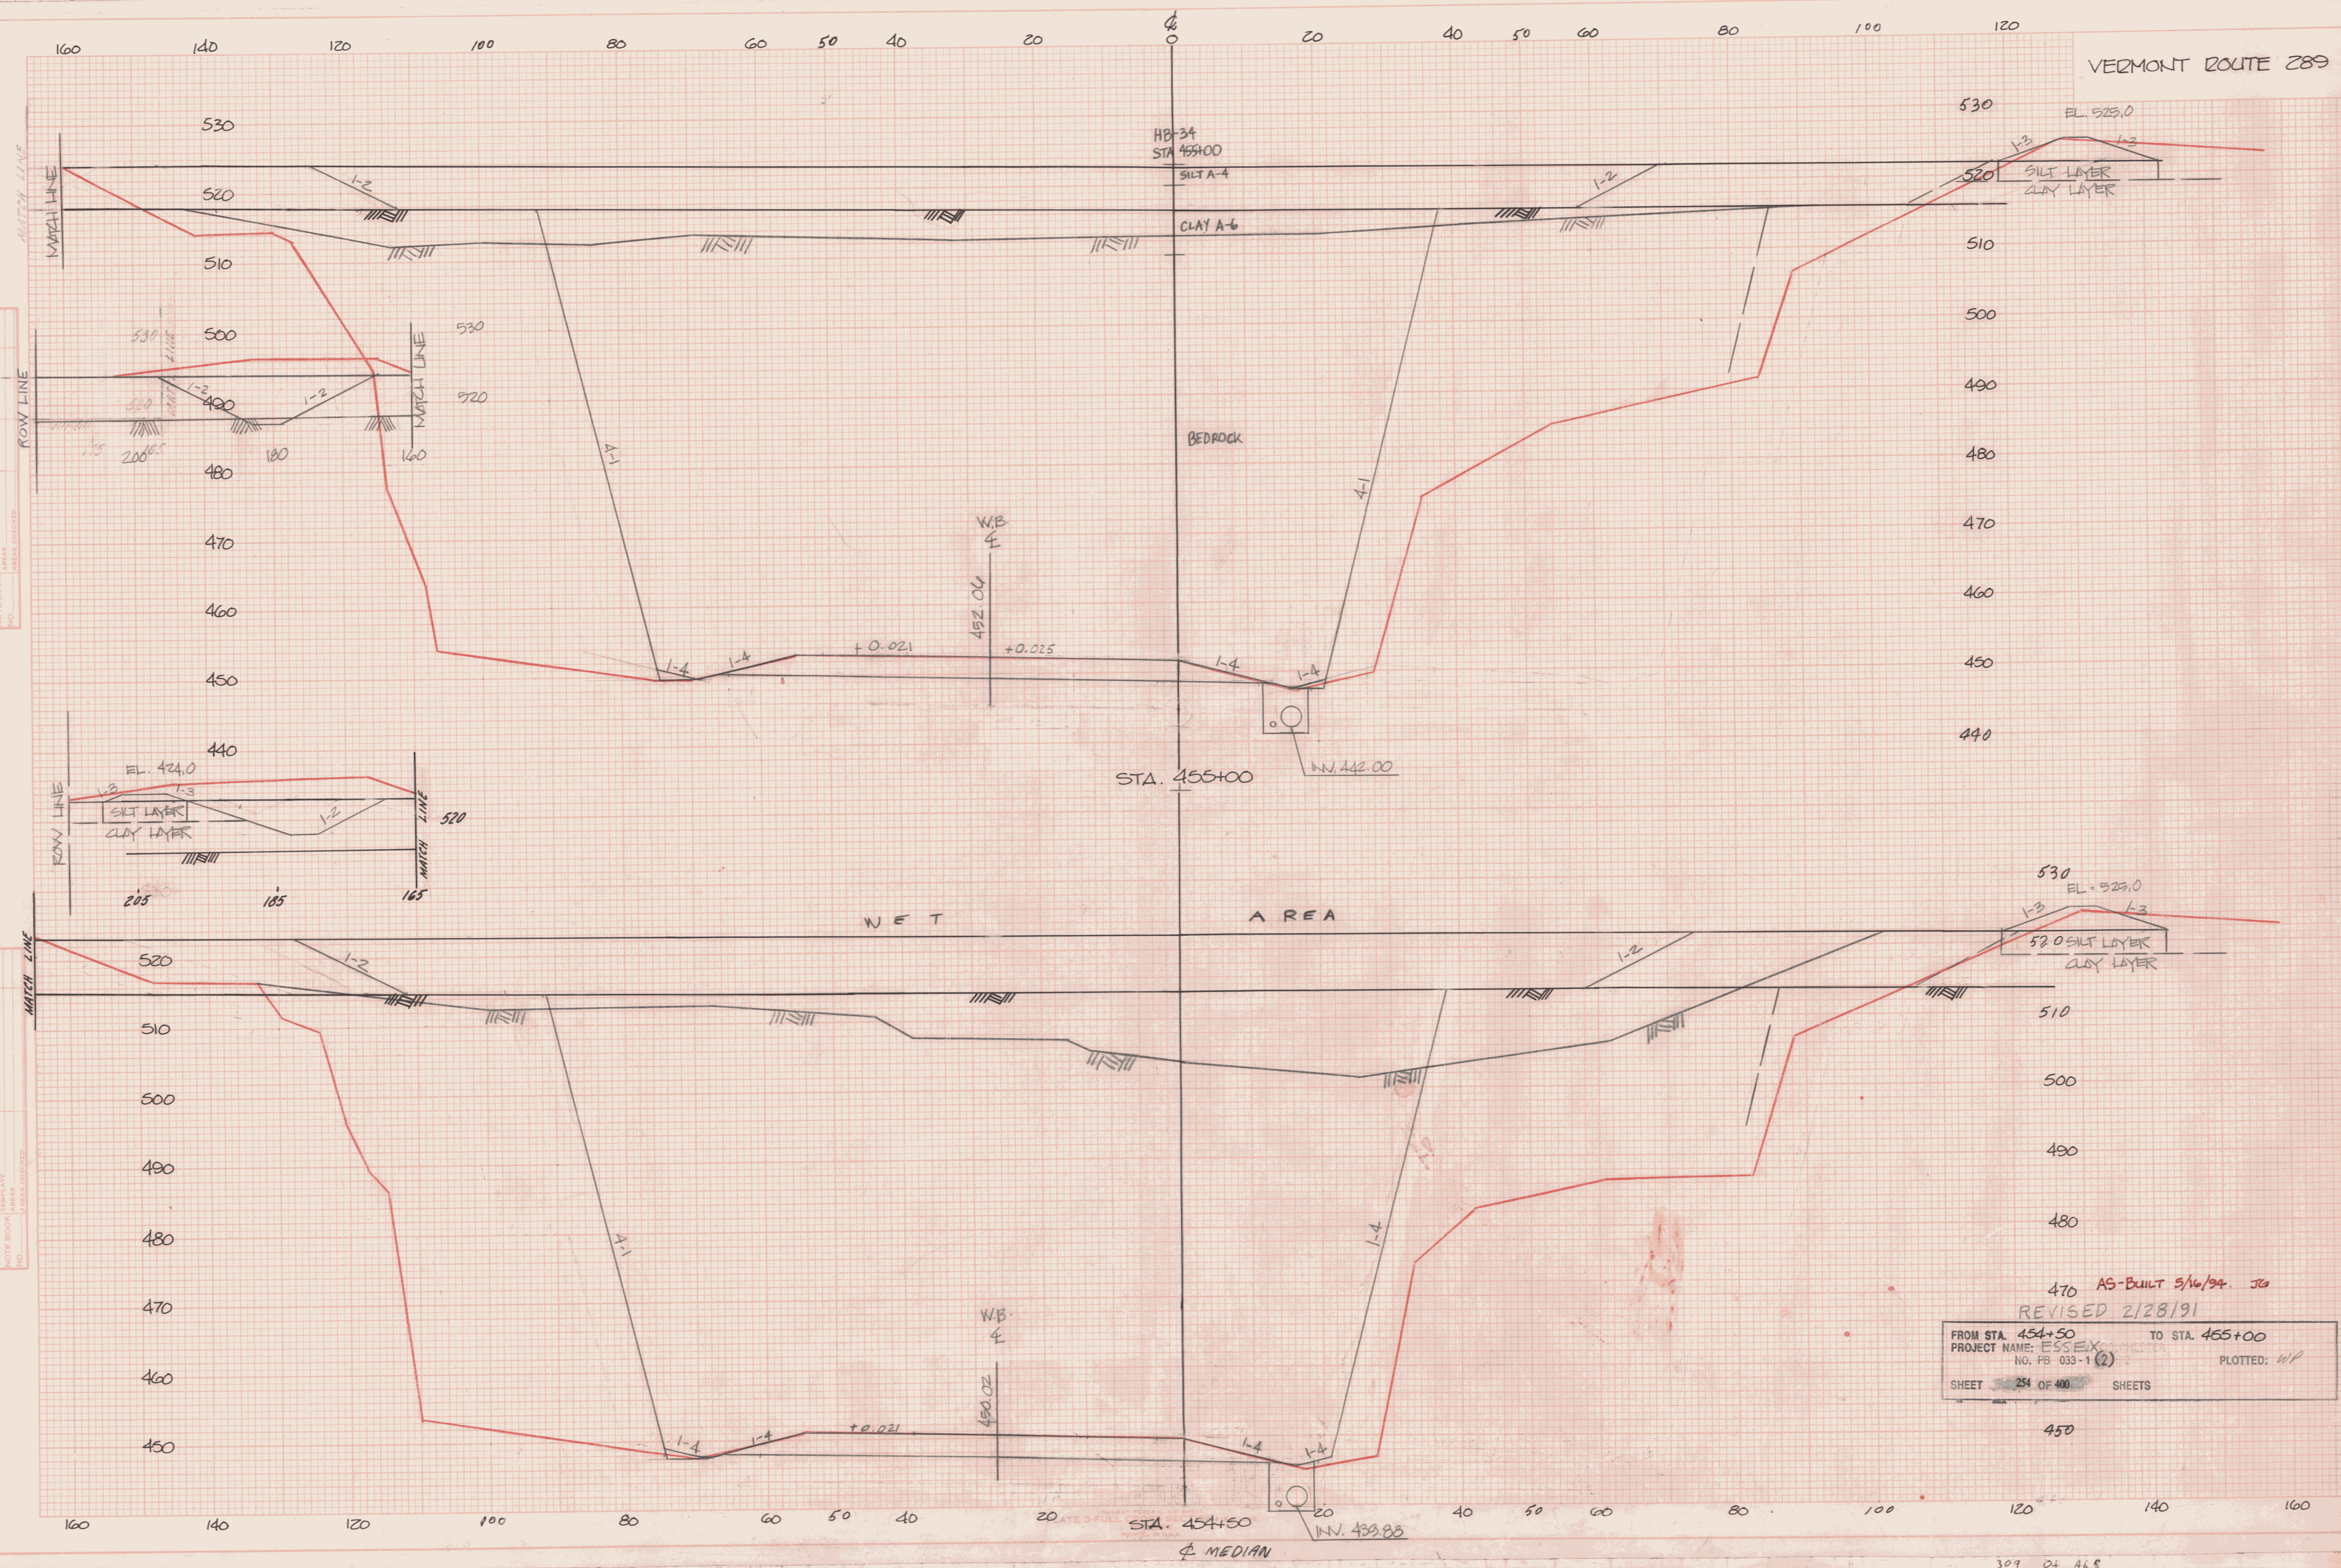

470 AS-BUILT 5/16/94. JB
REVISED 2/28/91
FROM STA. 454+50 TO STA. 455+00
PROJECT NAME: ESSEX
NO. FB 033-1 (2) PLOTTED: W/P
SHEET 254 OF 400 SHEETS