


VERMONT ROUTE 289

160 140 120 100 80 60 40 20 0 20 40 50 60 80 100 120

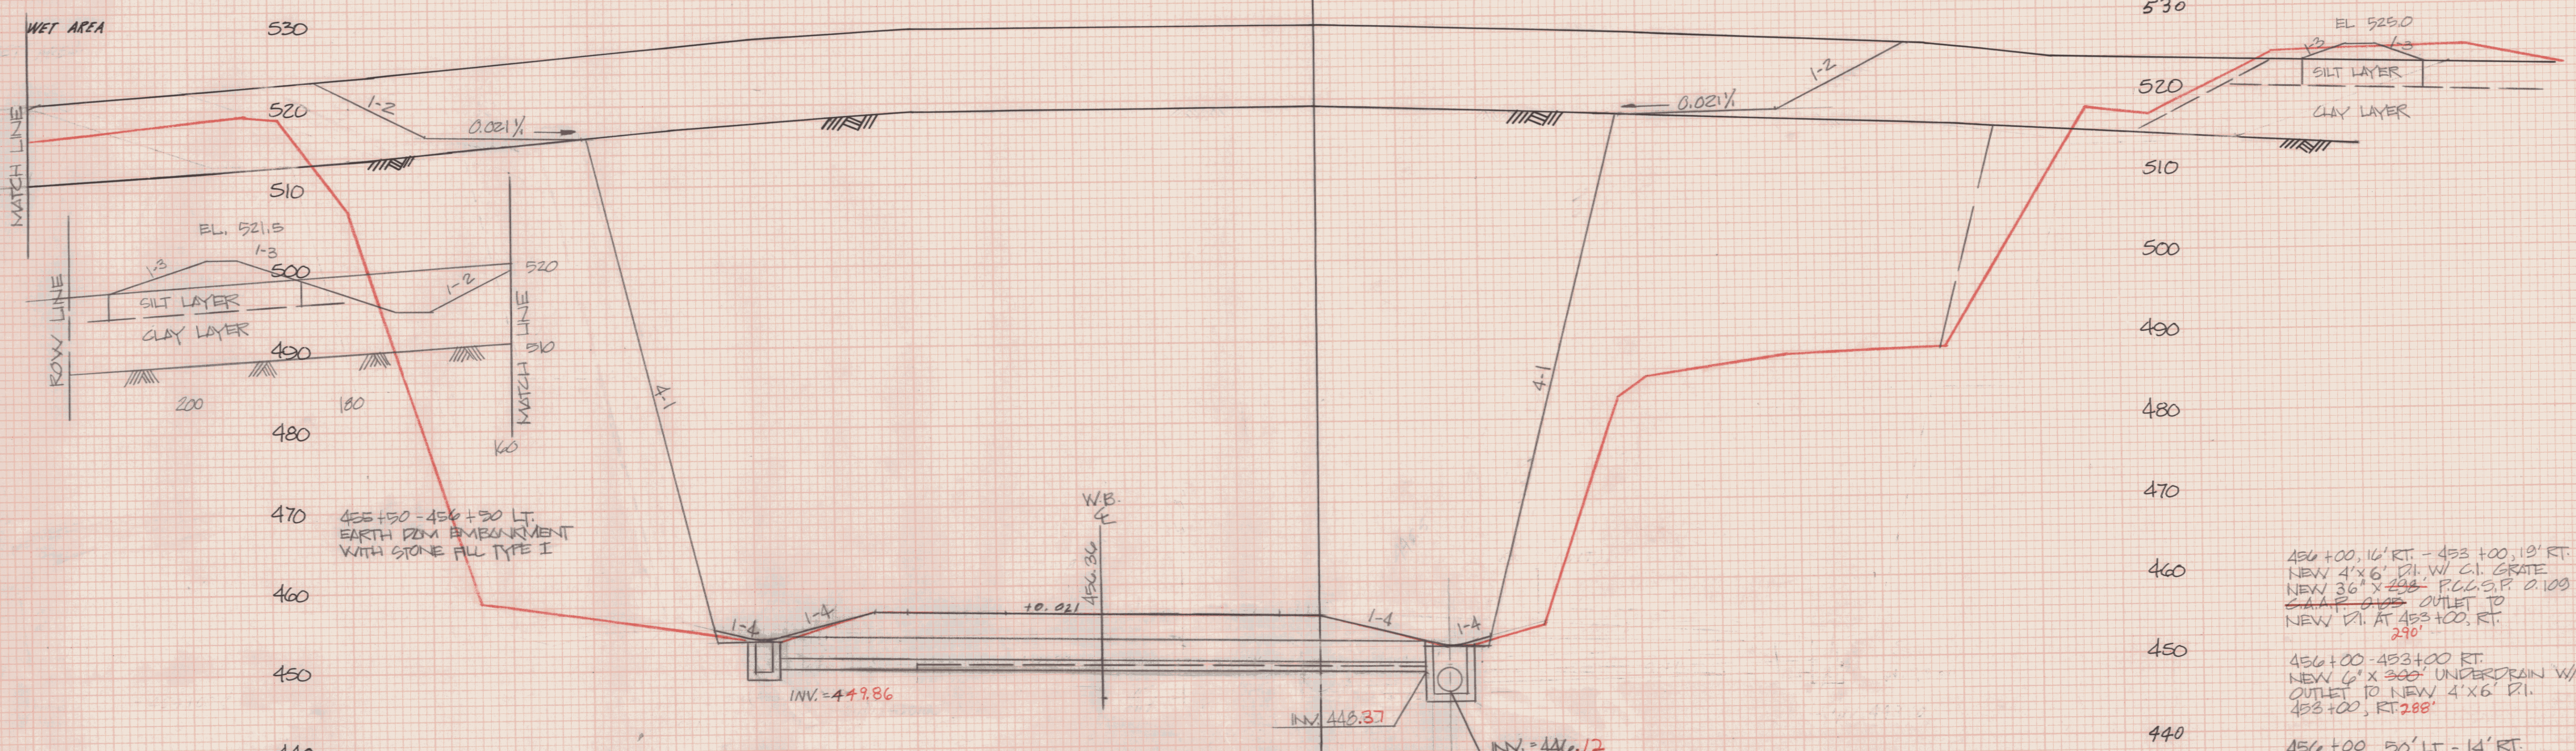

456+00, 00' LT.
NEW 14" X 14" DI W/ C.I. GRATE
NEW 18" X 24" P.C.C. SP. 0.004 OR
STARS OUTLET TO
NEW DI AT 16' RT.


455+50 - 456+50 LT.
EARTH REM. ENVIRONMENT
WITH STONE FILL TYPE I

STA. 456+00

456+00, 16' RT. - 458+00, 18' RT.
NEW 4" X 6" DI W/ C.I. GRATE
NEW 36" X 24" P.C.C. SP. 0.109 OR
STARS OUTLET TO
NEW DI AT 458+00, RT.

456+00 - 458+00 RT.
NEW 6" X 24" UNDERDRAIN W/ CAPPED END
OUTLET TO NEW 4" X 6" DI.
458+00, RT. 2.88'

456+00, 50' LT. - 14' RT.
NEW 6" X 24" UNDERDRAIN 6" X 20' LF
OUTLET TO NEW 4" X 6" DI
AT 456+00, RT. 16'

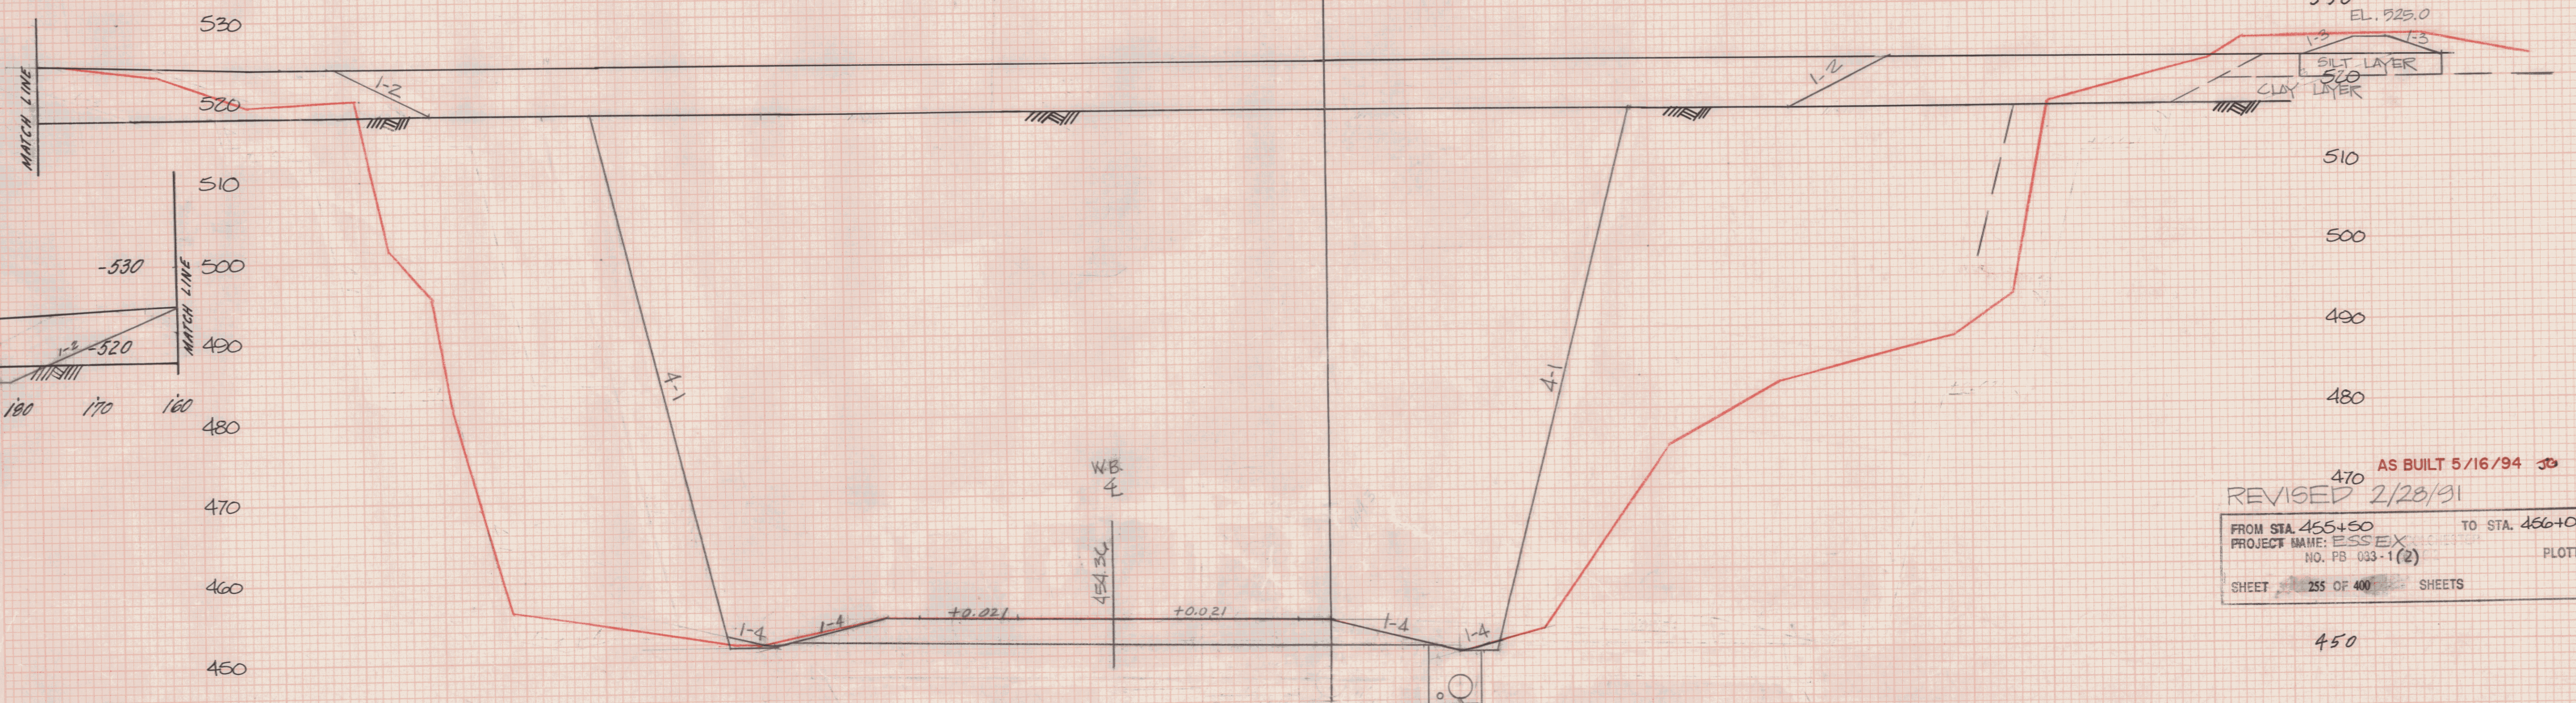

455+50, 00' LT.
NEW 14" X 14" DI W/ C.I. GRATE
NEW 18" X 24" P.C.C. SP. 0.004 OR
STARS OUTLET TO
NEW DI AT 16' RT.

STA. 455+50

AS BUILT 5/16/94

REVISED 2/28/91
FROM STA. 455+50 TO STA. 456+00
PROJECT NAME: ESSEX
NO. PB 033-1(2) PLOTTED: 11/1
SHEET 255 OF 400 SHEETS

450