


VERMONT ROUTE 289

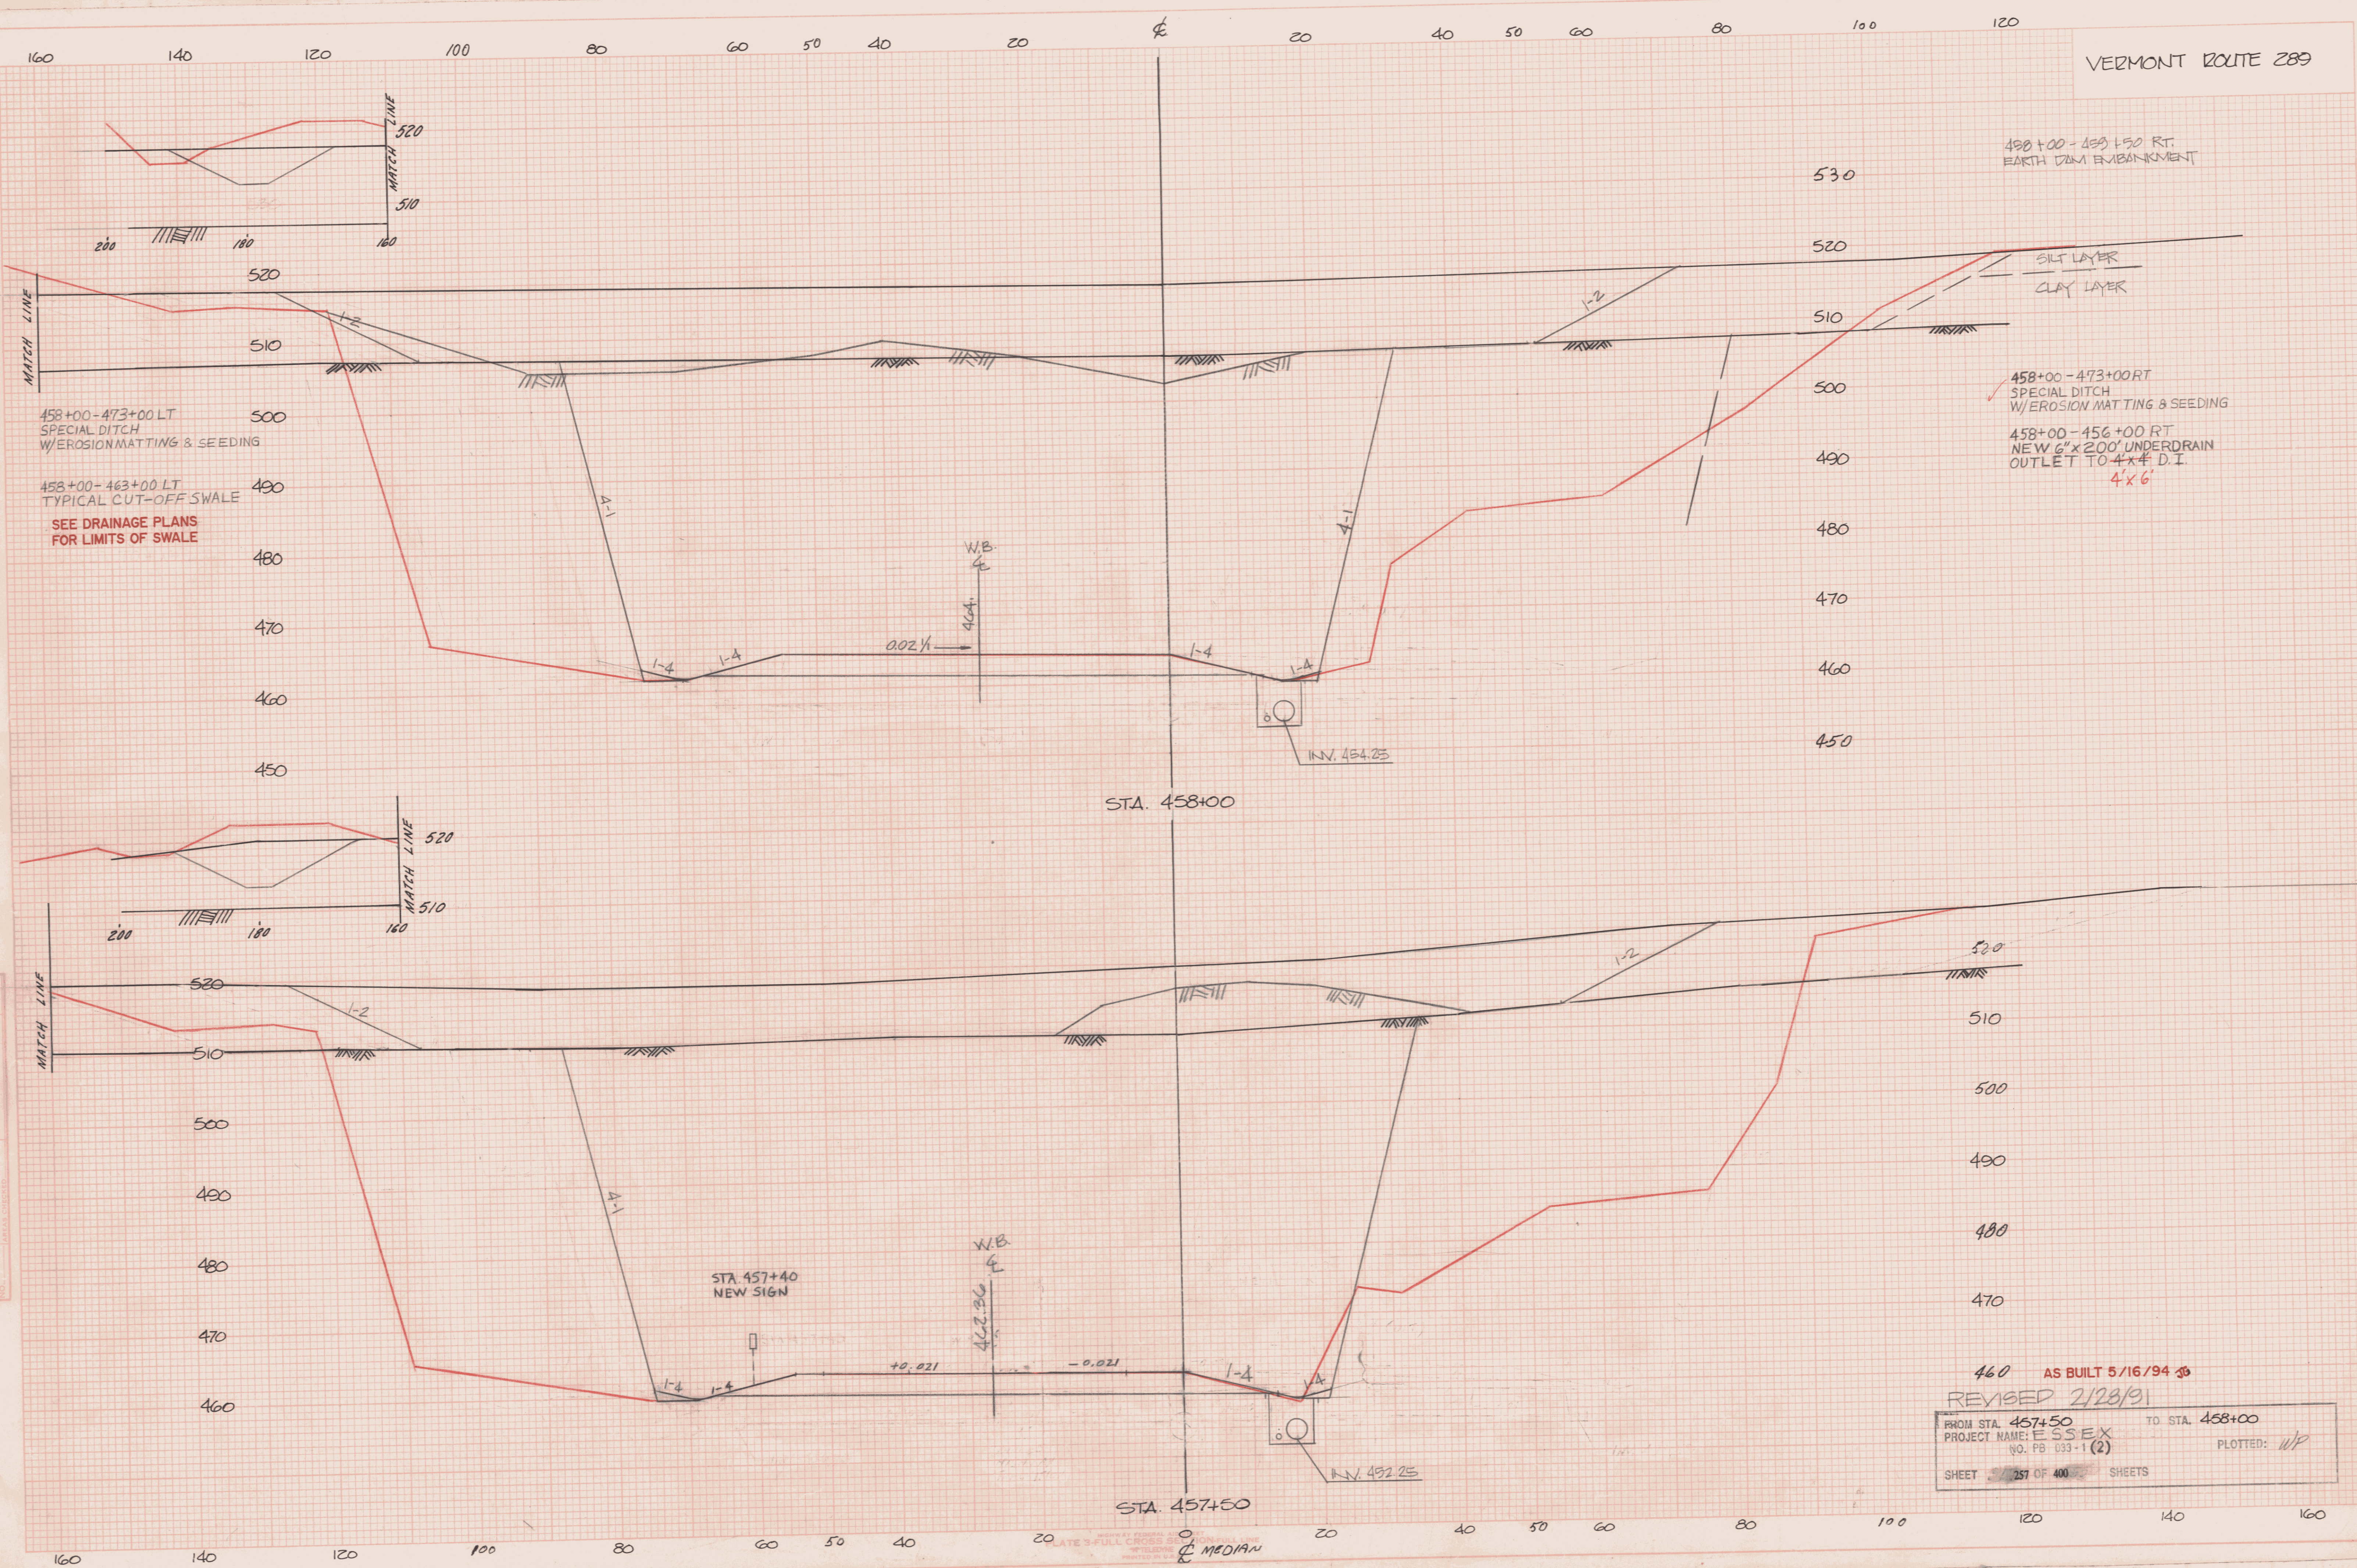

460 AS BUILT 5/16/94
REVISED 2/28/93
FROM STA. 457+50 TO STA. 458+00
PROJECT NAME: E SSEX
NO. PB 033-1 (2)
SHEET 287 OF 400 SHEETS
PLOTTED: W/P