


VERMONT ROUTE 289

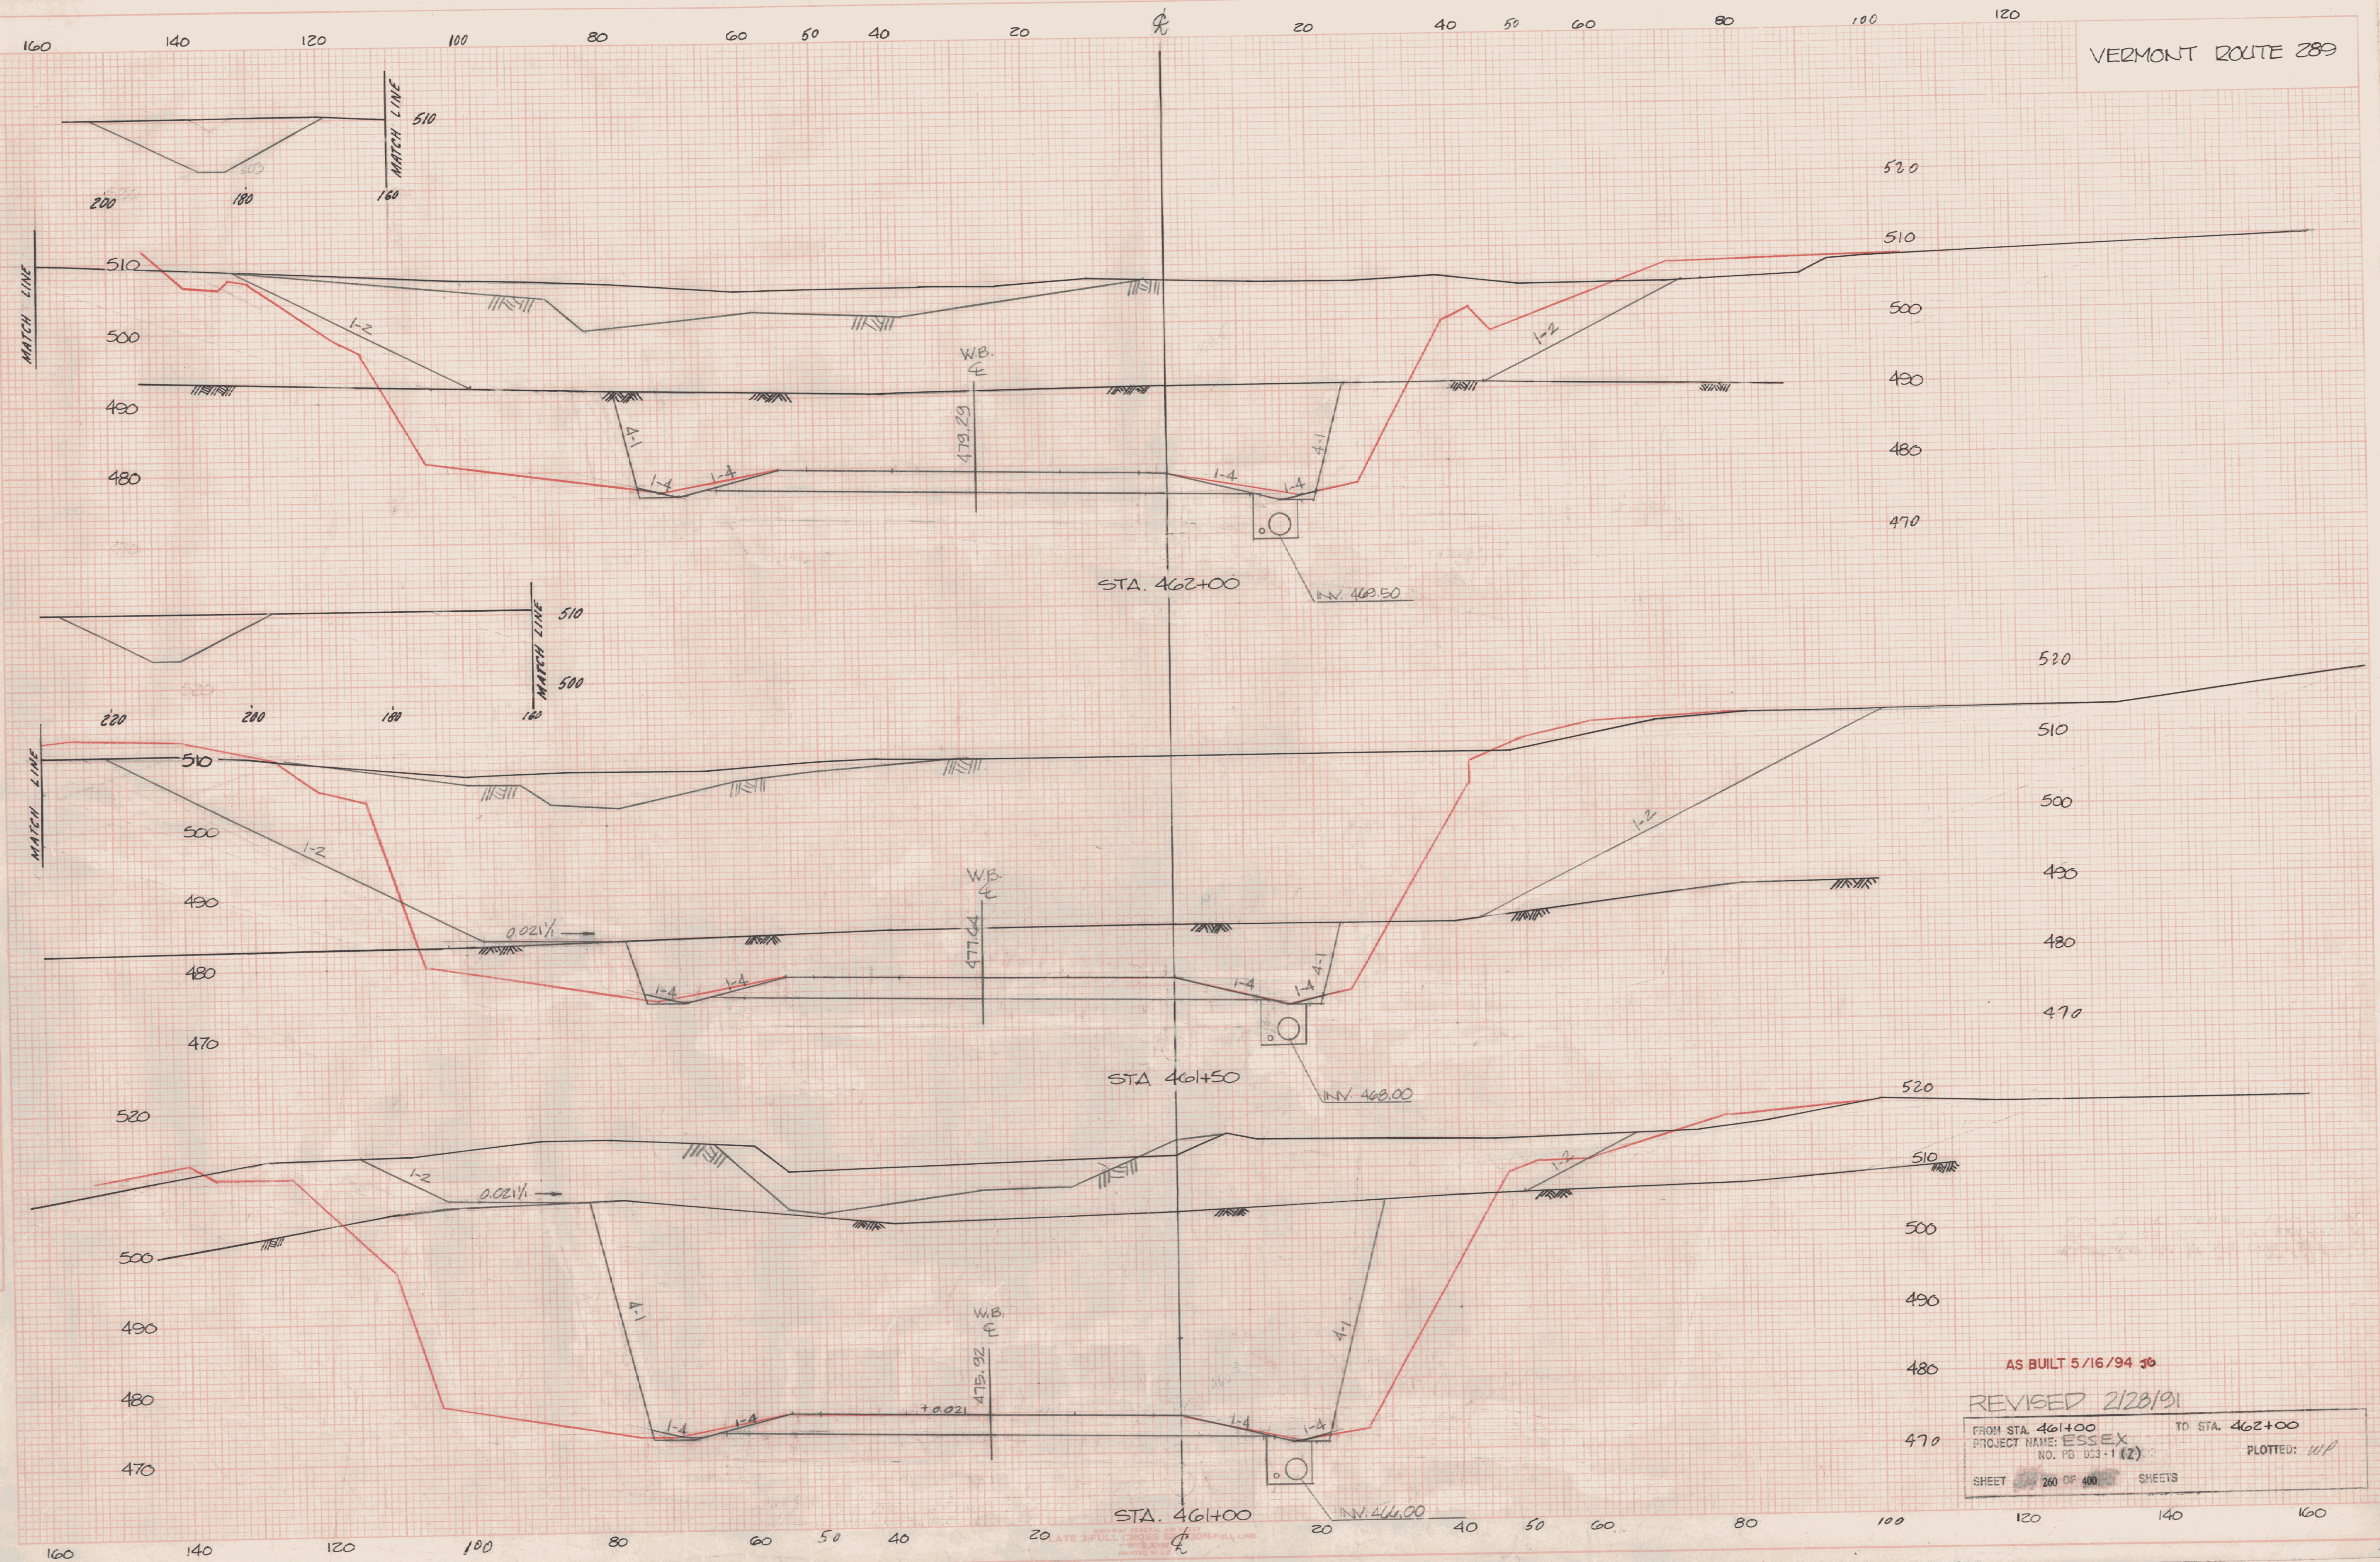

AS BUILT 5/16/94 30
REVISED 2/28/91
FROM STA. 461+00 TO STA. 462+00
PROJECT NAME: ESSEX
NO. PD 003-1 (2)
SHEET 200 OF 400 SHEETS
PLOTTED: WP

3/5 0+465