


FINAL SURVEY  
 REVISIONS  
 PLOTTED  
 NOTE BOOK  
 TEMPLATE  
 NO. 1  
 (SCALE 1/8"=1')

ORIGINAL SURVEY  
 REVISIONS  
 PLOTTED  
 NOTE BOOK  
 TEMPLATE  
 NO. 1  
 (SCALE 1/8"=1')

ORIGINAL SURVEY  
 REVISIONS  
 PLOTTED  
 NOTE BOOK  
 TEMPLATE  
 NO. 1  
 (SCALE 1/8"=1')

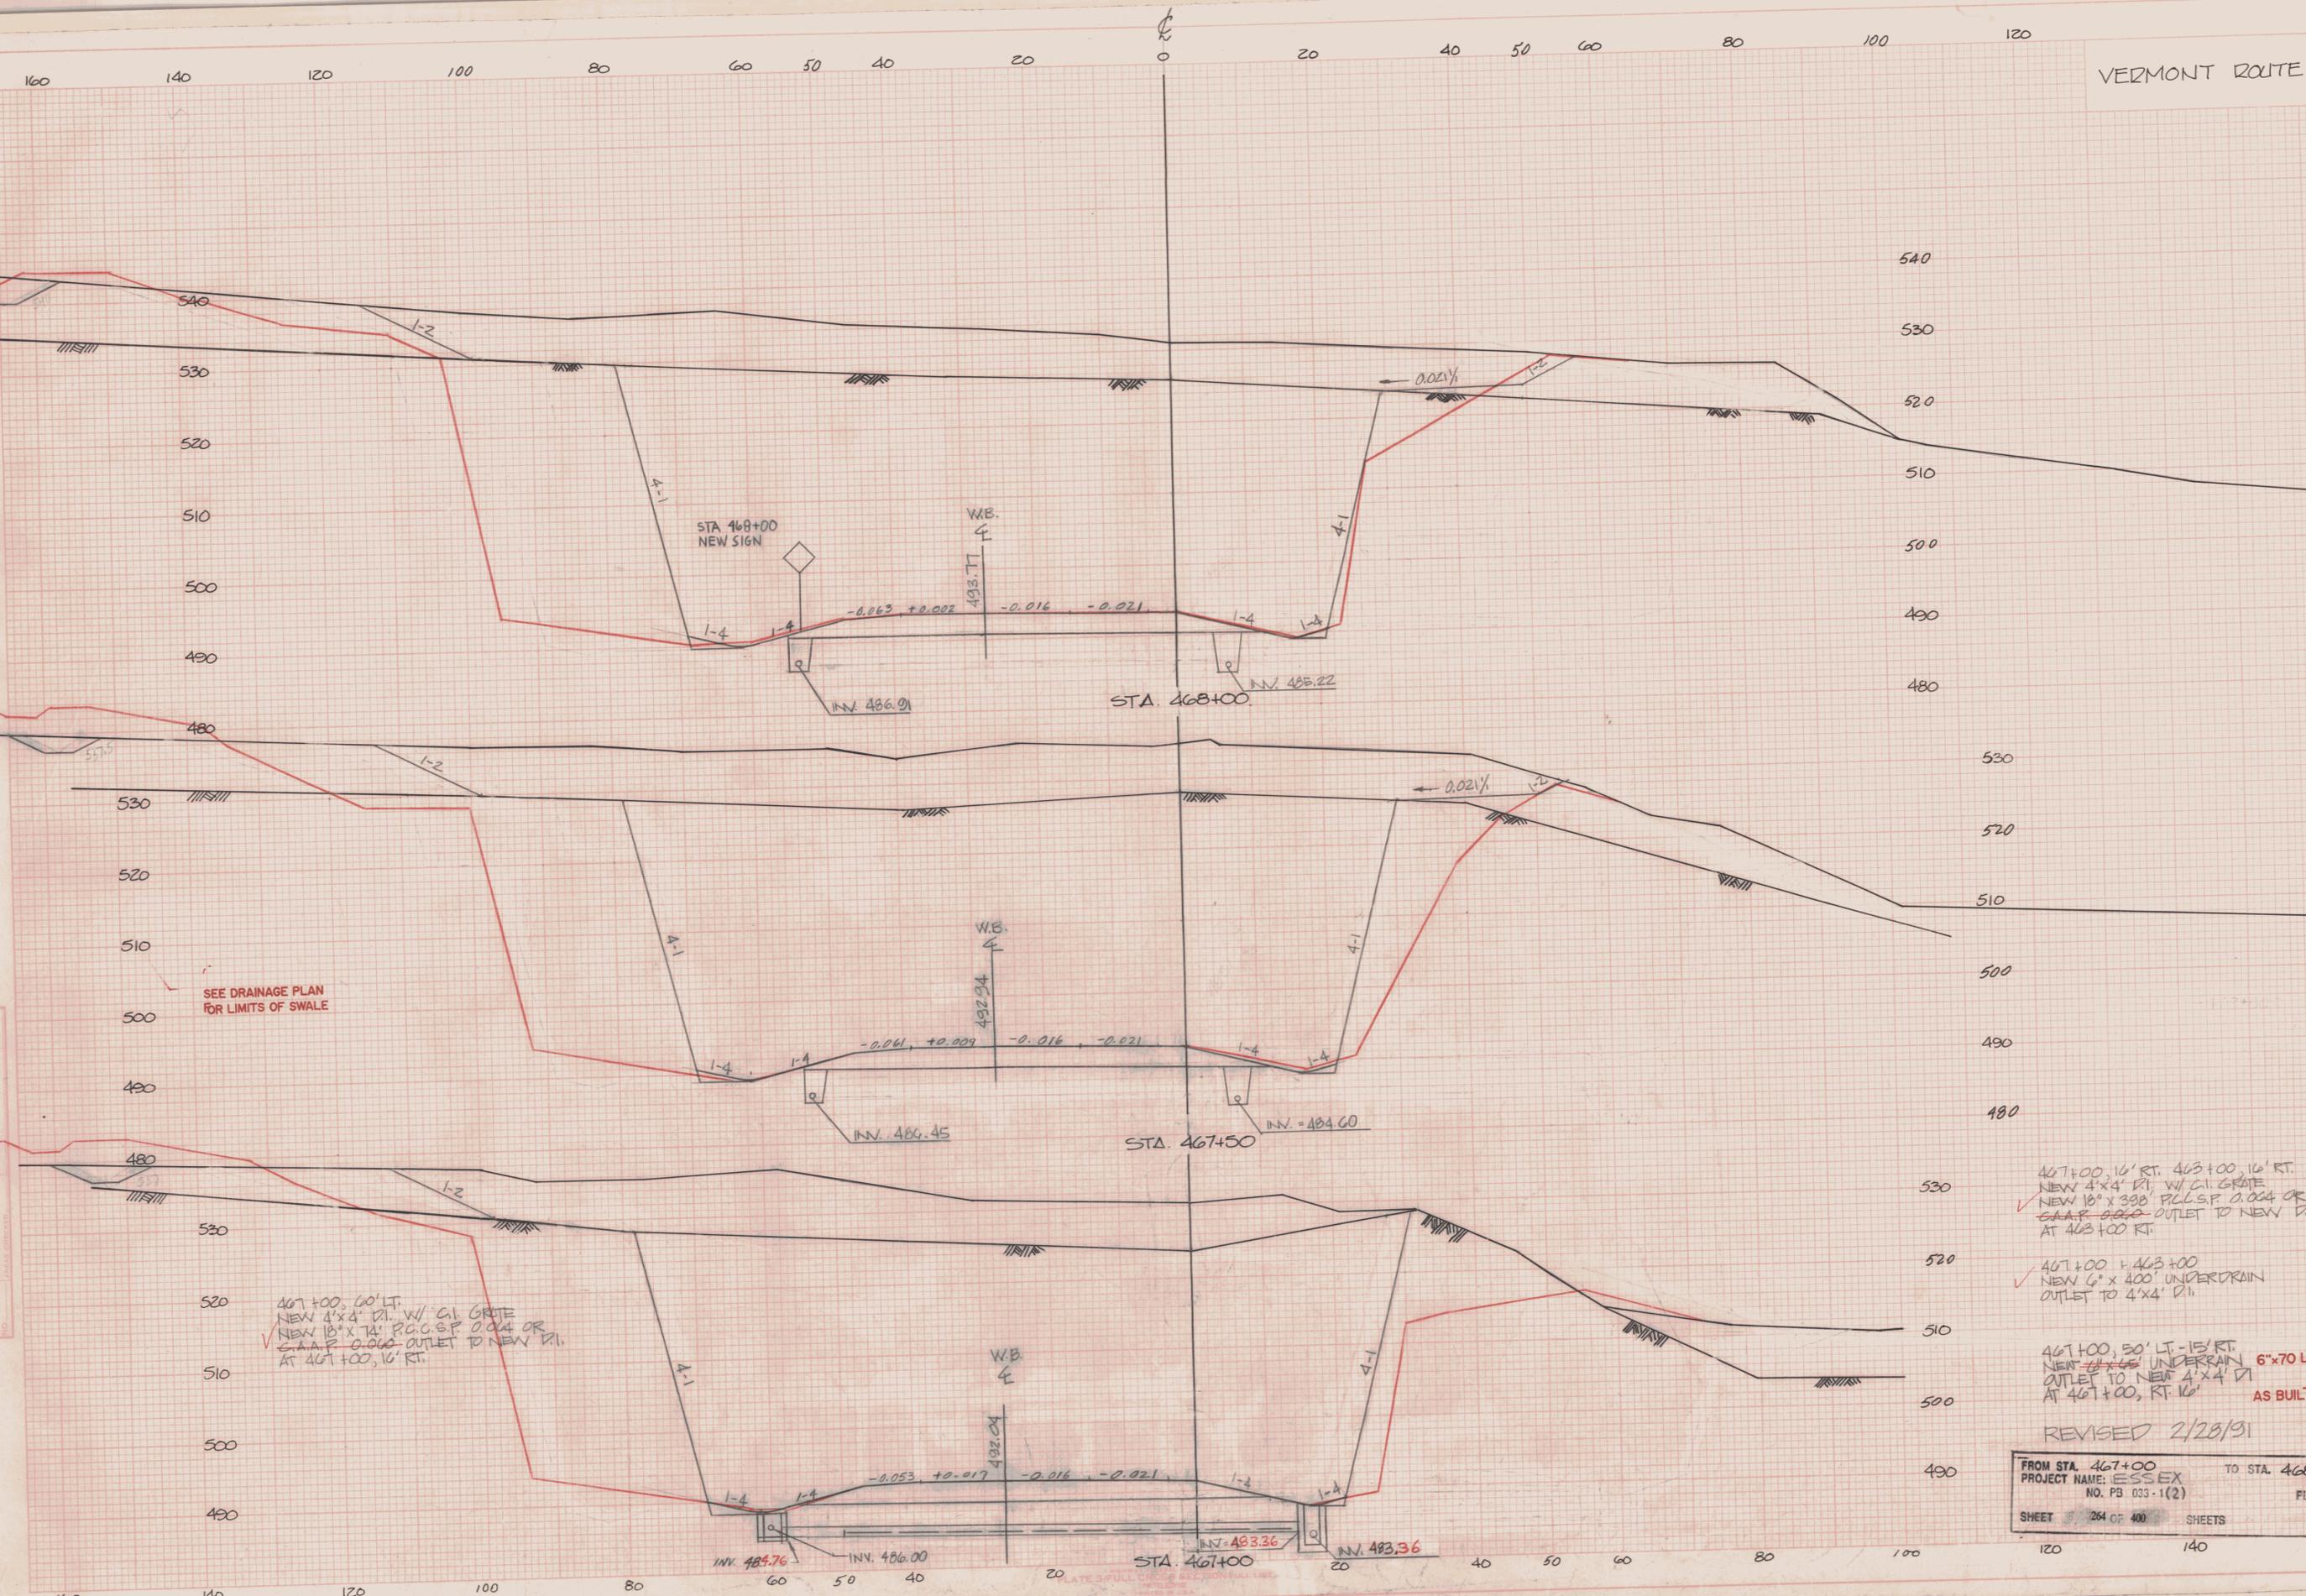

SEE DRAINAGE PLAN FOR LIMITS OF SWALE

467+00, 60' LT.  
 NEW 4'x4' DI. W/ C.I. GRATE  
 NEW 18" x 14" P.C.C.S.P. 0.004 OR  
 S.A.A.P. 0.000 OUTLET TO NEW DI.  
 AT 467+00, 16' RT.

467+00, 16' RT. 463+00, 16' RT.  
 NEW 4'x4' DI. W/ C.I. GRATE  
 NEW 18" x 14" P.C.C.S.P. 0.004 OR  
 S.A.A.P. 0.000 OUTLET TO NEW DI.  
 AT 463+00 RT.

467+00 + 463+00  
 NEW 6" x 400' UNDERDRAIN  
 OUTLET TO 4'x4' DI.

467+00, 50' LT. - 15' RT.  
 NEW 6" x 400' UNDERDRAIN  
 OUTLET TO NEW 4'x4' DI  
 AT 467+00, RT. 16' AS BUILT 5/17/94

REVISED 2/28/91

|                         |                |
|-------------------------|----------------|
| FROM STA. 467+00        | TO STA. 468+00 |
| PROJECT NAME: ESSEX     |                |
| NO. PB 033-1(2)         |                |
| SHEET 264 OF 400 SHEETS | PLOTTED: W/D   |