


DATE: _____
 BY: _____
 ORIGINAL SURVEY: _____
 SURVEY: _____
 PLOTTED: _____
 NOTE BOOK: _____
 NO. _____
 AREAS CHECKED: _____

DATE: _____
 BY: _____
 ORIGINAL SURVEY: _____
 SURVEY: _____
 PLOTTED: _____
 NOTE BOOK: _____
 NO. _____
 AREAS CHECKED: _____

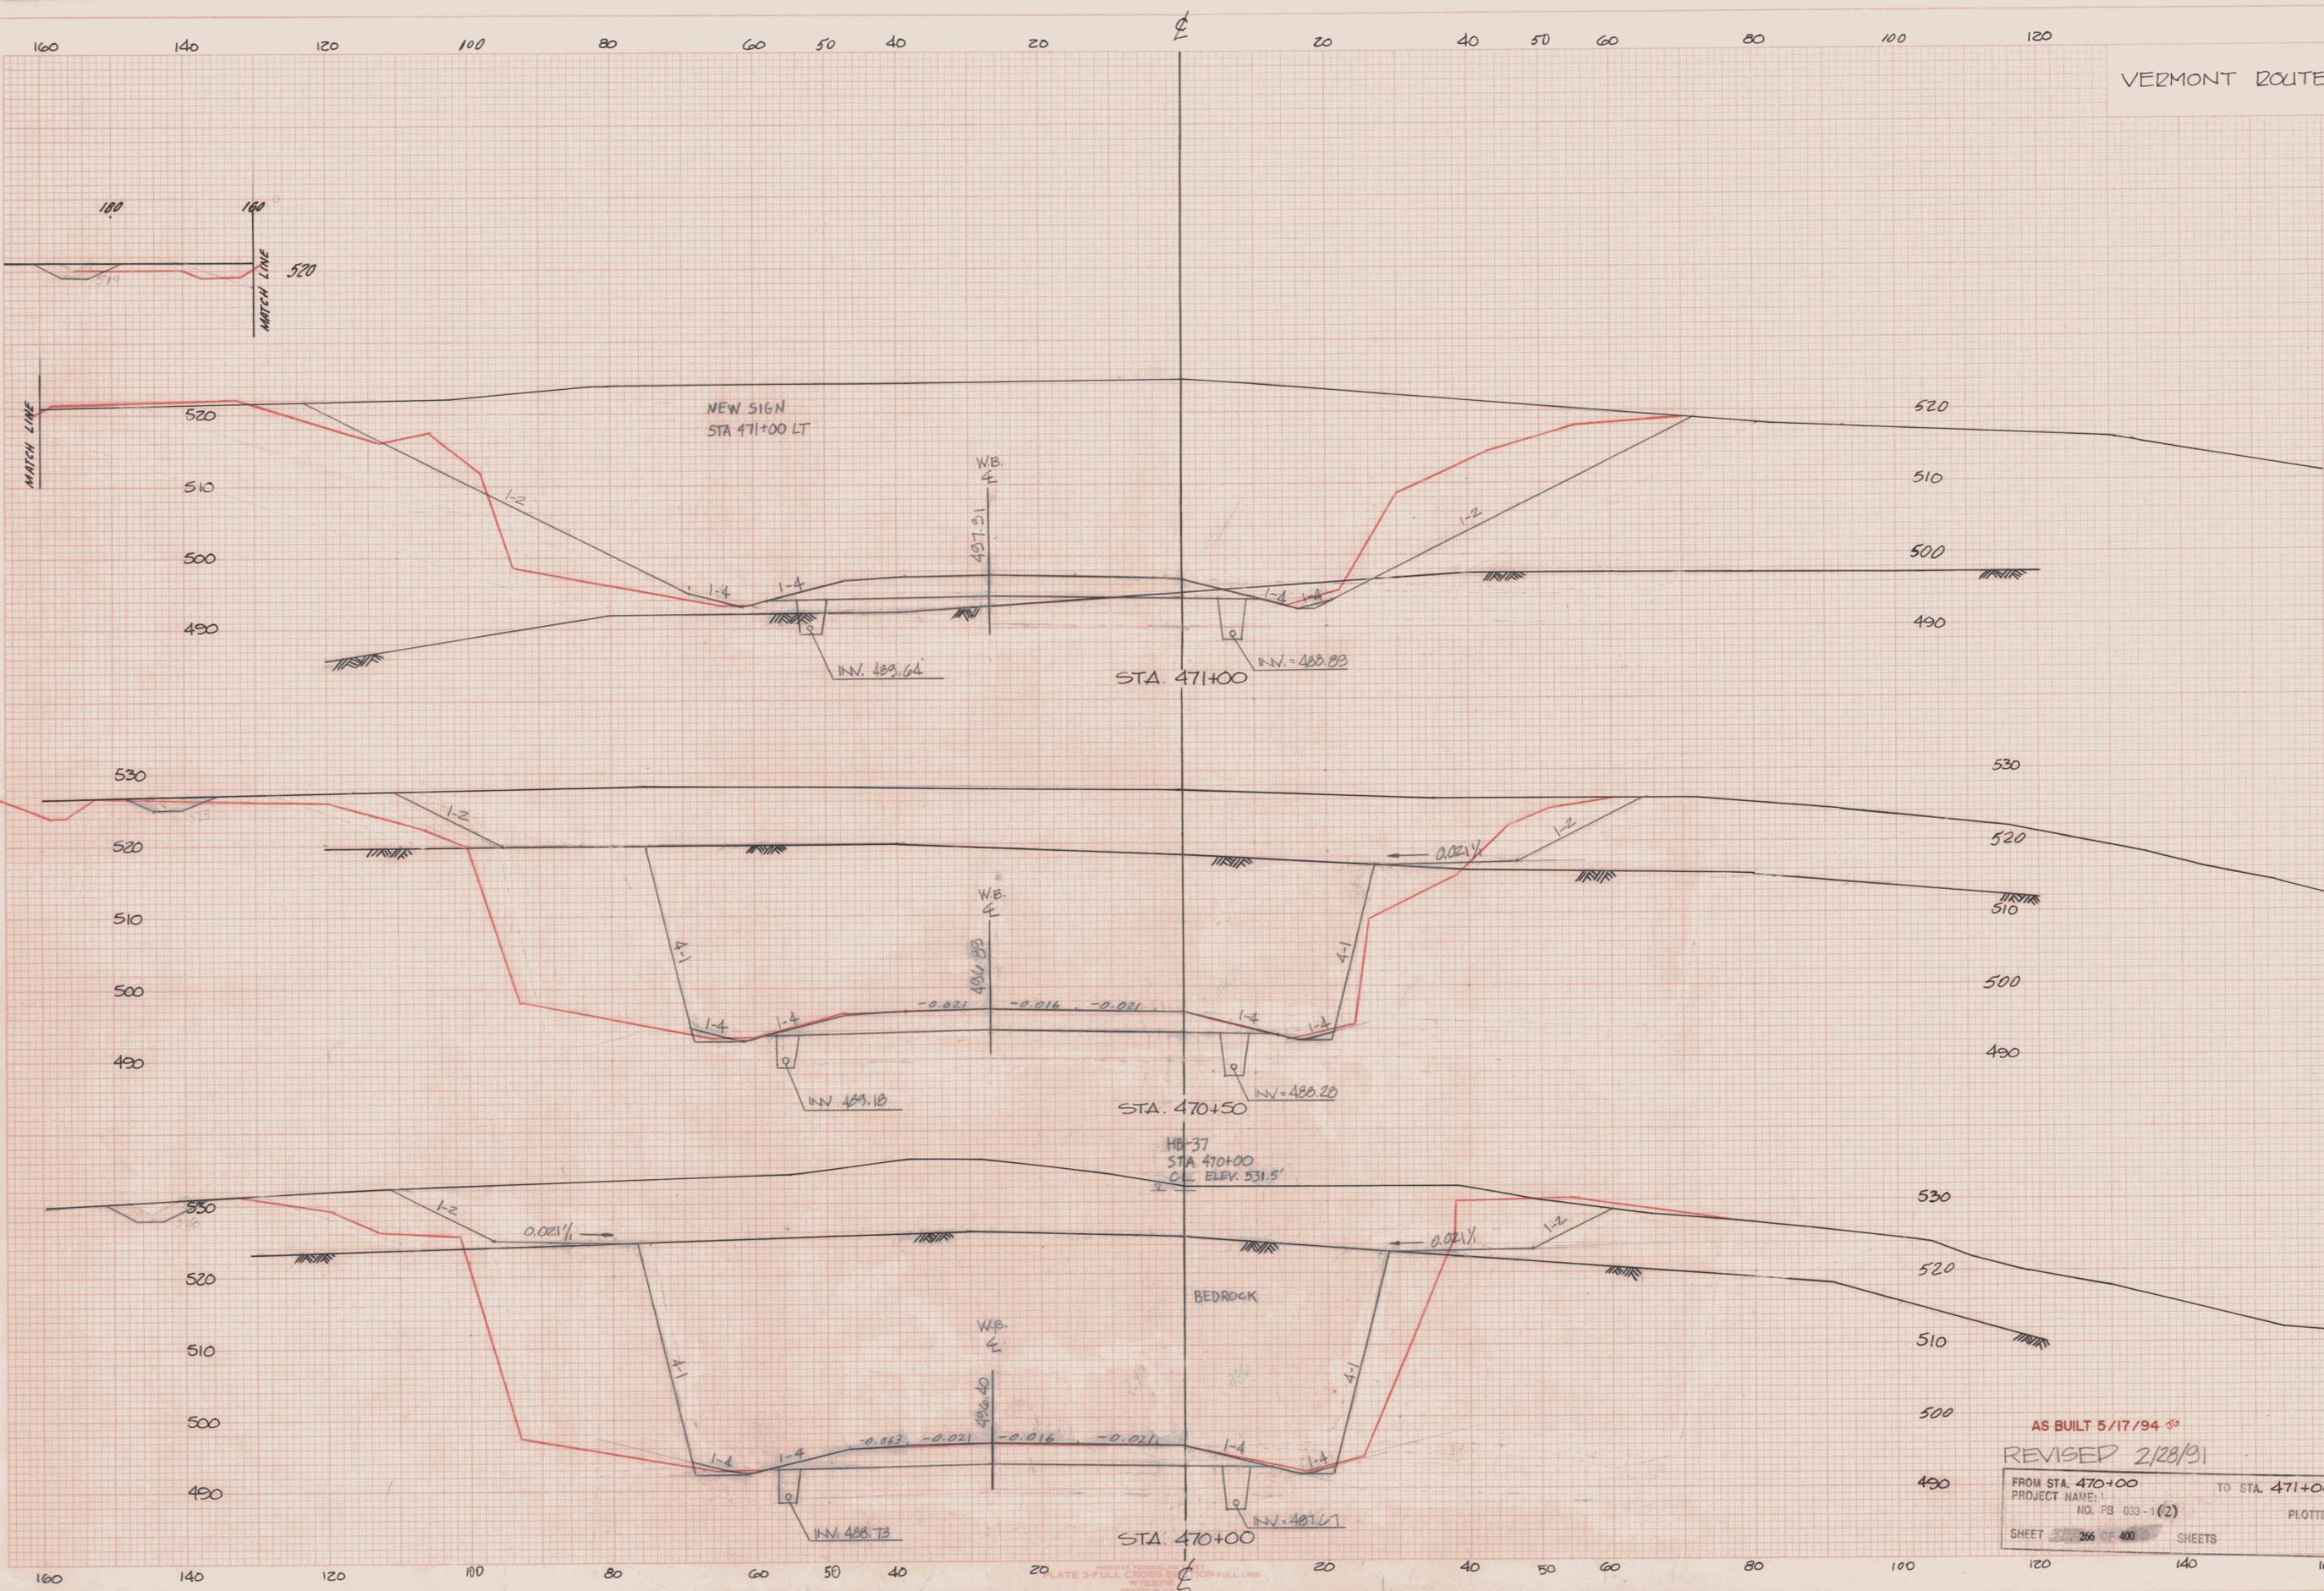

AS BUILT 5/17/94 30
 REVISED 2/28/91
 FROM STA. 470+00 TO STA. 471+00
 PROJECT NAME: 1
 NO. PB 033-1(2) PLOTTED: WIP
 SHEET 266 OF 400 SHEETS