


VERMONT ROUTE 289

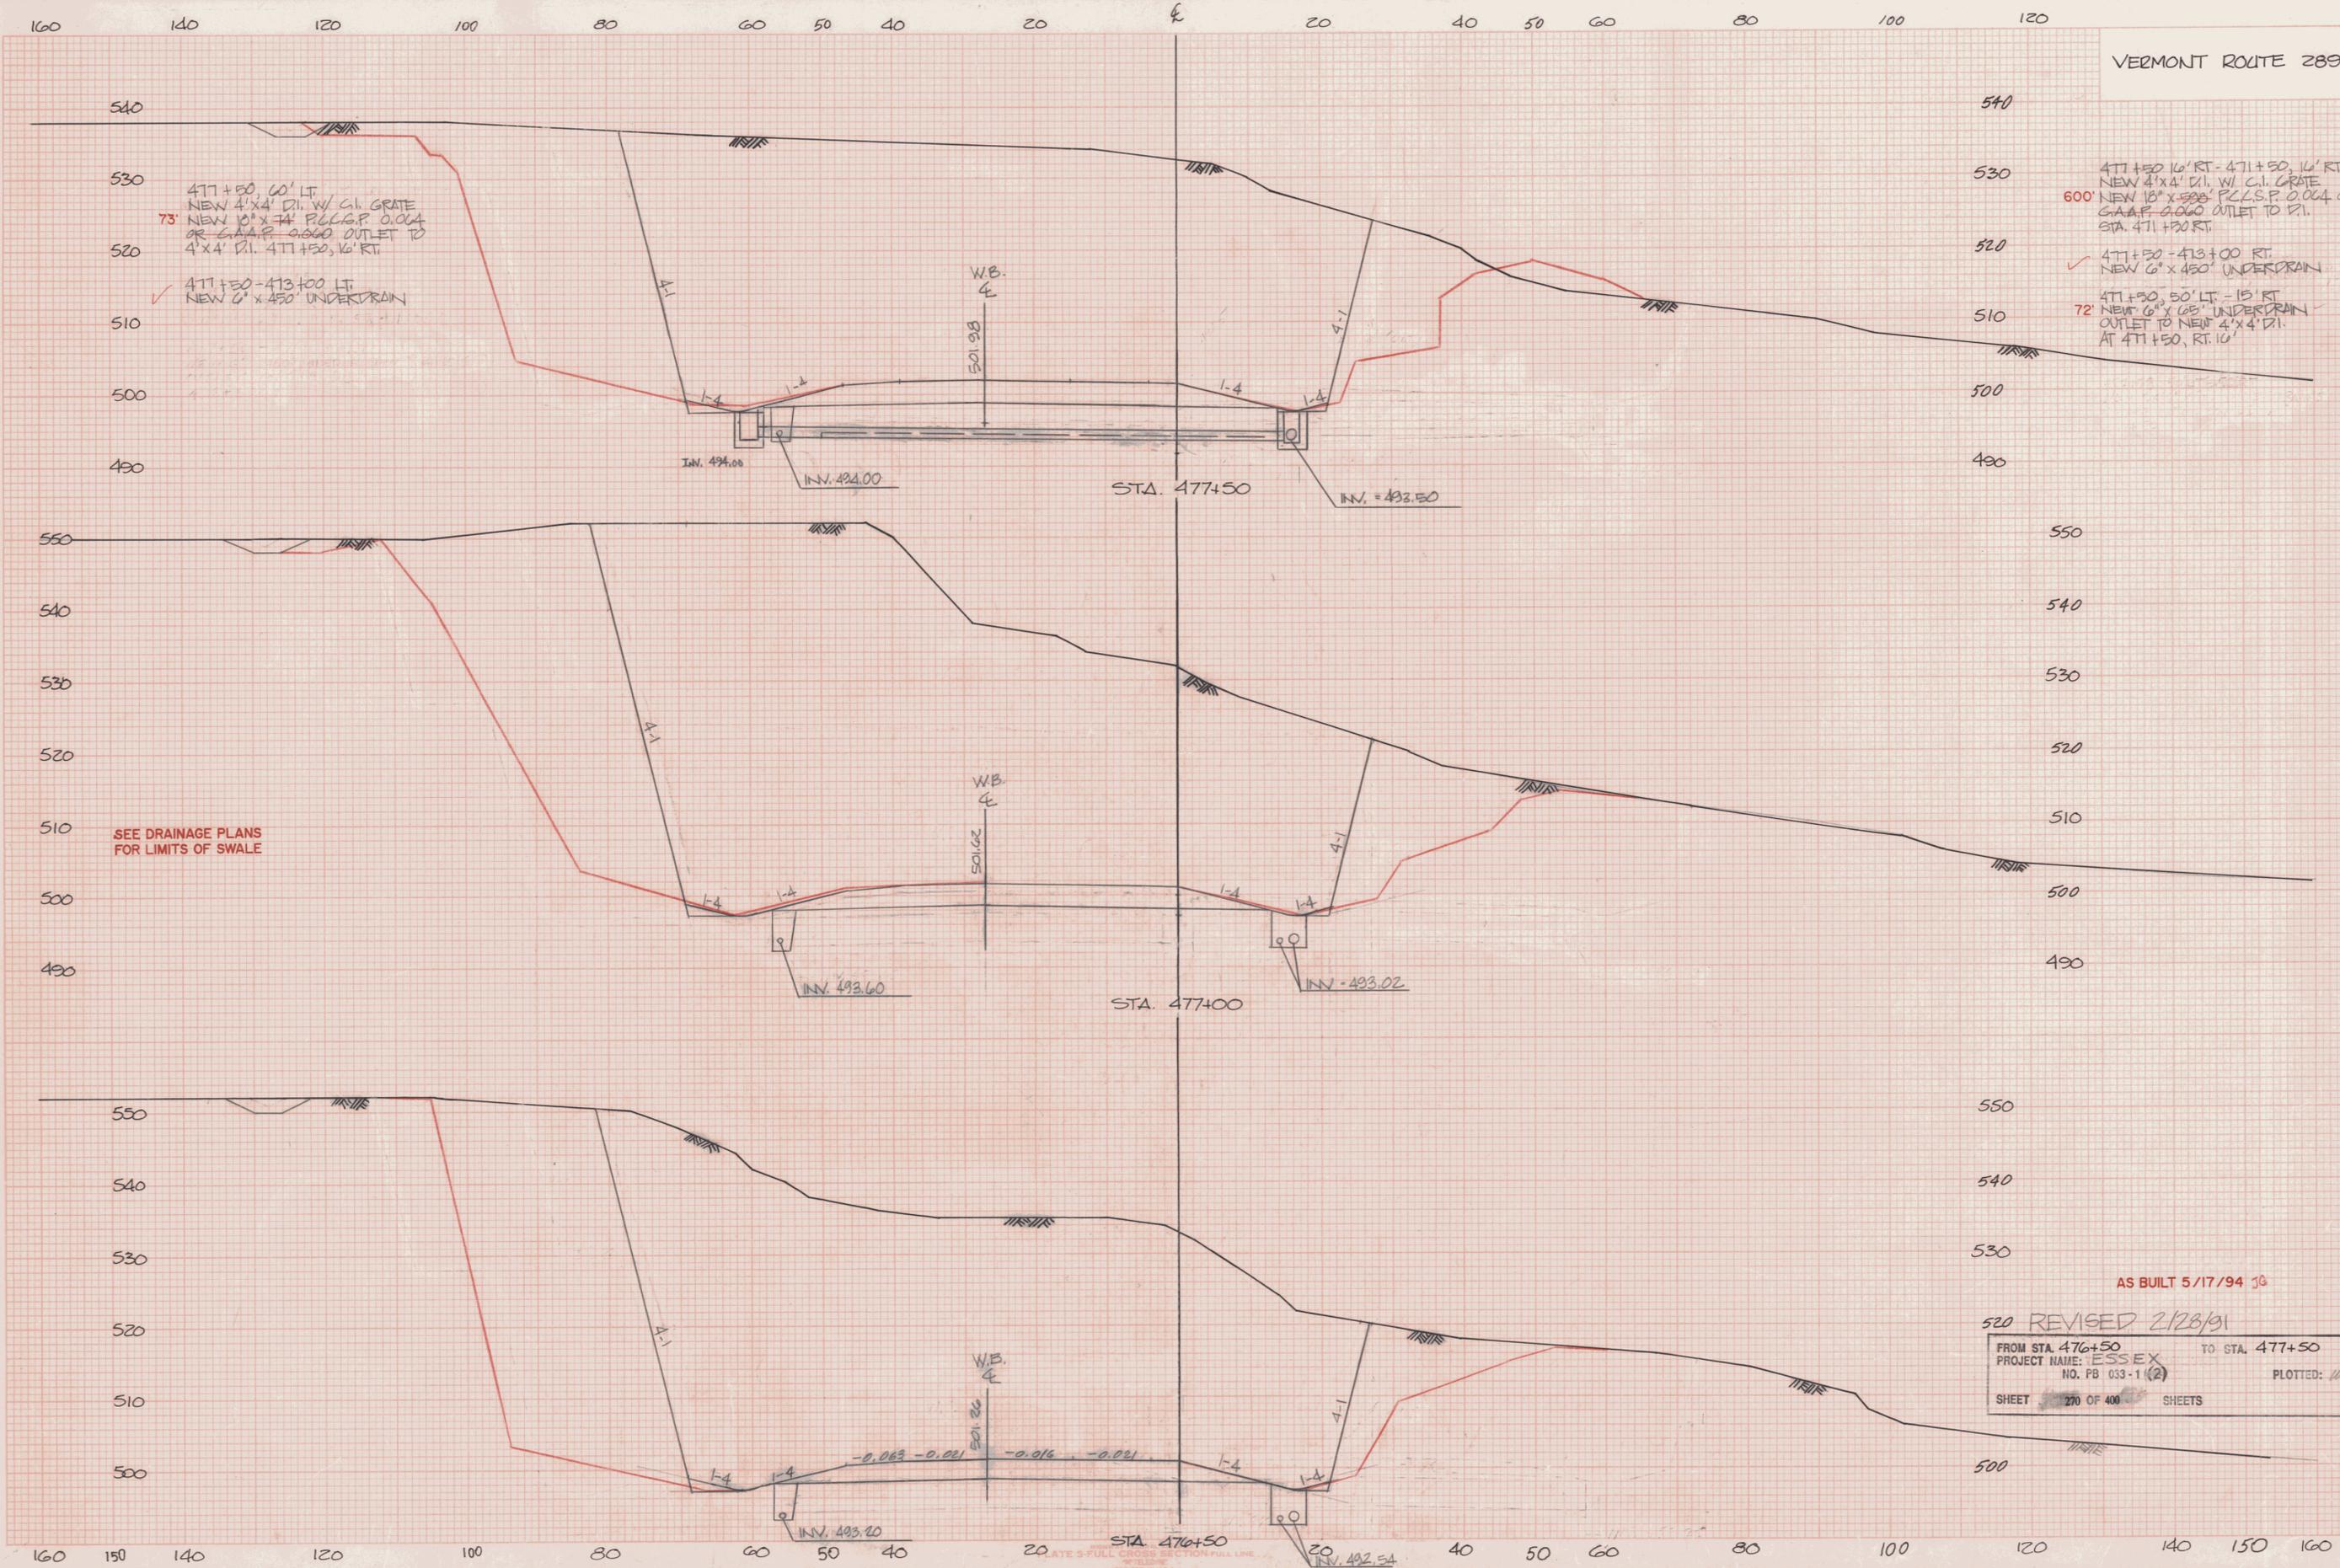

477+50, 60' LT.
 NEW 4'x4' DI. W/ GI. GRATE
 NEW 10'x74' P.C.C.P. 0.004
 OR G.A.P. 0.060 OUTLET TO
 4'x4' DI. 477+50, 16' RT.
 73
 477+50-473+00 LT.
 NEW 6'x450' UNDERDRAIN

477+50, 16' RT.
 NEW 4'x4' DI. W/ GI. GRATE
 NEW 10'x74' P.C.C.P. 0.004 OR
 G.A.P. 0.060 OUTLET TO DI.
 STA. 477+50 RT.
 600
 477+50-473+00 RT.
 NEW 6'x450' UNDERDRAIN
 477+50, 50' LT. - 15' RT.
 NEW 6'x450' UNDERDRAIN
 OUTLET TO NEW 4'x4' DI.
 AT 477+50, RT. 10'
 72

SEE DRAINAGE PLANS
 FOR LIMITS OF SWALE

AS BUILT 5/17/94 JG

520 REVISED 2/28/91
 FROM STA. 476+50 TO STA. 477+50
 PROJECT NAME: ESSEX
 NO. PB 033-1 (2) PLOTTED: WJ
 SHEET 270 OF 400 SHEETS

DATE
 BY
 CHECKED
 ORIGINAL SURVEY
 PLOTTED
 NOTE BOOK
 NO.
 AREA CHECKED

DATE
 BY
 CHECKED
 ORIGINAL SURVEY
 PLOTTED
 NOTE BOOK
 NO.
 AREA CHECKED

DATE 5-FULL CROSS SECTION FULL LINE
 PRINTED IN U.S.A.