


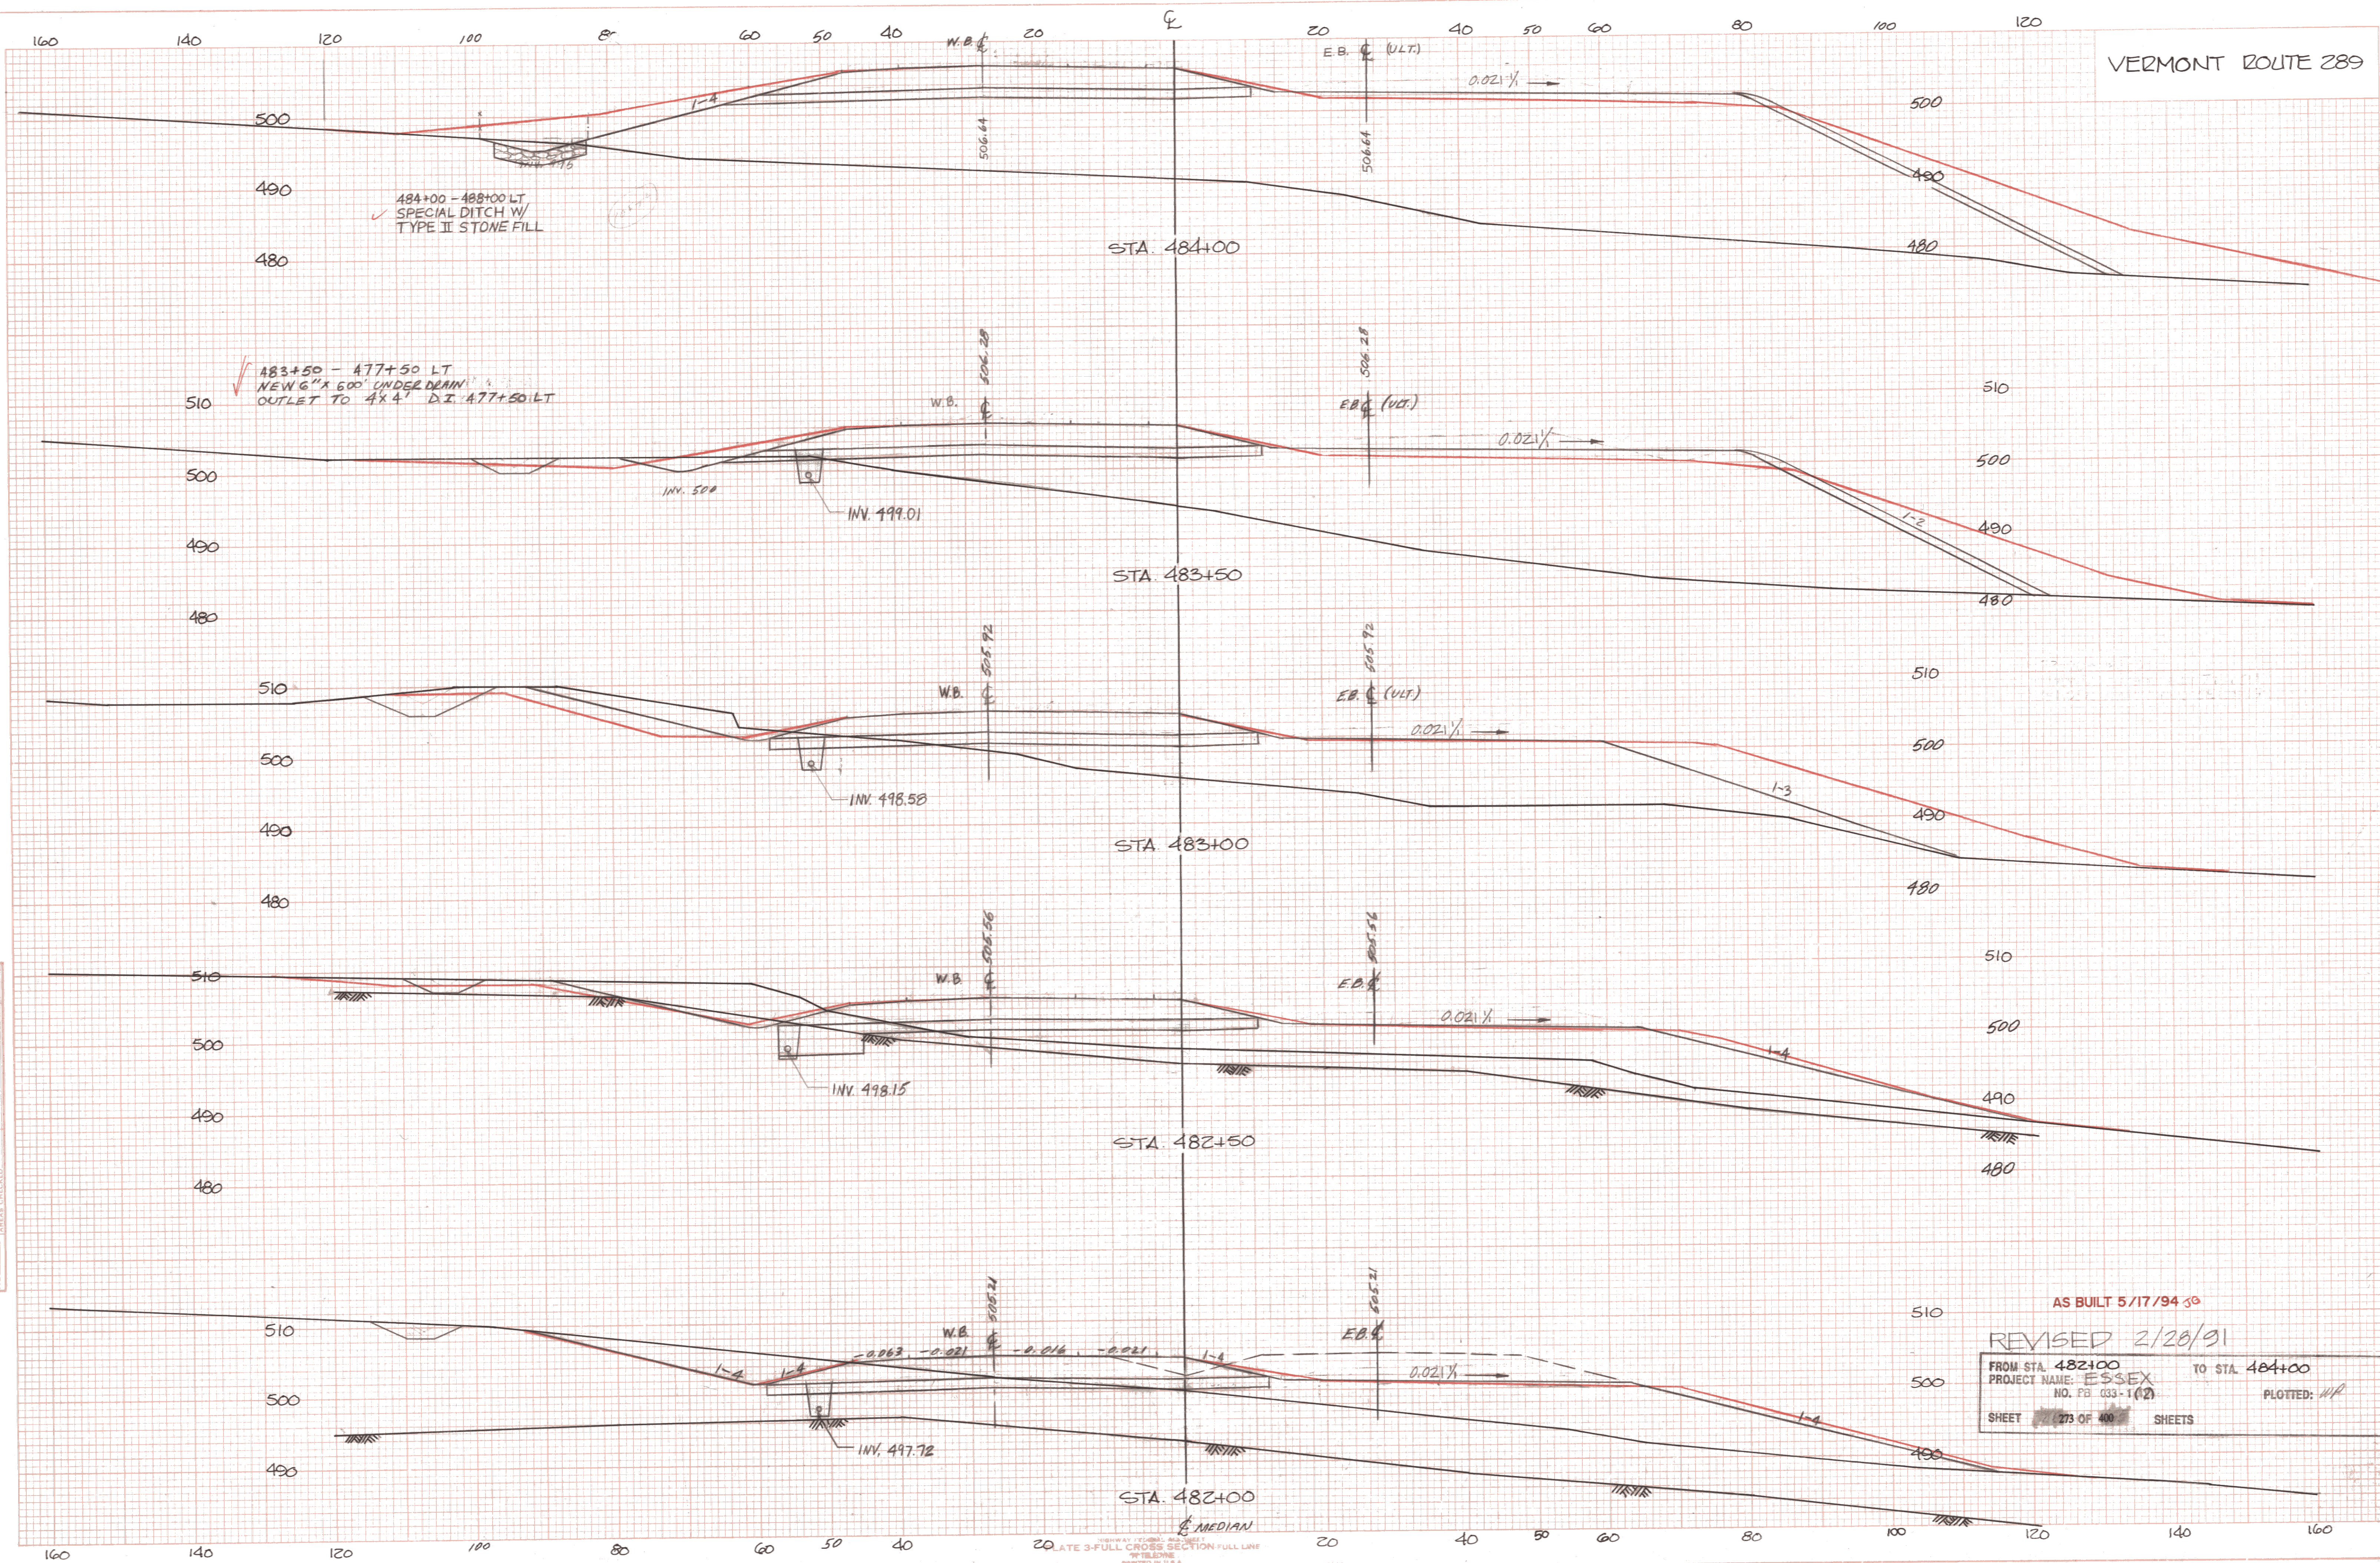

AS BUILT 5/17/94 30

REVISED 2/28/91

FROM STA. 482+00 TO STA. 484+00

PROJECT NAME: ESSEX
NO. PB 033-1(2)

SHEET 273 OF 400 SHEET

PLOTTED: *WF*