


FINAL SURVEY SURVEYED BY DATE  
 PLOTTED BY DATE  
 NOTE BOOK NO. DATE  
 AREAS CHECKED

ORIGINAL SURVEY SURVEYED BY DATE  
 PLOTTED BY DATE  
 NOTE BOOK NO. DATE  
 AREAS CHECKED

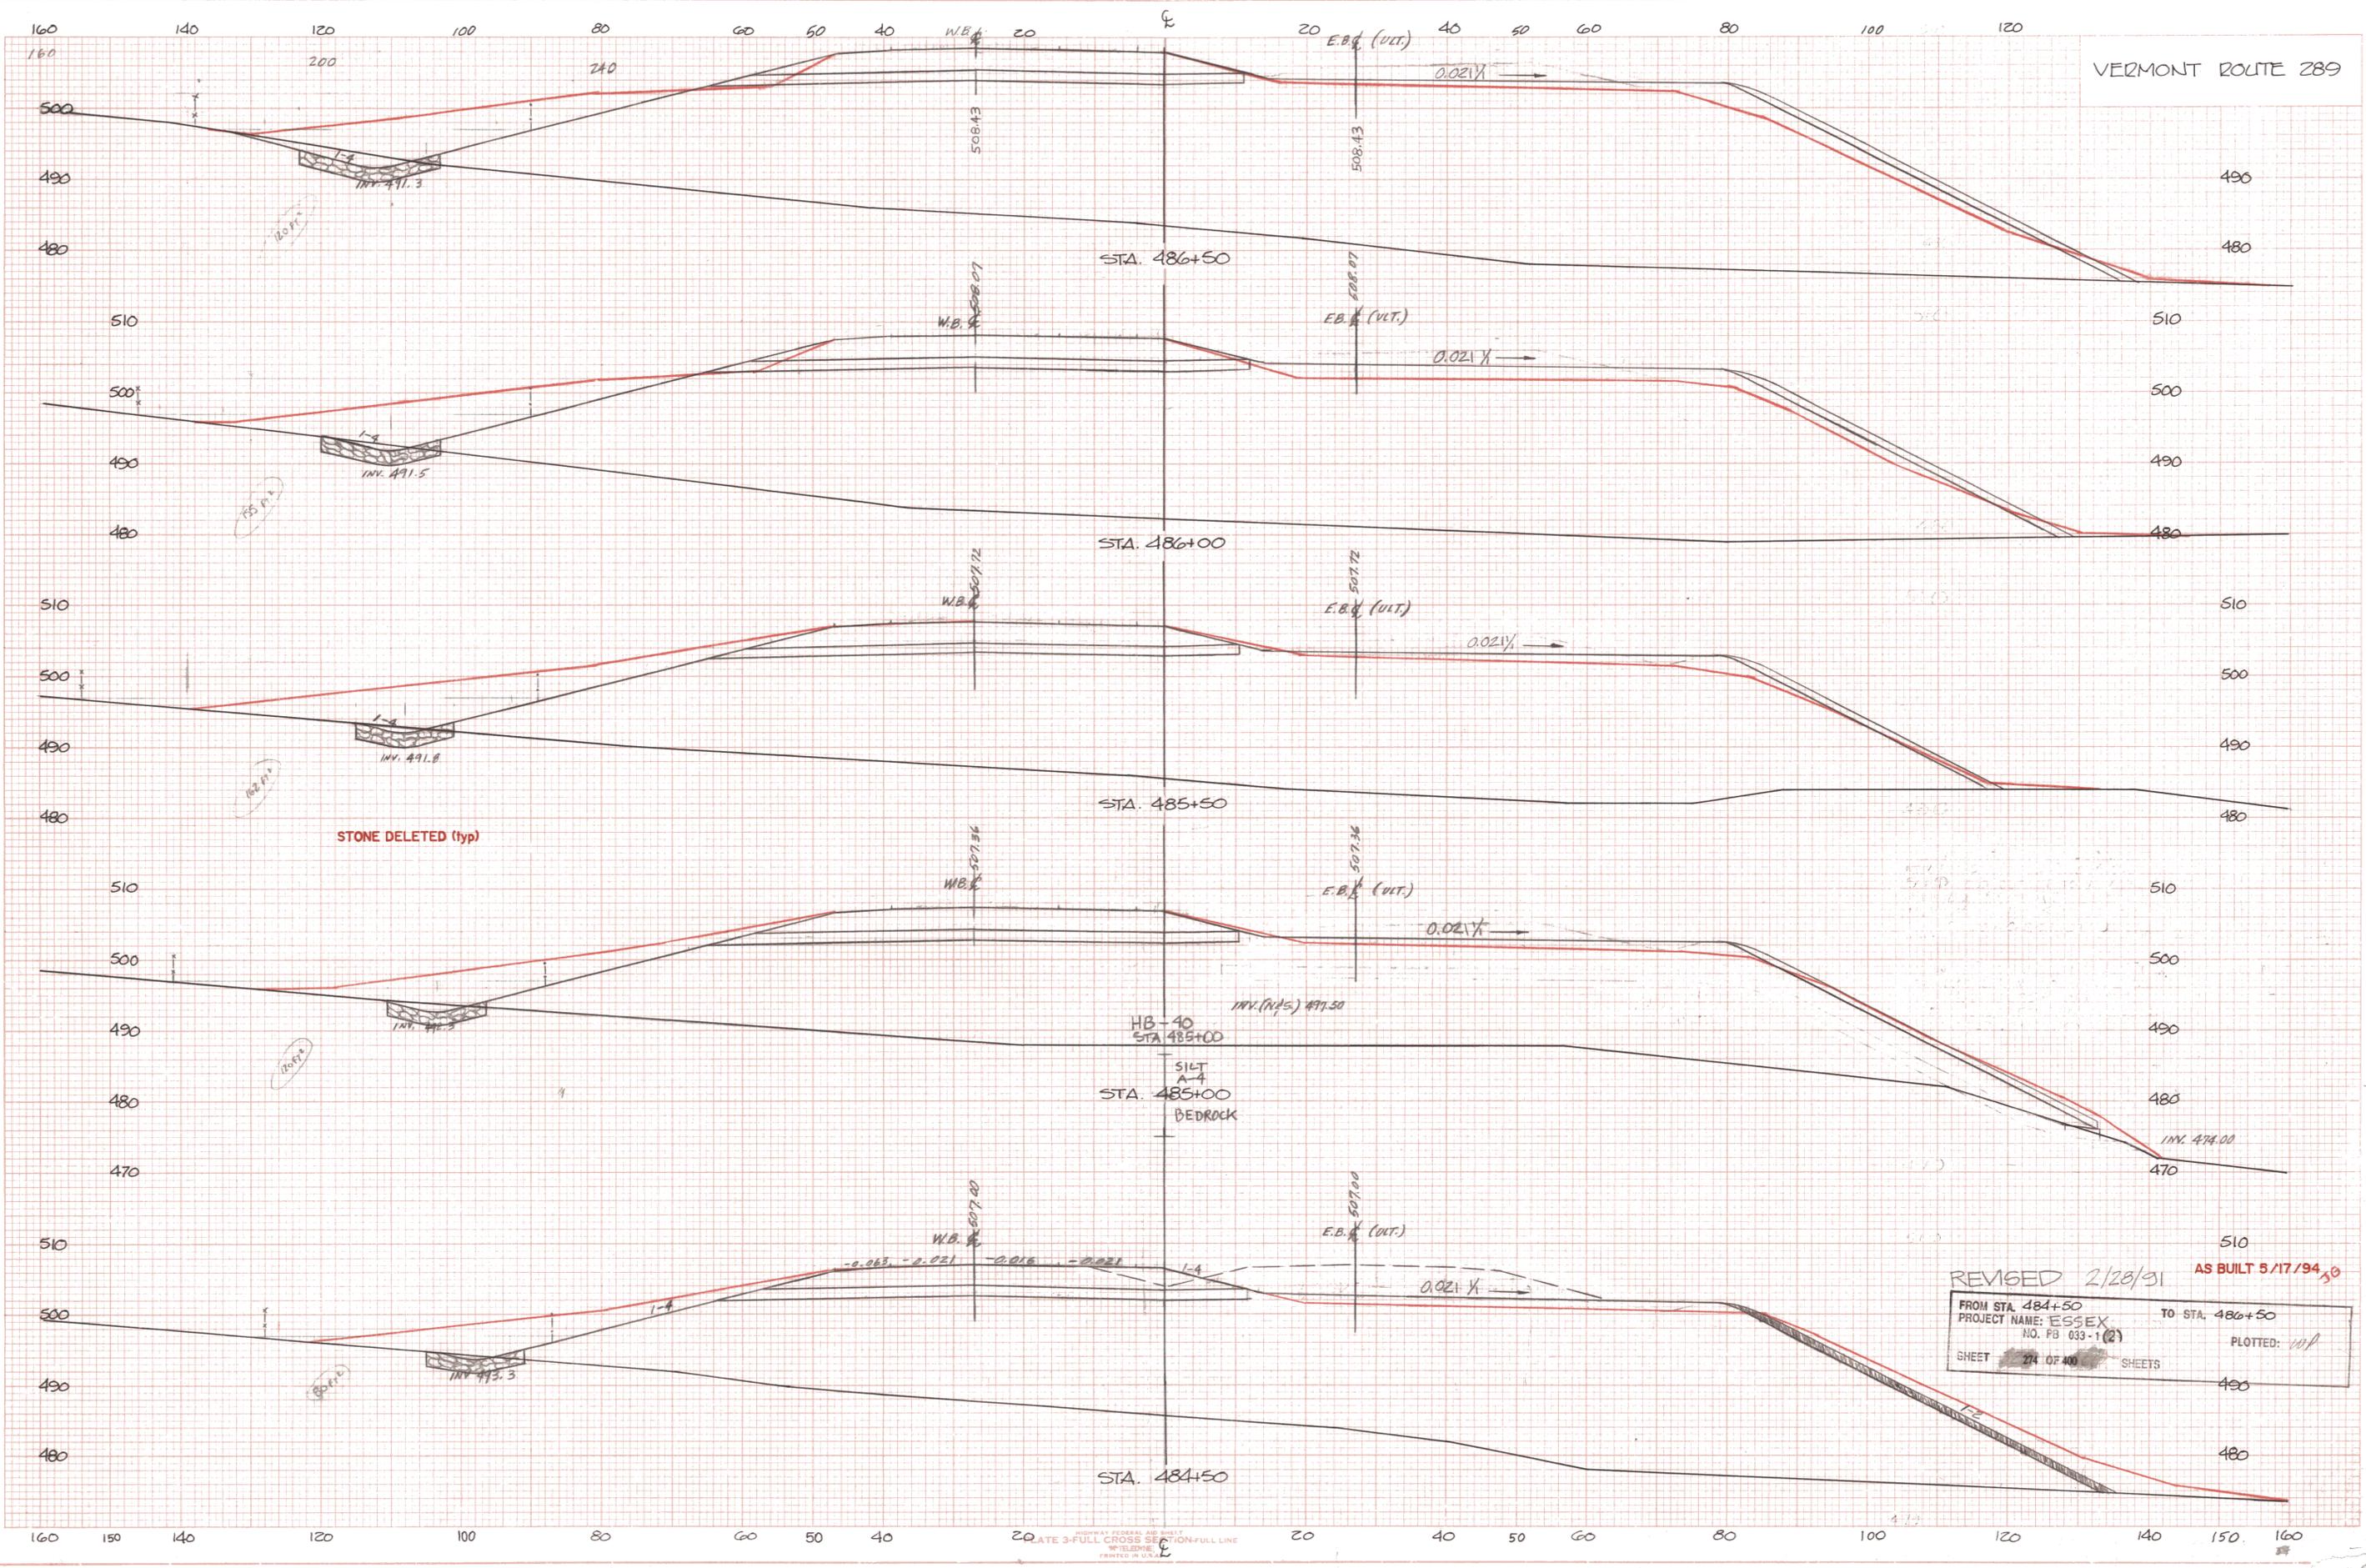

REVISED 2/28/91 AS BUILT 5/17/94  
 FROM STA. 484+50 TO STA. 486+50  
 PROJECT NAME: ESSEX NO. PB 033-1(2)  
 SHEET 274 OF 400 SHEETS PLOTTED: WJP