


490+00 - 496+00 LT  
TYPICAL CUT-OFF SWALE

DATE \_\_\_\_\_  
BY \_\_\_\_\_  
FINAL SURVEY  
BORROWED: \_\_\_\_\_  
PLOTTED: \_\_\_\_\_  
NOTE BOOK: \_\_\_\_\_  
NO. \_\_\_\_\_  
AREAS CHECKED: \_\_\_\_\_

DATE \_\_\_\_\_  
BY \_\_\_\_\_  
ORIGINAL SURVEY  
BORROWED: \_\_\_\_\_  
PLOTTED: \_\_\_\_\_  
NOTE BOOK: \_\_\_\_\_  
NO. \_\_\_\_\_  
AREAS CHECKED: \_\_\_\_\_

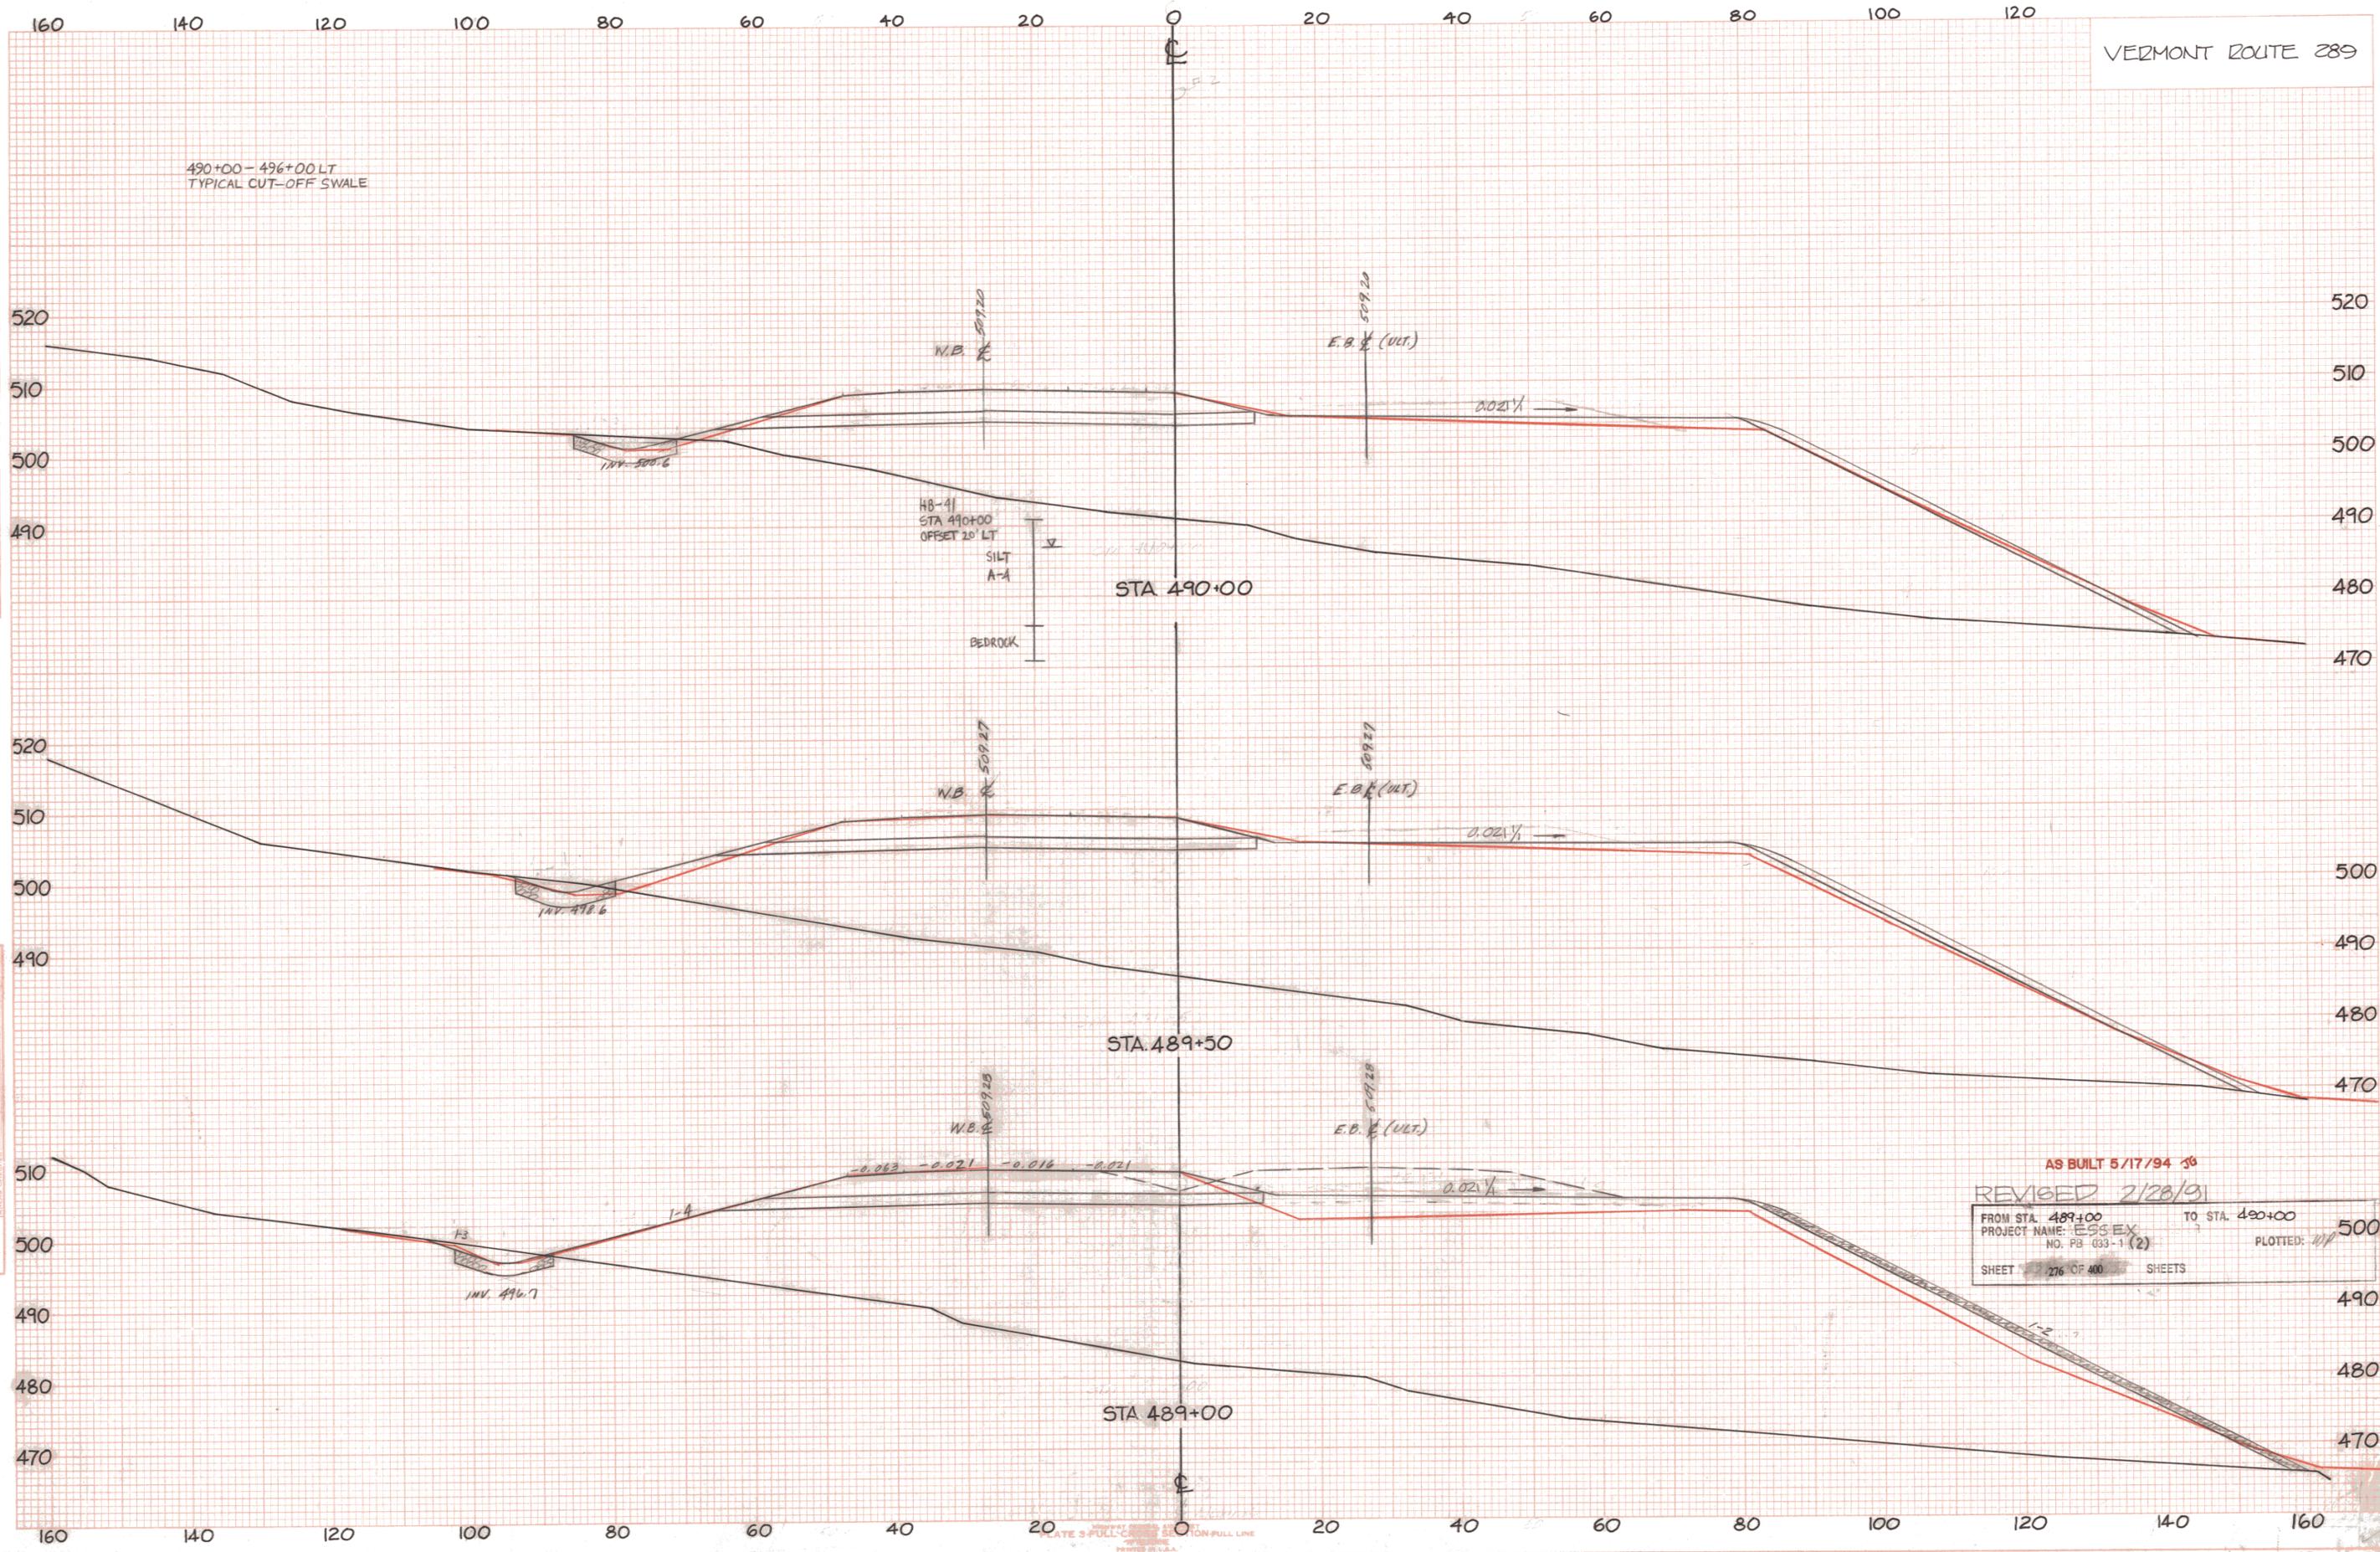

AS BUILT 5/17/94  
REVISED 7/28/91  
FROM STA. 489+00 TO STA. 490+00  
PROJECT NAME: ESSEX  
NO. PB 093-1 (2)  
SHEET 276 OF 400 SHEETS  
PLOTTED: 1/1