


FINAL SURVEY  
 DATE: \_\_\_\_\_  
 BY: \_\_\_\_\_  
 CHECKED: \_\_\_\_\_  
 NO. OF BOOKS: \_\_\_\_\_  
 NO. OF SHEETS: \_\_\_\_\_  
 AREA: \_\_\_\_\_

ORIGINAL SURVEY  
 DATE: \_\_\_\_\_  
 BY: \_\_\_\_\_  
 CHECKED: \_\_\_\_\_  
 NO. OF BOOKS: \_\_\_\_\_  
 NO. OF SHEETS: \_\_\_\_\_  
 AREA: \_\_\_\_\_

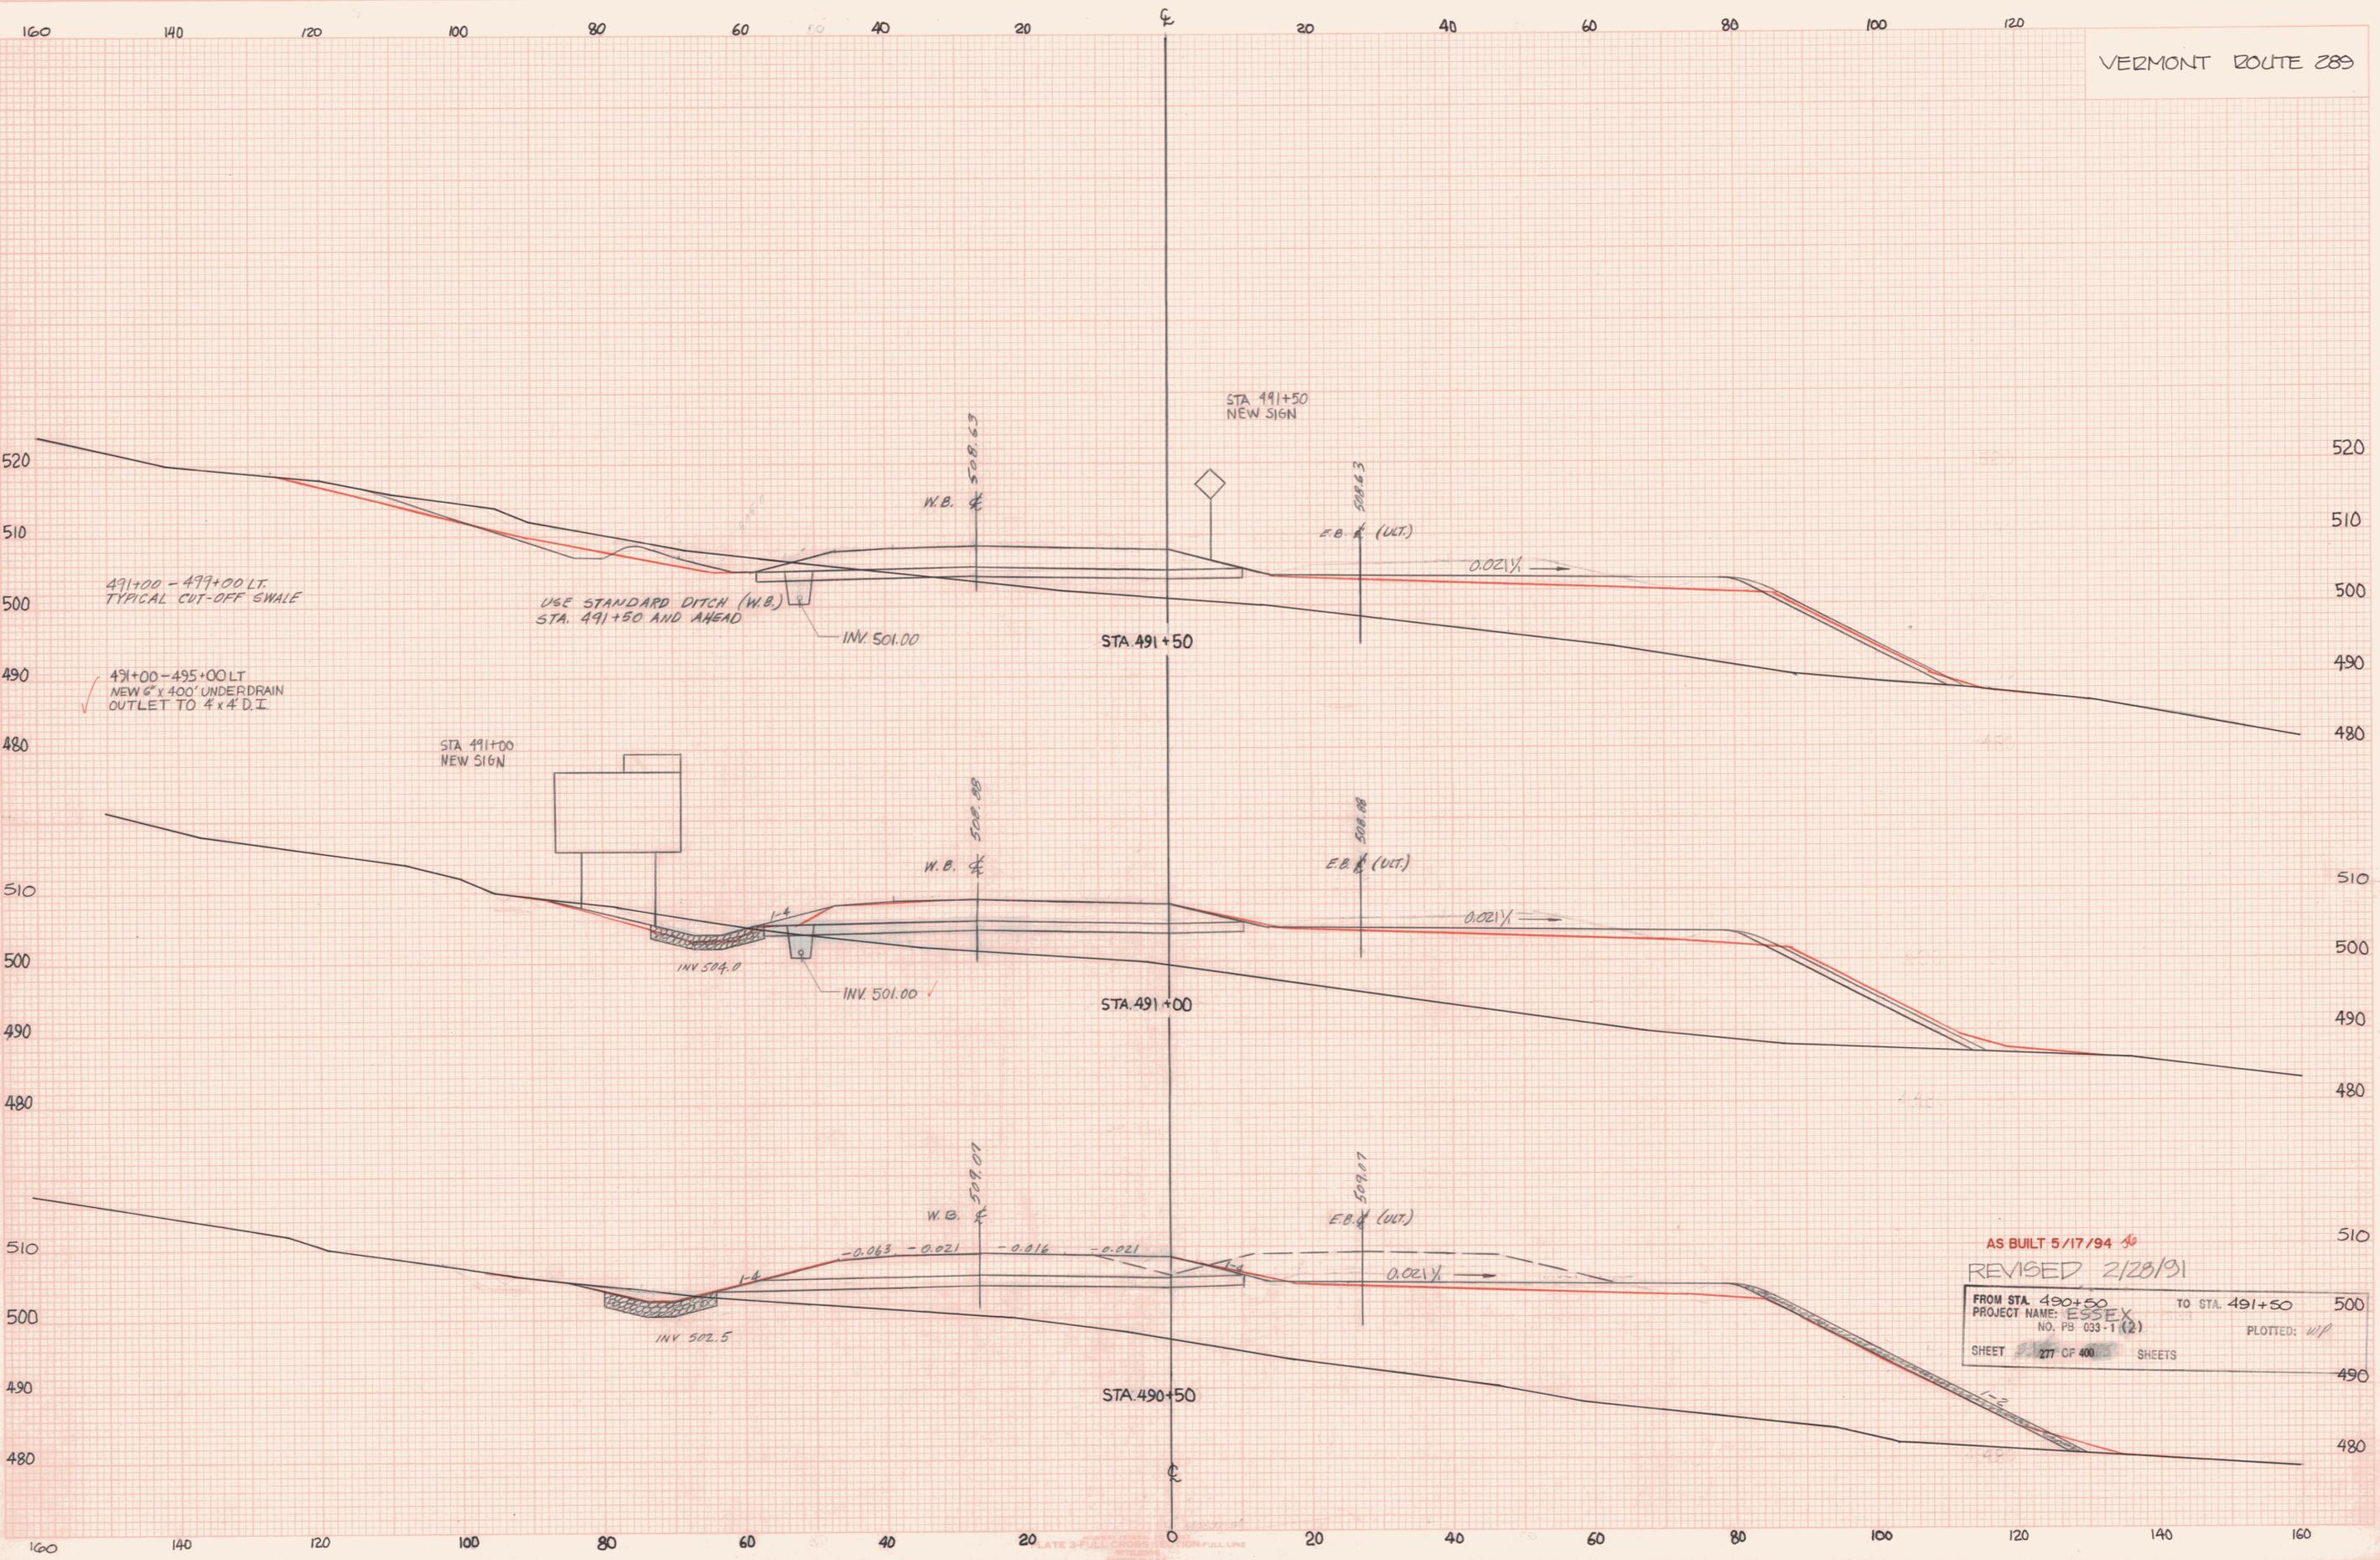

AS BUILT 5/17/94  
 REVISED 2/28/91  
 FROM STA. 490+50 TO STA. 491+50  
 PROJECT NAME: ESSEX  
 NO. PB 033-1 (2)  
 SHEET 277 OF 400 SHEETS  
 PLOTTED: W/P