


DATE: \_\_\_\_\_  
 BY: \_\_\_\_\_  
 ORIGINAL SURVEY: \_\_\_\_\_  
 REVISIONS: \_\_\_\_\_

DATE: \_\_\_\_\_  
 BY: \_\_\_\_\_  
 ORIGINAL SURVEY: \_\_\_\_\_  
 REVISIONS: \_\_\_\_\_

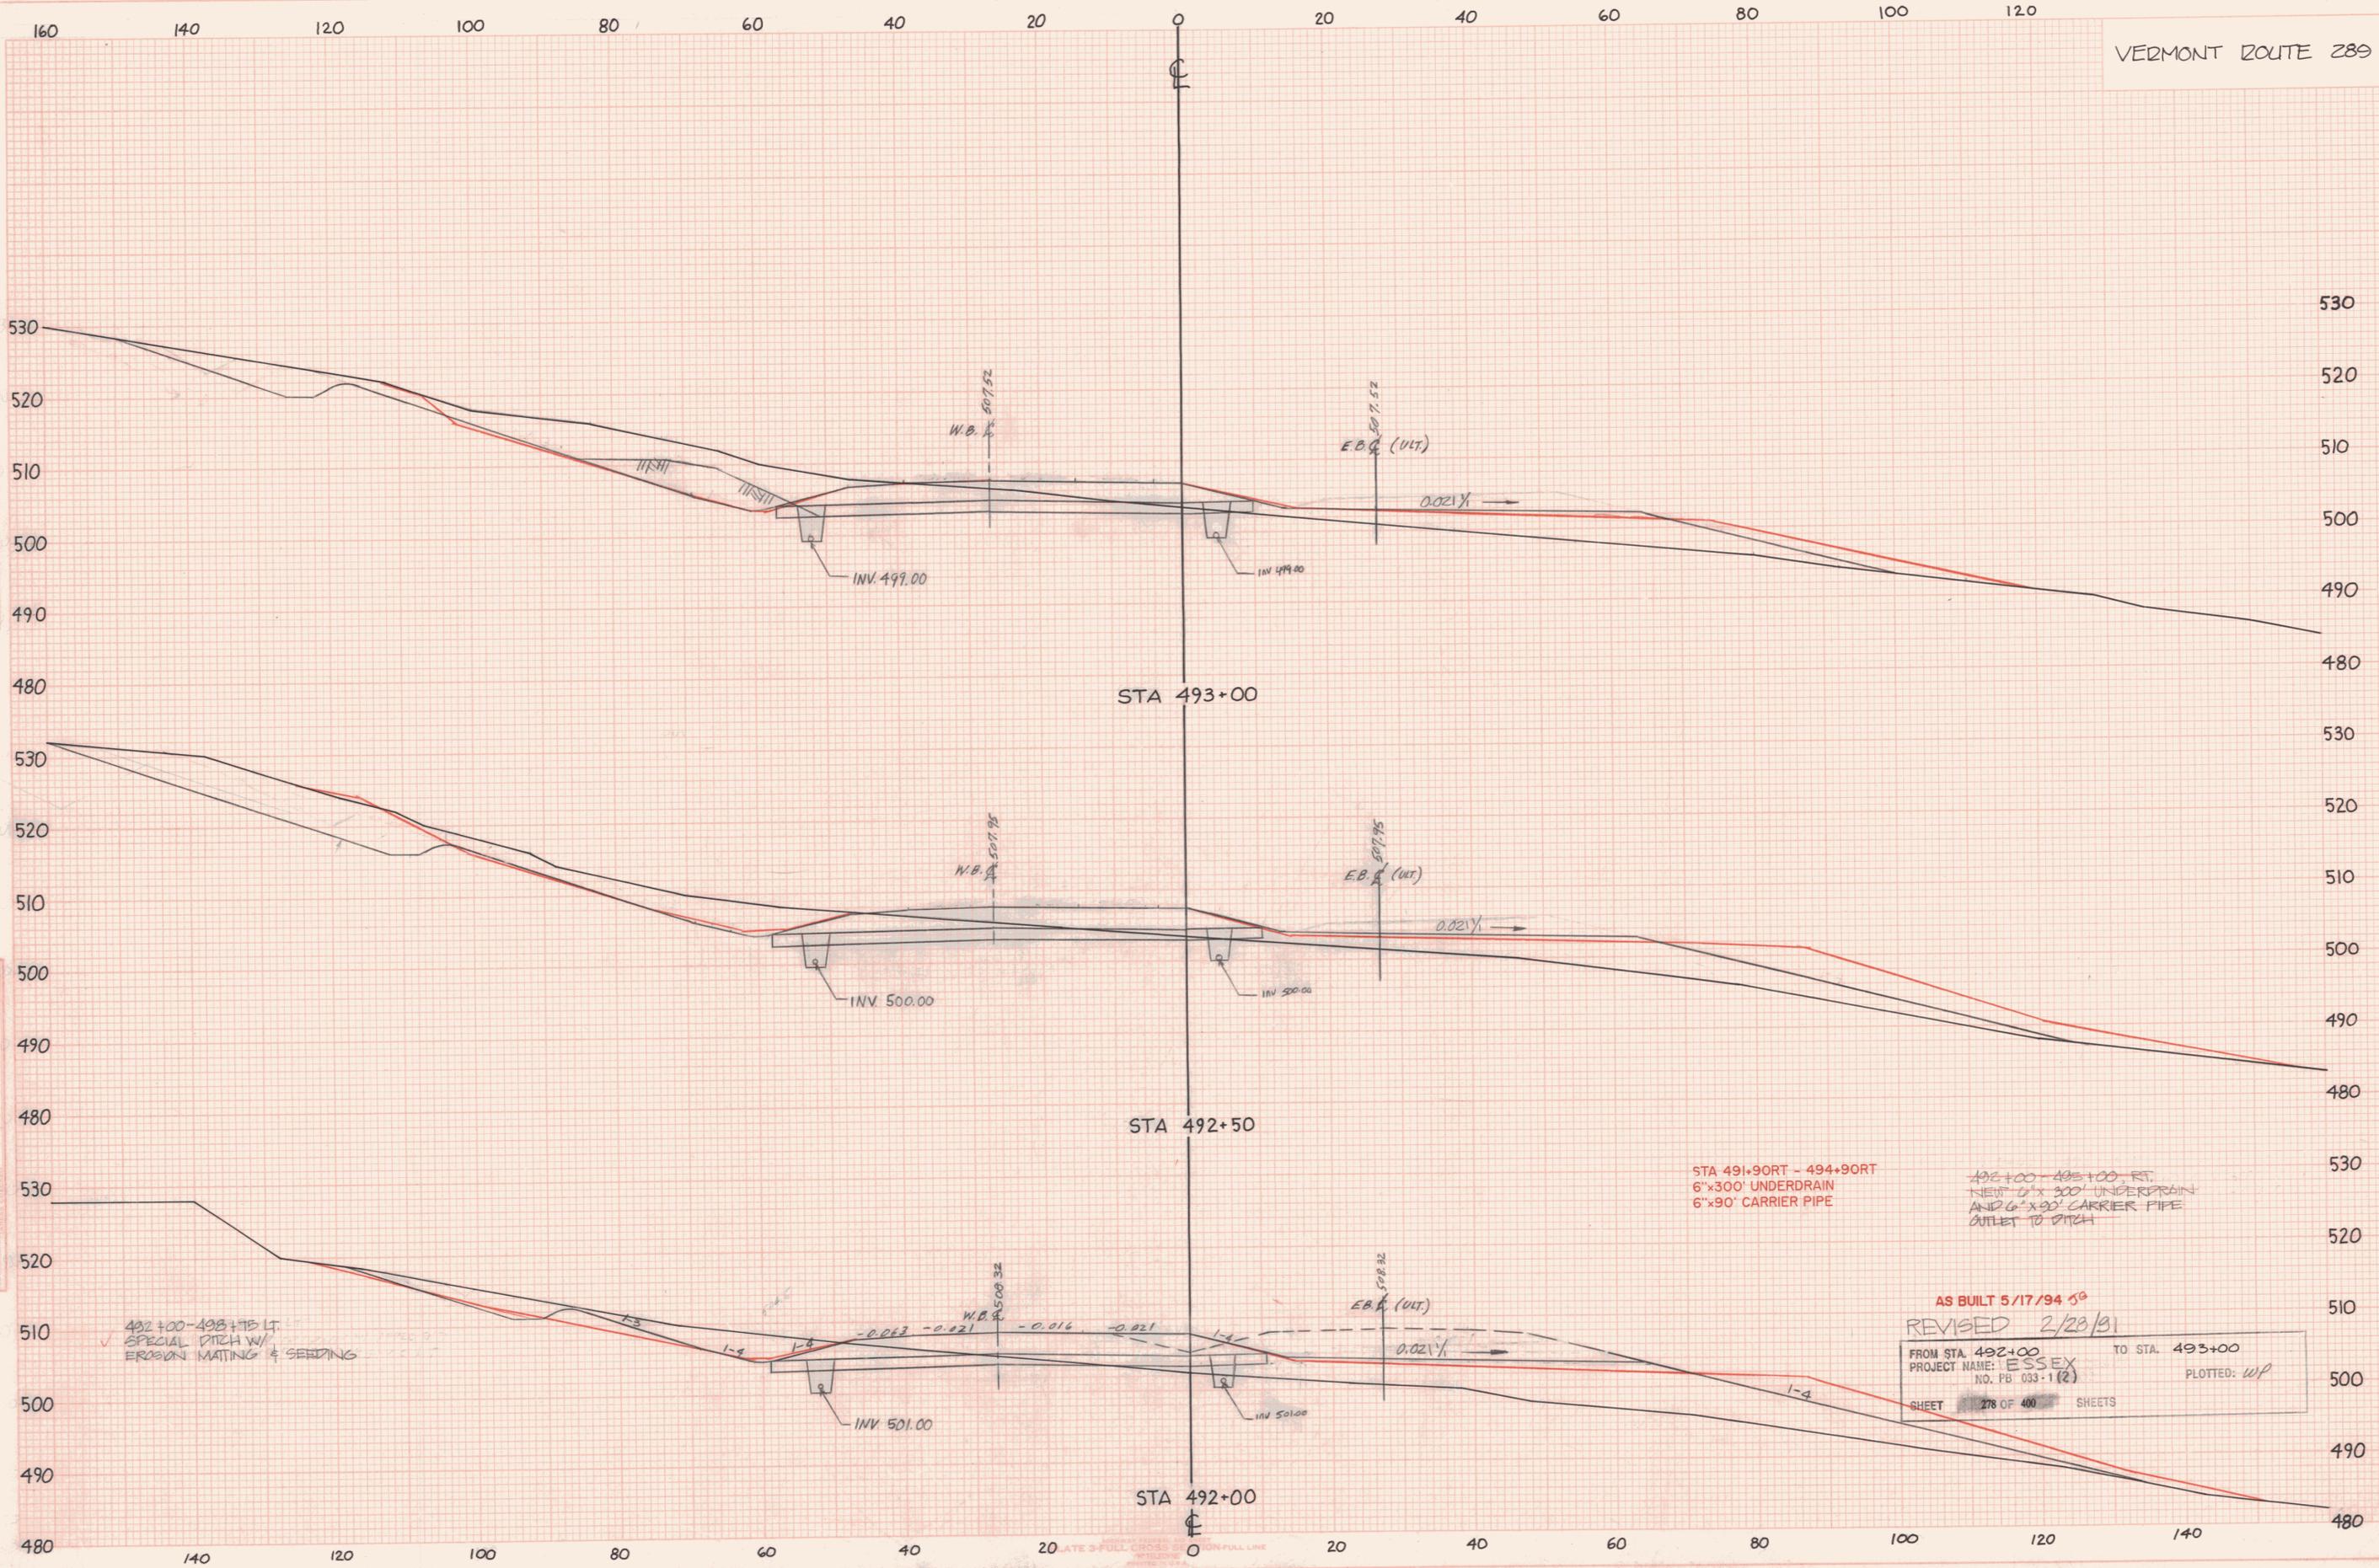

AS BUILT 5/17/94 <sup>50</sup>  
 REVISED 2/28/91  
 FROM STA. 492+00 TO STA. 493+00  
 PROJECT NAME: ESSEX  
 NO. PG. 033-1 (2) PLOTTED: WP  
 SHEET 278 OF 400 SHEETS