


FINAL SURVEY MAPS  
NOTE BOOK NO. 1000000000

ORIGINAL SURVEY MAPS  
NOTE BOOK NO. 1000000000

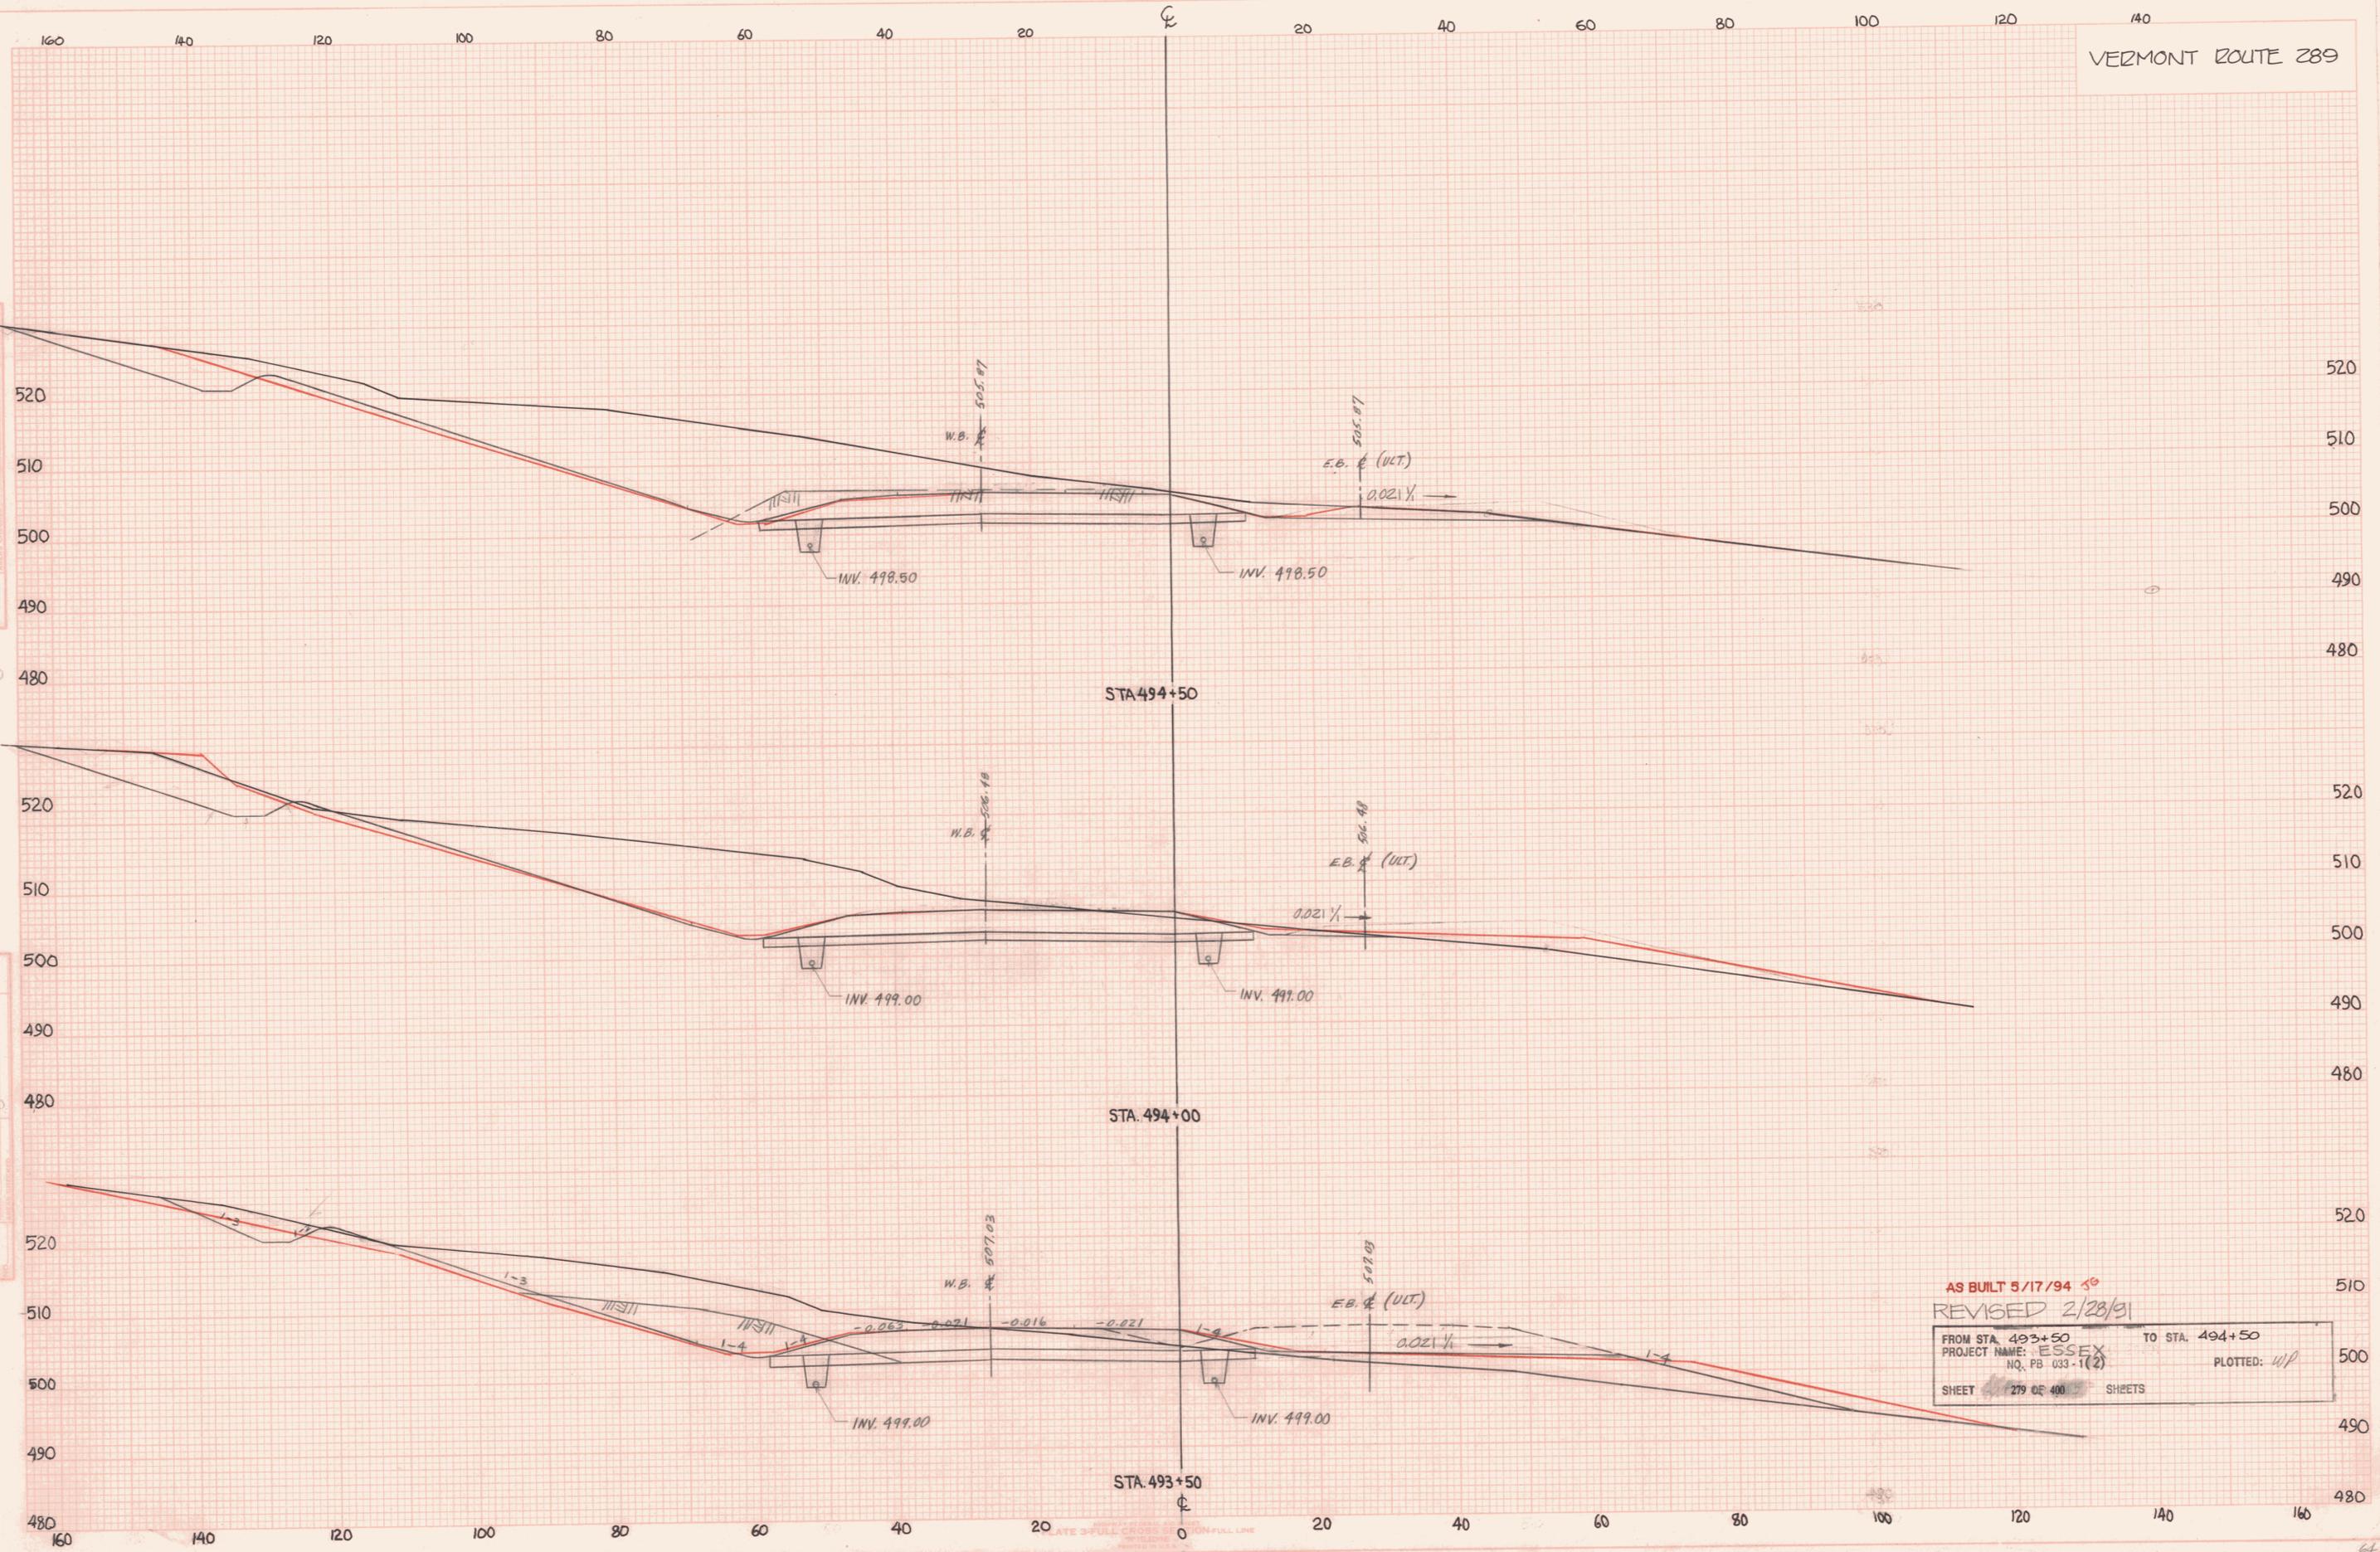

AS BUILT 5/17/94  
 REVISED 2/28/91  
 FROM STA. 493+50 TO STA. 494+50  
 PROJECT NAME: ESSEX  
 NQ. PB. 033-1(2)  
 SHEET 279 OF 400 SHEETS  
 PLOTTED: WP