


FINAL SURVEY
 BY: []
 DATE: []
 CHECKED: []
 NO. OF SHEETS: []
 NO. OF BOOK: []
 NO. OF SHEETS CHECKED: []

ORIGINAL SURVEY
 BY: []
 DATE: []
 CHECKED: []
 NO. OF SHEETS: []
 NO. OF BOOK: []
 NO. OF SHEETS CHECKED: []

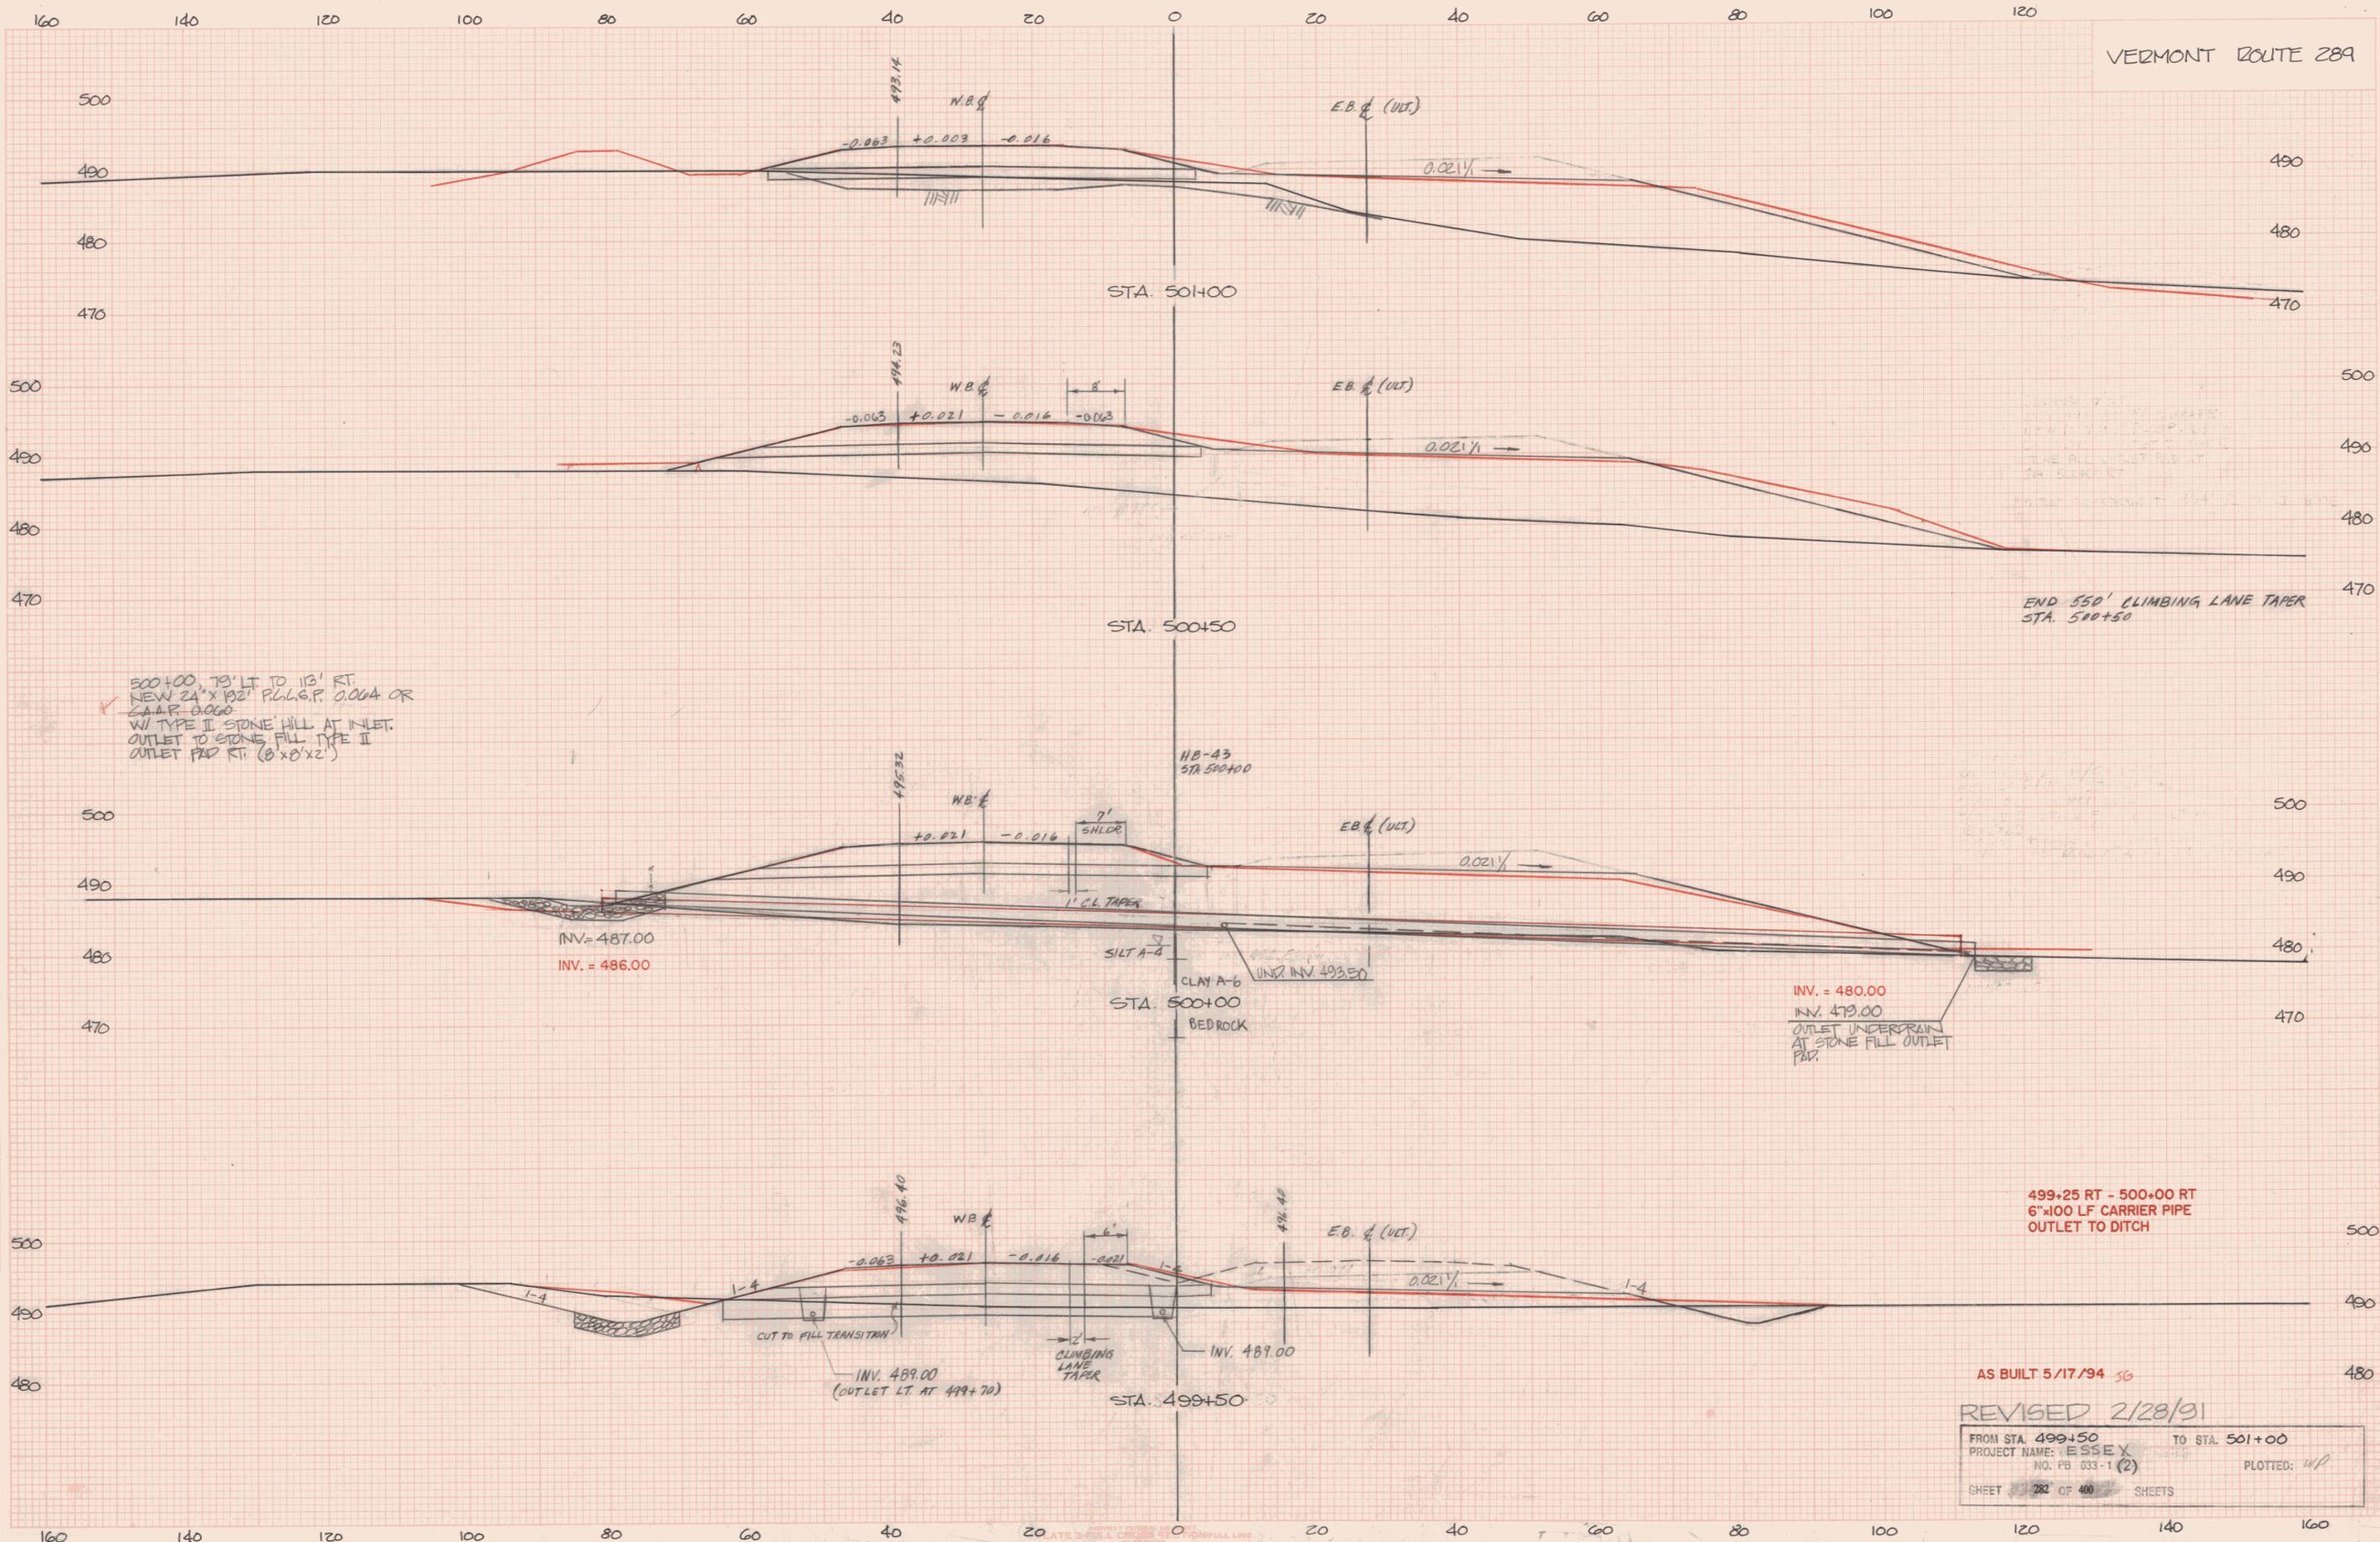

500+00, 73' LT TO 113' RT.
 NEW 24" x 192" P.C.L.G.P. 0.004 OR
 S.A.P. 0.000
 W/ TYPE II STONE FILL AT INLET.
 OUTLET TO STONE FILL TYPE II
 OUTLET PAD RT. (8' x 8' x 2')

END 550' CLIMBING LANE TAPER
 STA. 500+50

INV. = 480.00
 INV. = 479.00
 OUTLET UNDERDRAIN
 AT STONE FILL OUTLET
 PAD.

499+25 RT - 500+00 RT
 6"x100 LF CARRIER PIPE
 OUTLET TO DITCH

AS BUILT 5/17/94 SG
 REVISED 2/28/91
 FROM STA. 499+50 TO STA. 501+00
 PROJECT NAME: ESSEX
 NO. PB 033-1 (2) PLOTTED: wp
 SHEET 282 OF 400 SHEETS