


VERMONT ROUTE 289

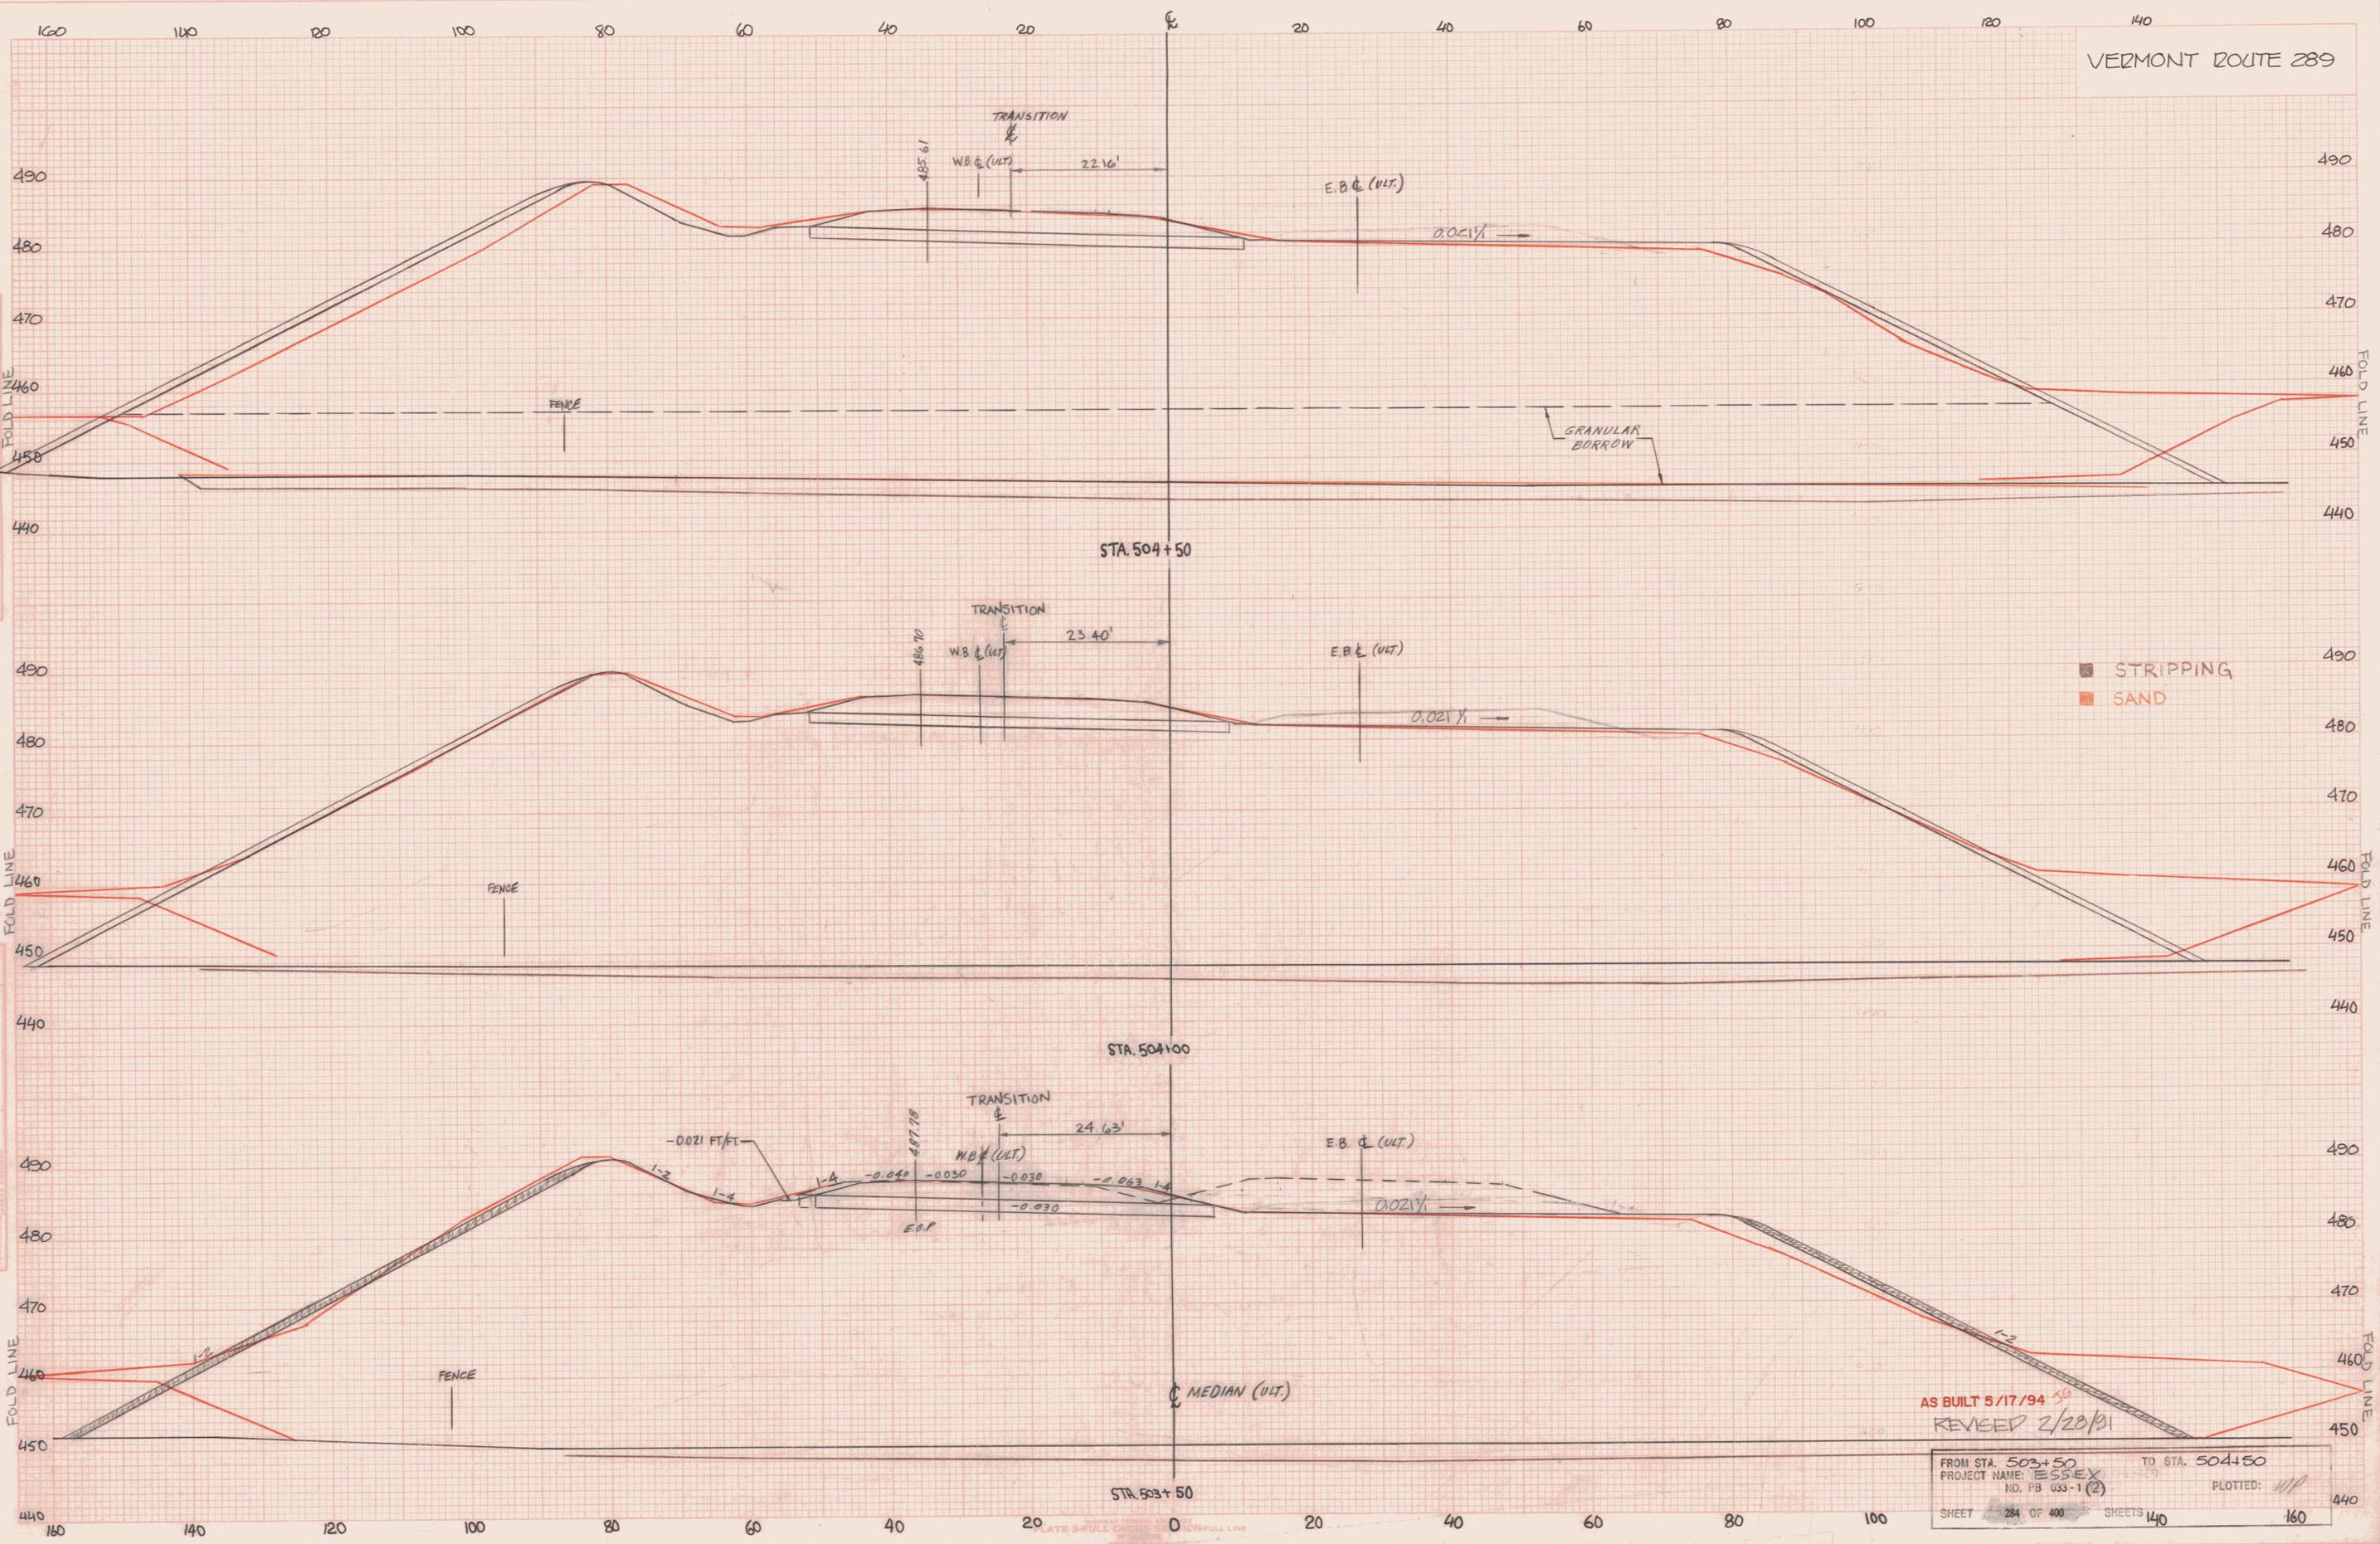

FINAL SURVEY  
 PLANNED  
 PLOTTED  
 NOTE BOOK  
 TEMPLATE  
 NO. 1000  
 AREAS CHANGED

ORIGINAL SURVEY  
 PLANNED  
 PLOTTED  
 NOTE BOOK  
 TEMPLATE  
 NO. 1000  
 AREAS CHANGED

AS BUILT 5/17/94 <sup>SB</sup>  
 REVISED 2/20/91

FROM STA. 503+50	TO STA. 504+50
PROJECT NAME: ESSEX	
NO. PB 033-1 (2)	
SHEET 284 OF 400	SHEETS 140
PLOTTED: <i>WJ</i>	