


FINAL SURVEY
 SURVEYED
 PLOTTED
 NOTE BOOK NO.
 TEMPLATE NO.
 DATE

ORIGINAL SURVEY
 SURVEYED
 PLOTTED
 NOTE BOOK NO.
 TEMPLATE NO.
 DATE

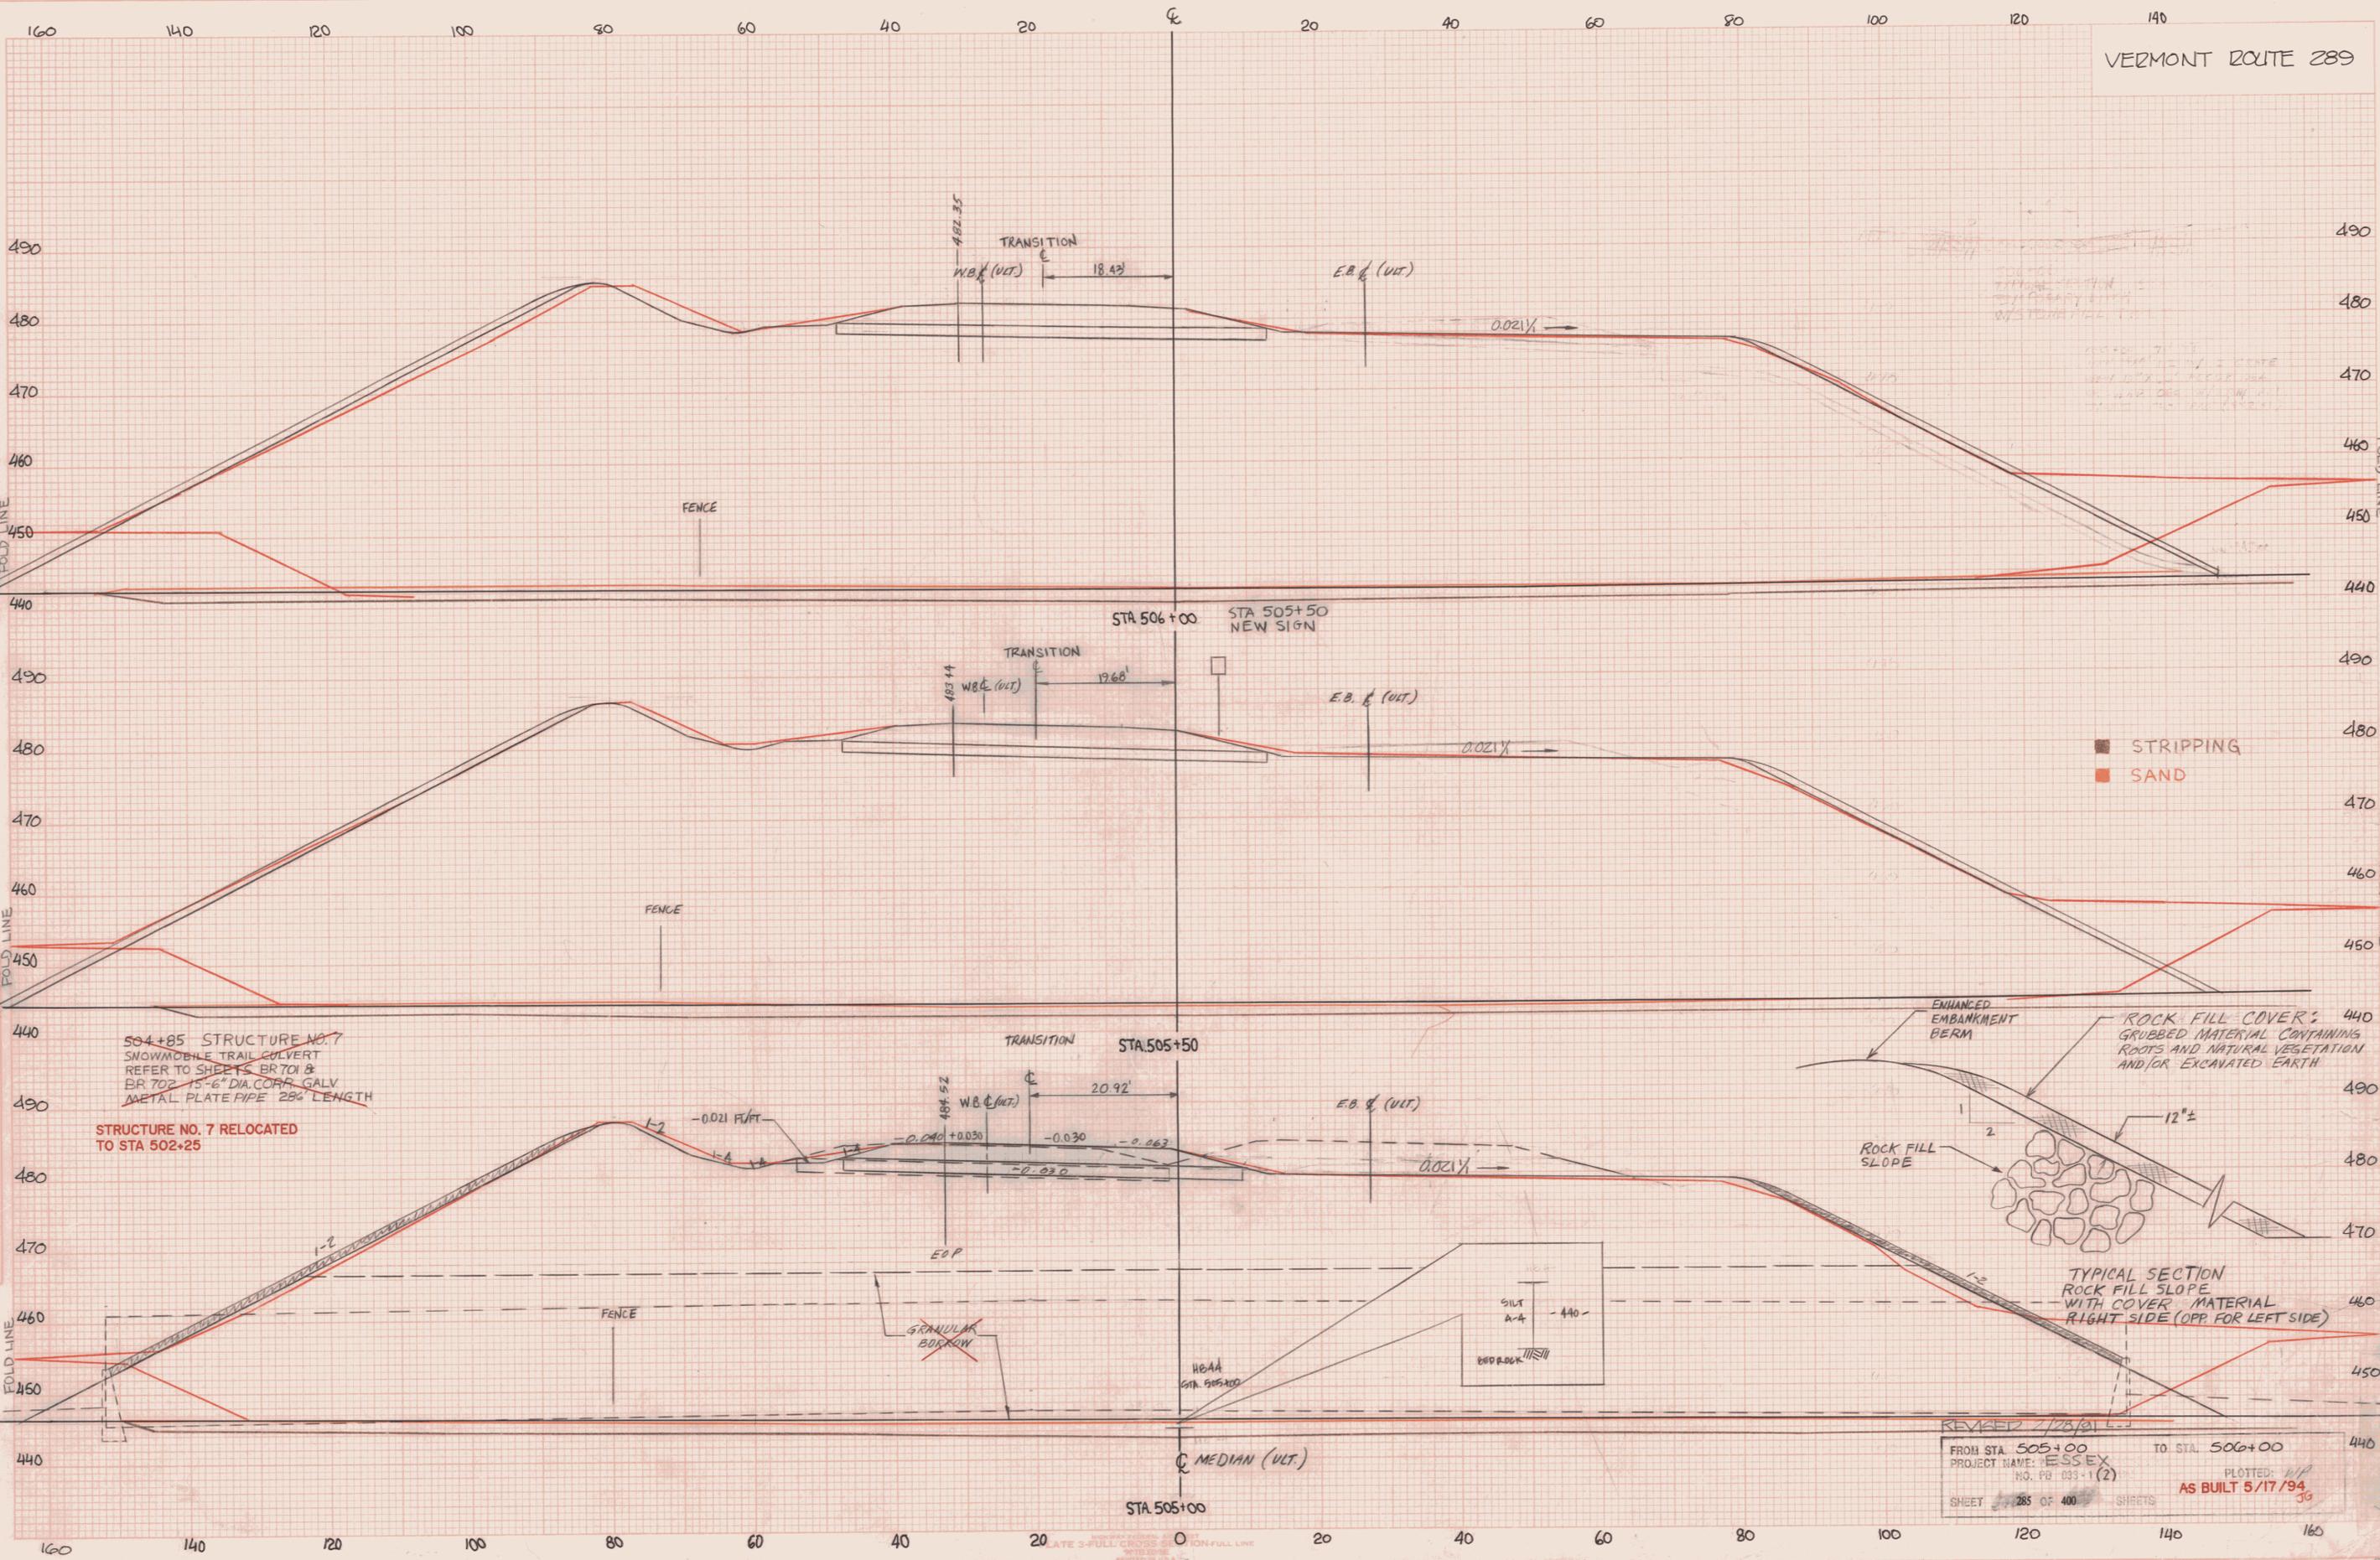

504+85 STRUCTURE NO. 7
 SNOWMOBILE TRAIL CULVERT
 REFER TO SHEETS BR 701 &
 BR 702 15'-6" DIA. CORR. GALV.
 METAL PLATE PIPE 286' LENGTH
 STRUCTURE NO. 7 RELOCATED
 TO STA 502+25

ENHANCED
 EMBANKMENT
 BERM
 ROCK FILL COVER:
 GRUBBED MATERIAL CONTAINING
 ROOTS AND NATURAL VEGETATION
 AND/OR EXCAVATED EARTH
 12"±
 ROCK FILL
 SLOPE
 TYPICAL SECTION
 ROCK FILL SLOPE
 WITH COVER MATERIAL
 RIGHT SIDE (OPP. FOR LEFT SIDE)

REVISION 7/28/91
 FROM STA. 505+00 TO STA. 506+00
 PROJECT NAME: ESSEX
 NO. PB 033-1 (2)
 SHEET 285 OF 400 SHEETS
 PLOTTED: W.P.
 AS BUILT 5/17/94
 30