


FINAL SURVEY BY: DATE: SURVEYED: PLOTTED: NOTE BOOK: TEMPLATE: NO. AREAS CHECKED:

ORIGINAL SURVEY BY: DATE: SURVEYED: PLOTTED: NOTE BOOK: TEMPLATE: NO. AREAS CHECKED:

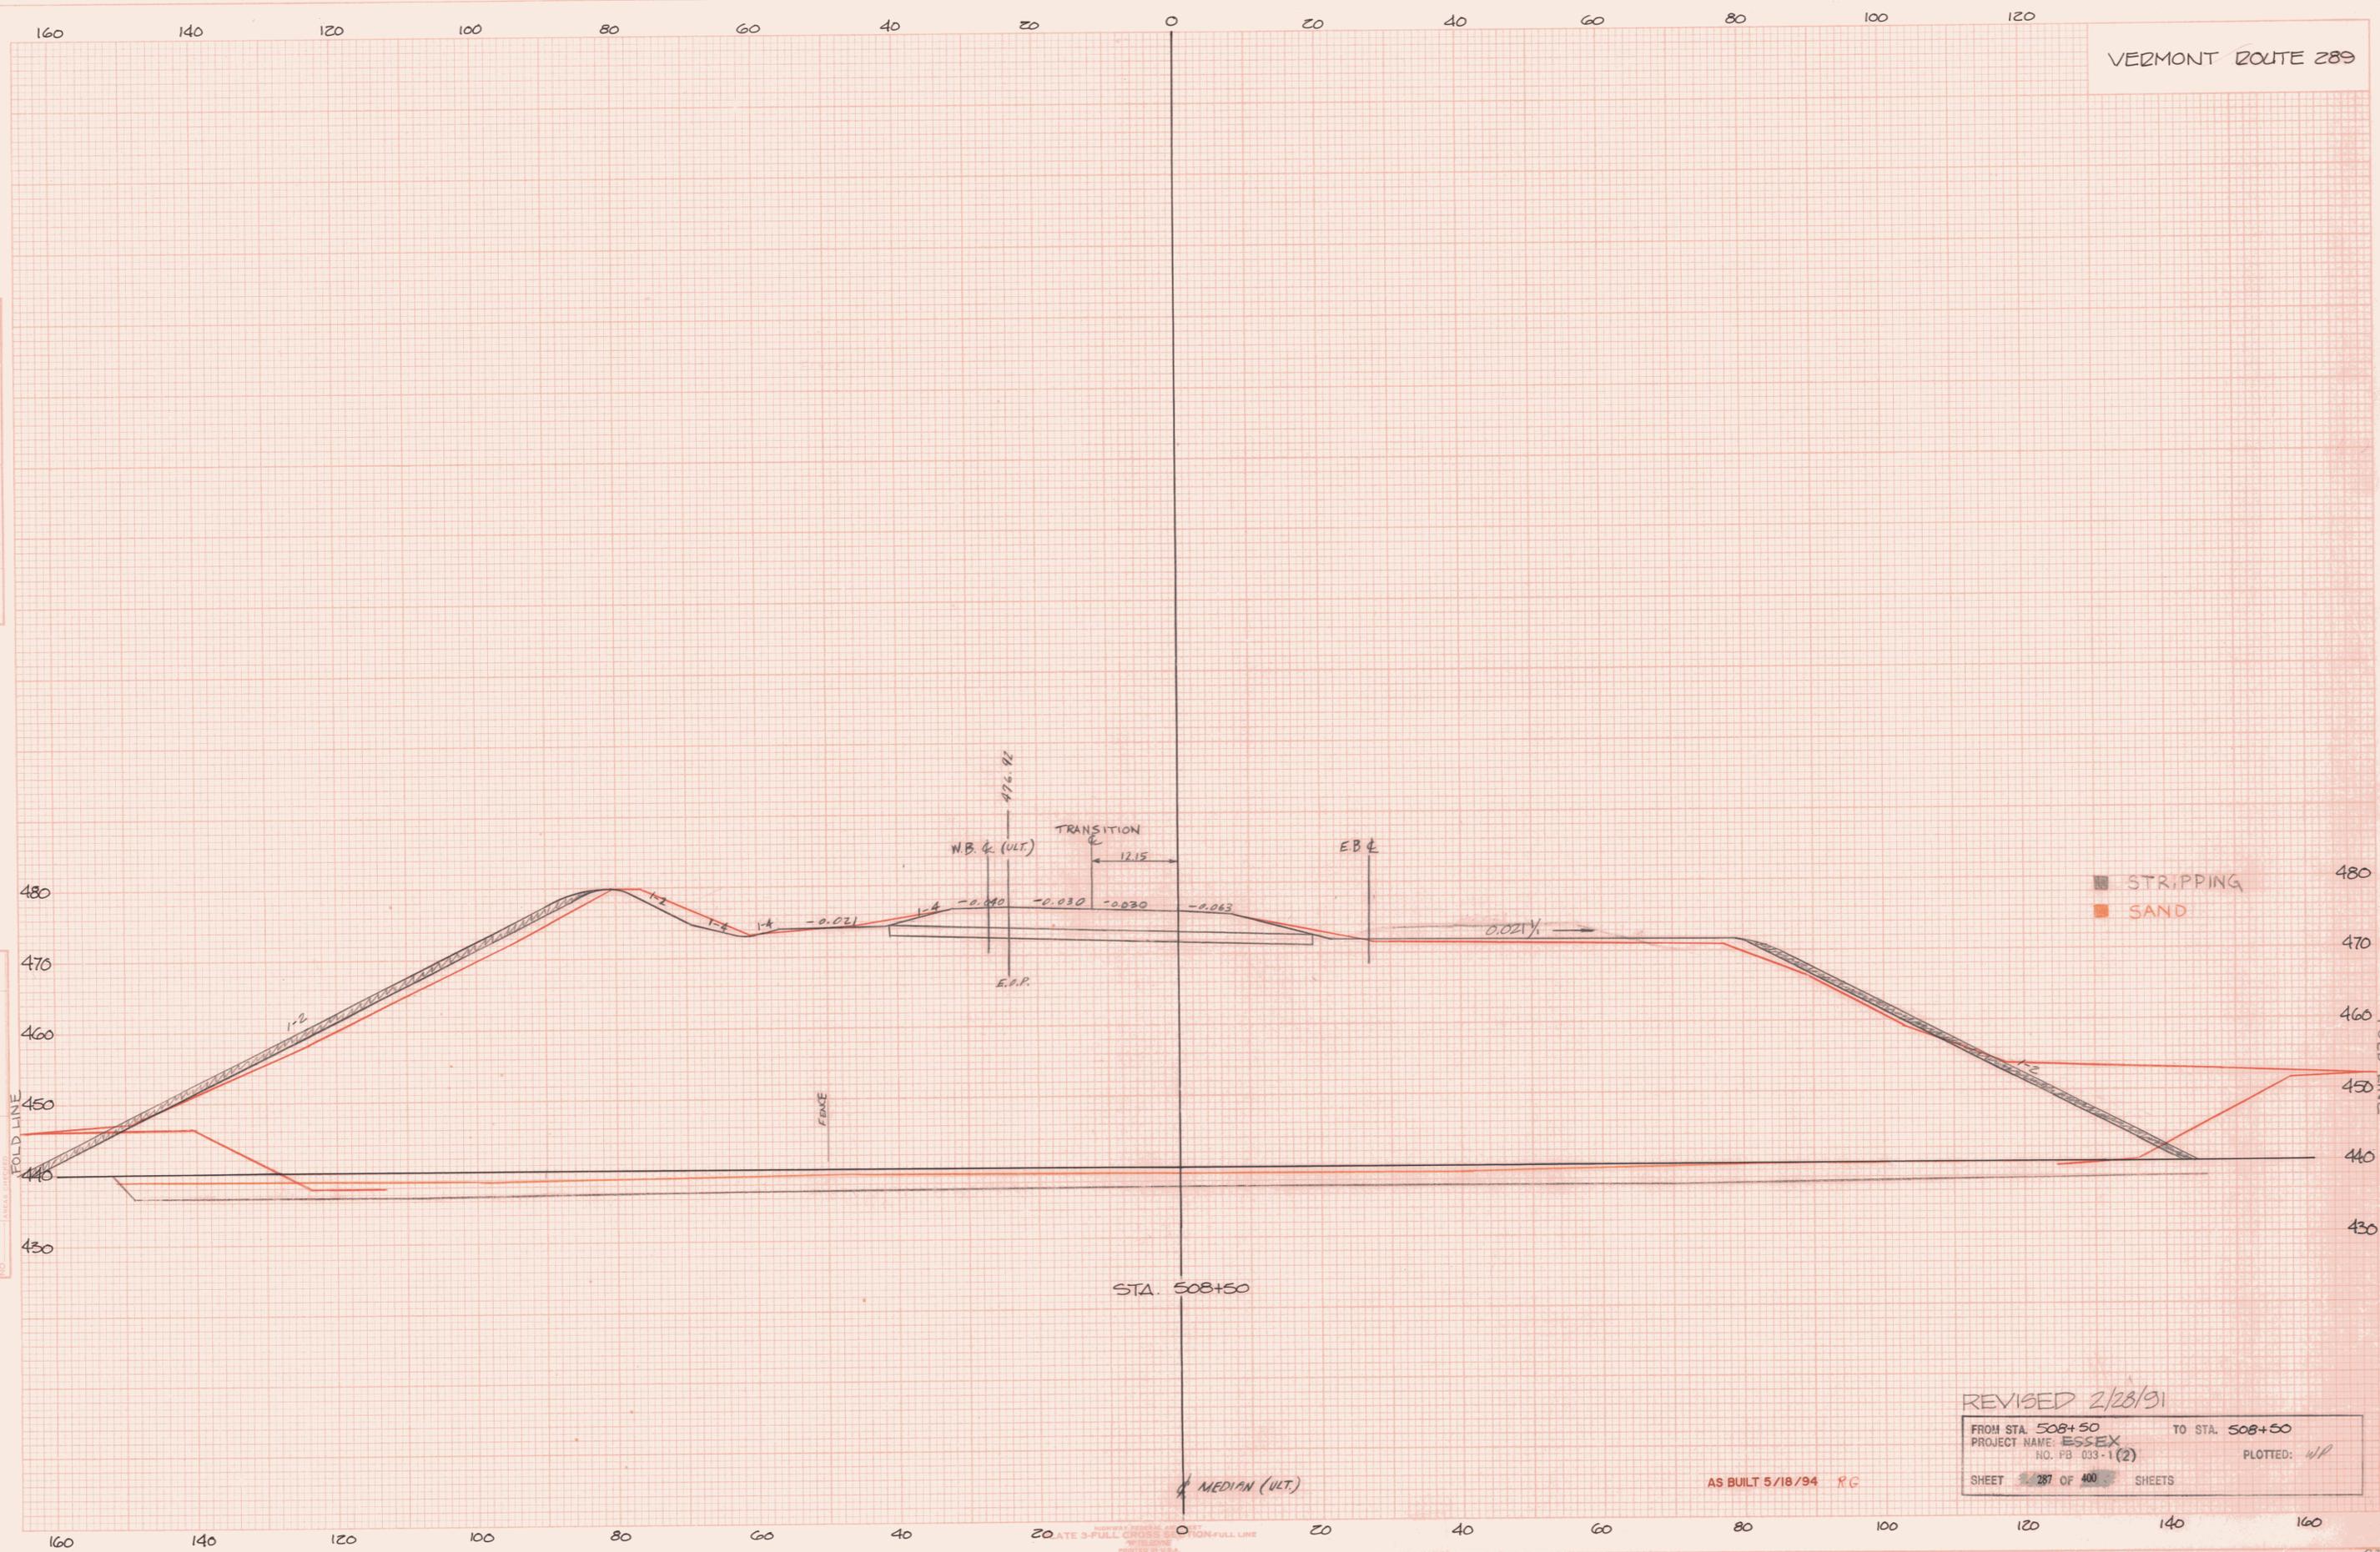

REVISED 2/28/91  
 FROM STA. 508+50 TO STA. 508+50  
 PROJECT NAME: ESSEX  
 NO. PB 033-1(2) PLOTTED: W/P  
 SHEET 287 OF 400 SHEETS

AS BUILT 5/18/94 RG