


VERMONT ROUTE 289

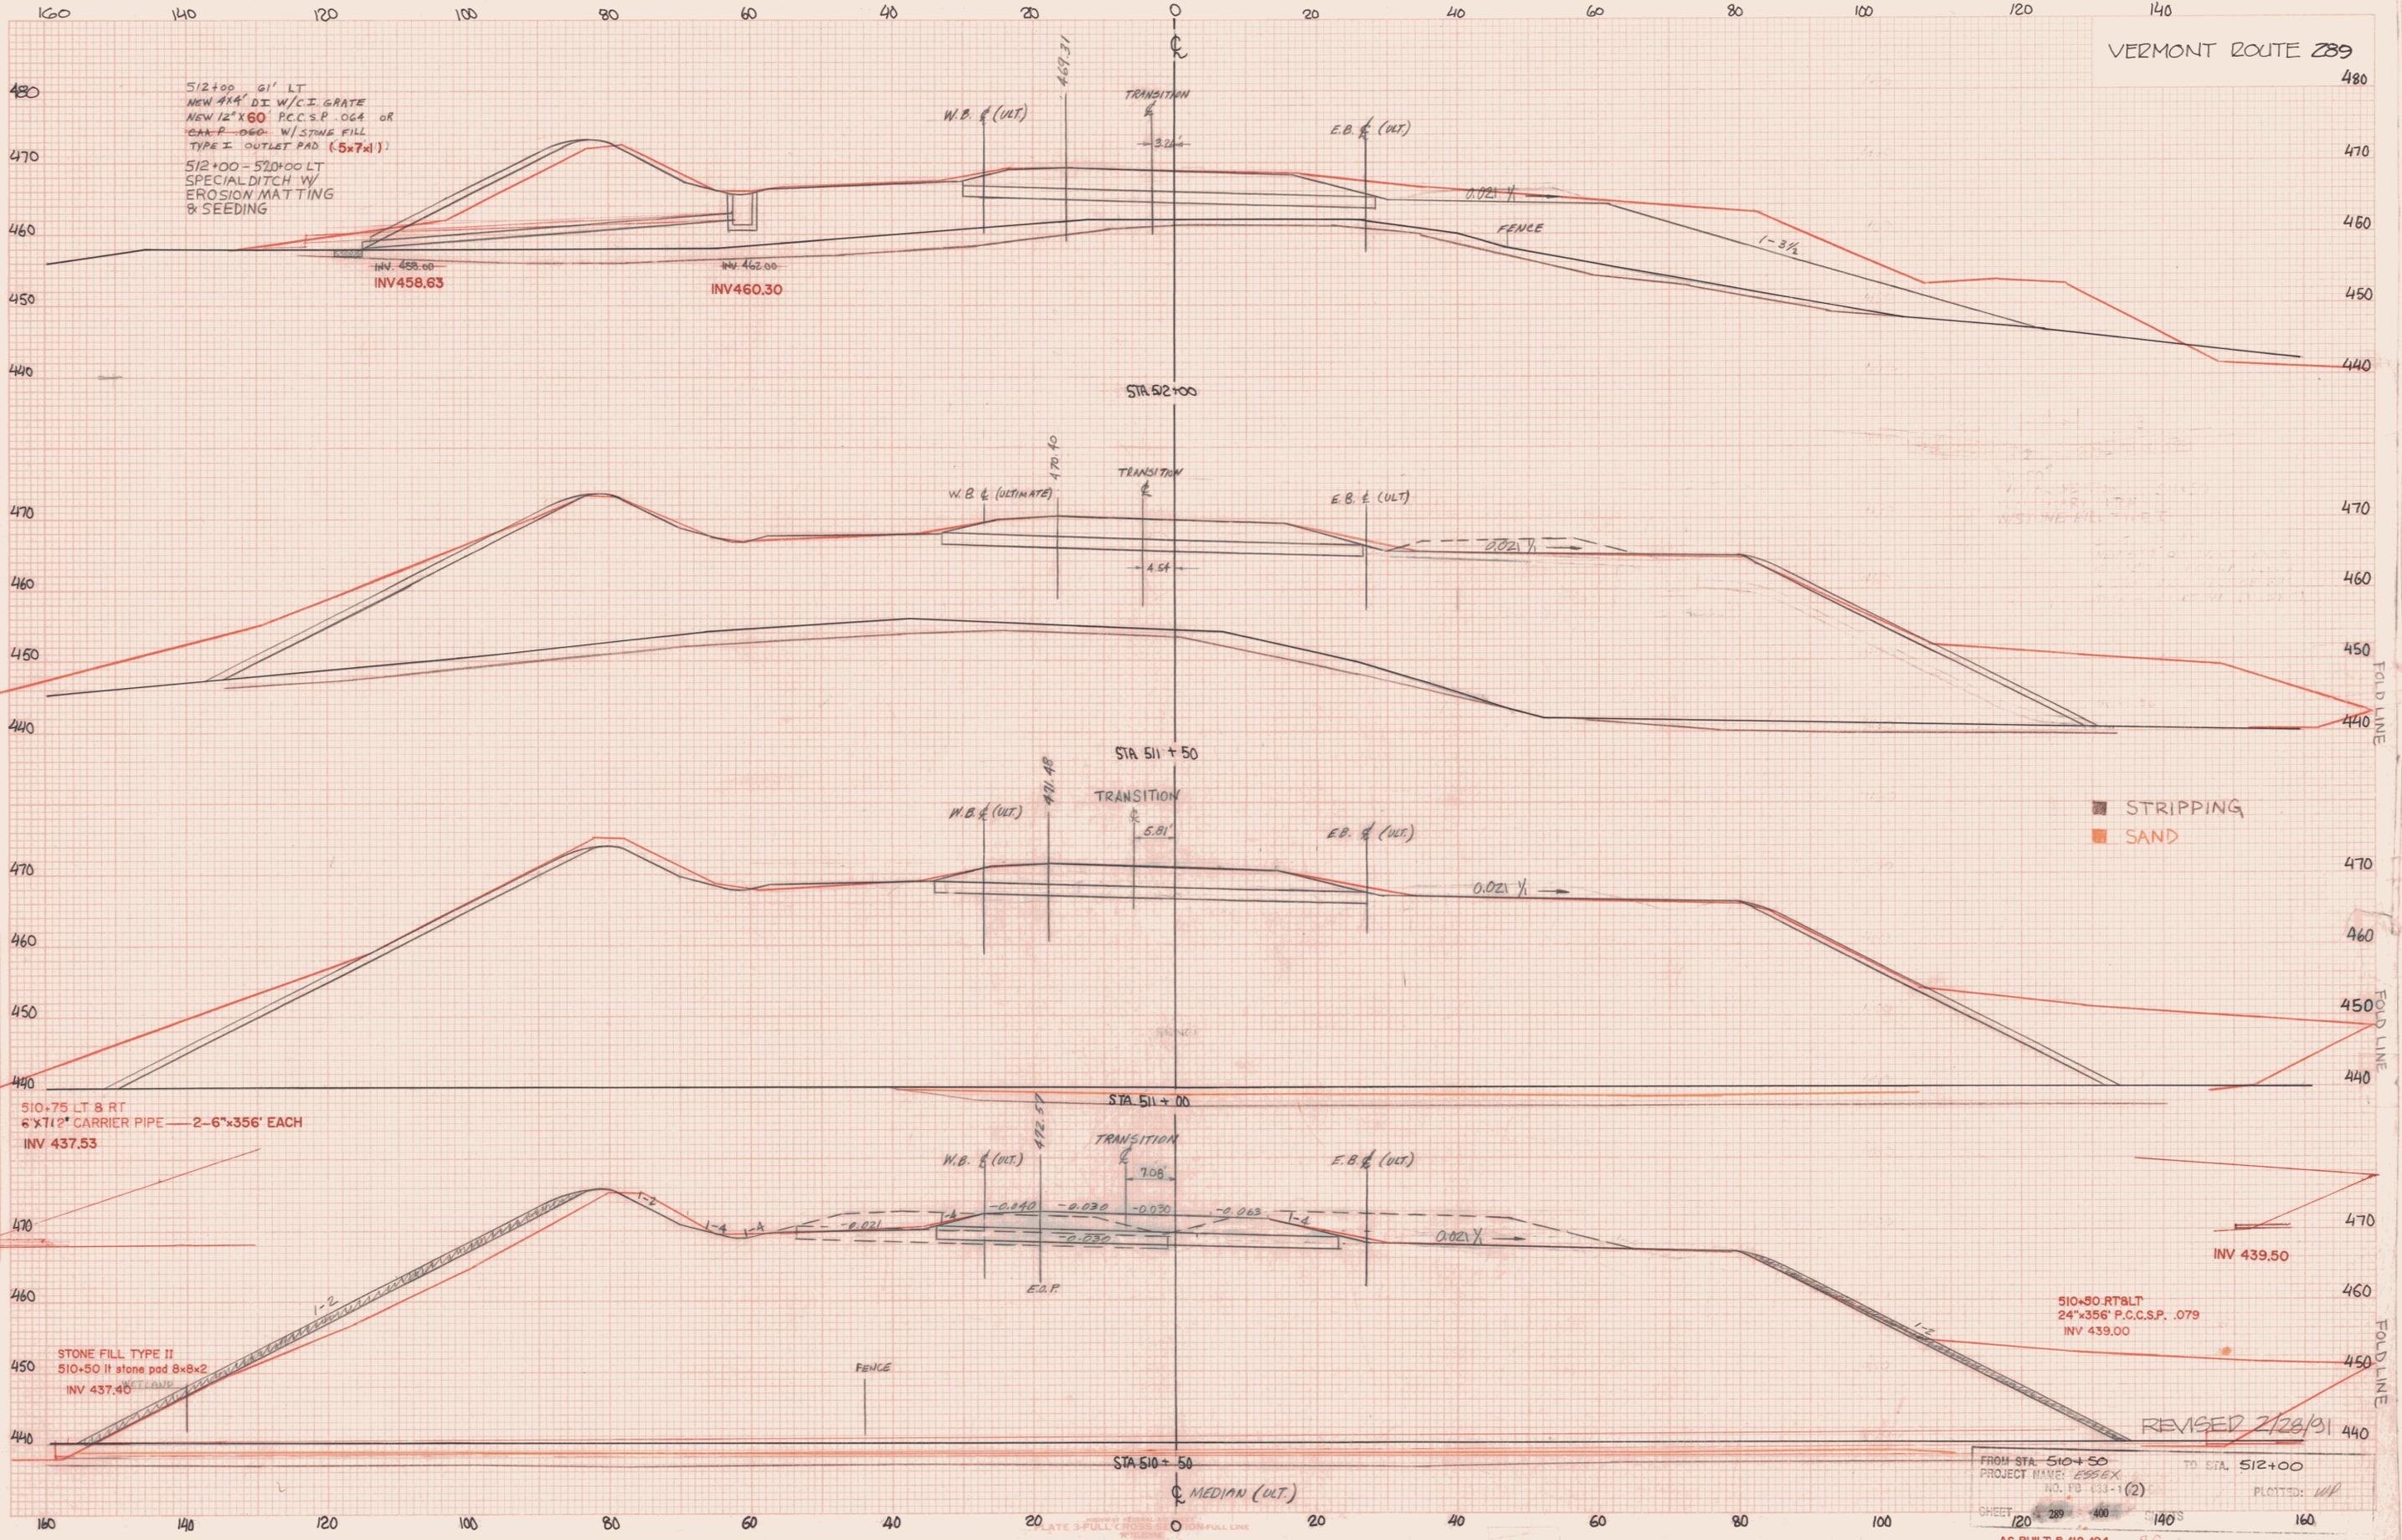

512+00 61' LT  
 NEW 4" DI W/C.I. GRATE  
 NEW 12" X 60" P.C.C.S.P. .064 OR  
 C.A.P. - 060" W/STONE FILL  
 TYPE I OUTLET PAD (5x7x1)  
 512+00 - 520+00 LT  
 SPECIAL DITCH W/  
 EROSION MATTING  
 & SEEDING

INV 458.00  
 INV 458.63

INV 462.00  
 INV 460.30

STA 512+00

TRANSITION  
 4.51'

STA 511+50

TRANSITION  
 5.91'

STA 511+00

TRANSITION  
 7.08'

STA 510+50

⊕ MEDIAN (ULT)

■ STRIPPING  
 ■ SAND

510+75 LT & RT  
 6" X 71/2" CARRIER PIPE - 2-6" X 356" EACH  
 INV 437.53

STONE FILL TYPE II  
 510+50 ft stone pad 8x8x2  
 INV 437.40

510+50 RT&LT  
 24" X 356" P.C.C.S.P. .079  
 INV 439.00

REVISED 2/28/91

FROM STA. 510+50 TO STA. 512+00  
 PROJECT NAME: ESSEX  
 NO. PD 133-1 (2)  
 SHEET 120 289 400 140'S 160  
 AS BUILT 5/18/94 R.G.  
 PLOTTED: W.P.