


DATE	
BY	
FINAL SURVEY	
SURVEYED	
PLOTTED	
TEMPLATE	
NOTE BOOK	
AREAS	
CHECKED	
NO.	

DATE	
BY	
ORIGINAL SURVEY	
SURVEYED	
PLOTTED	
TEMPLATE	
NOTE BOOK	
AREAS	
CHECKED	
NO.	

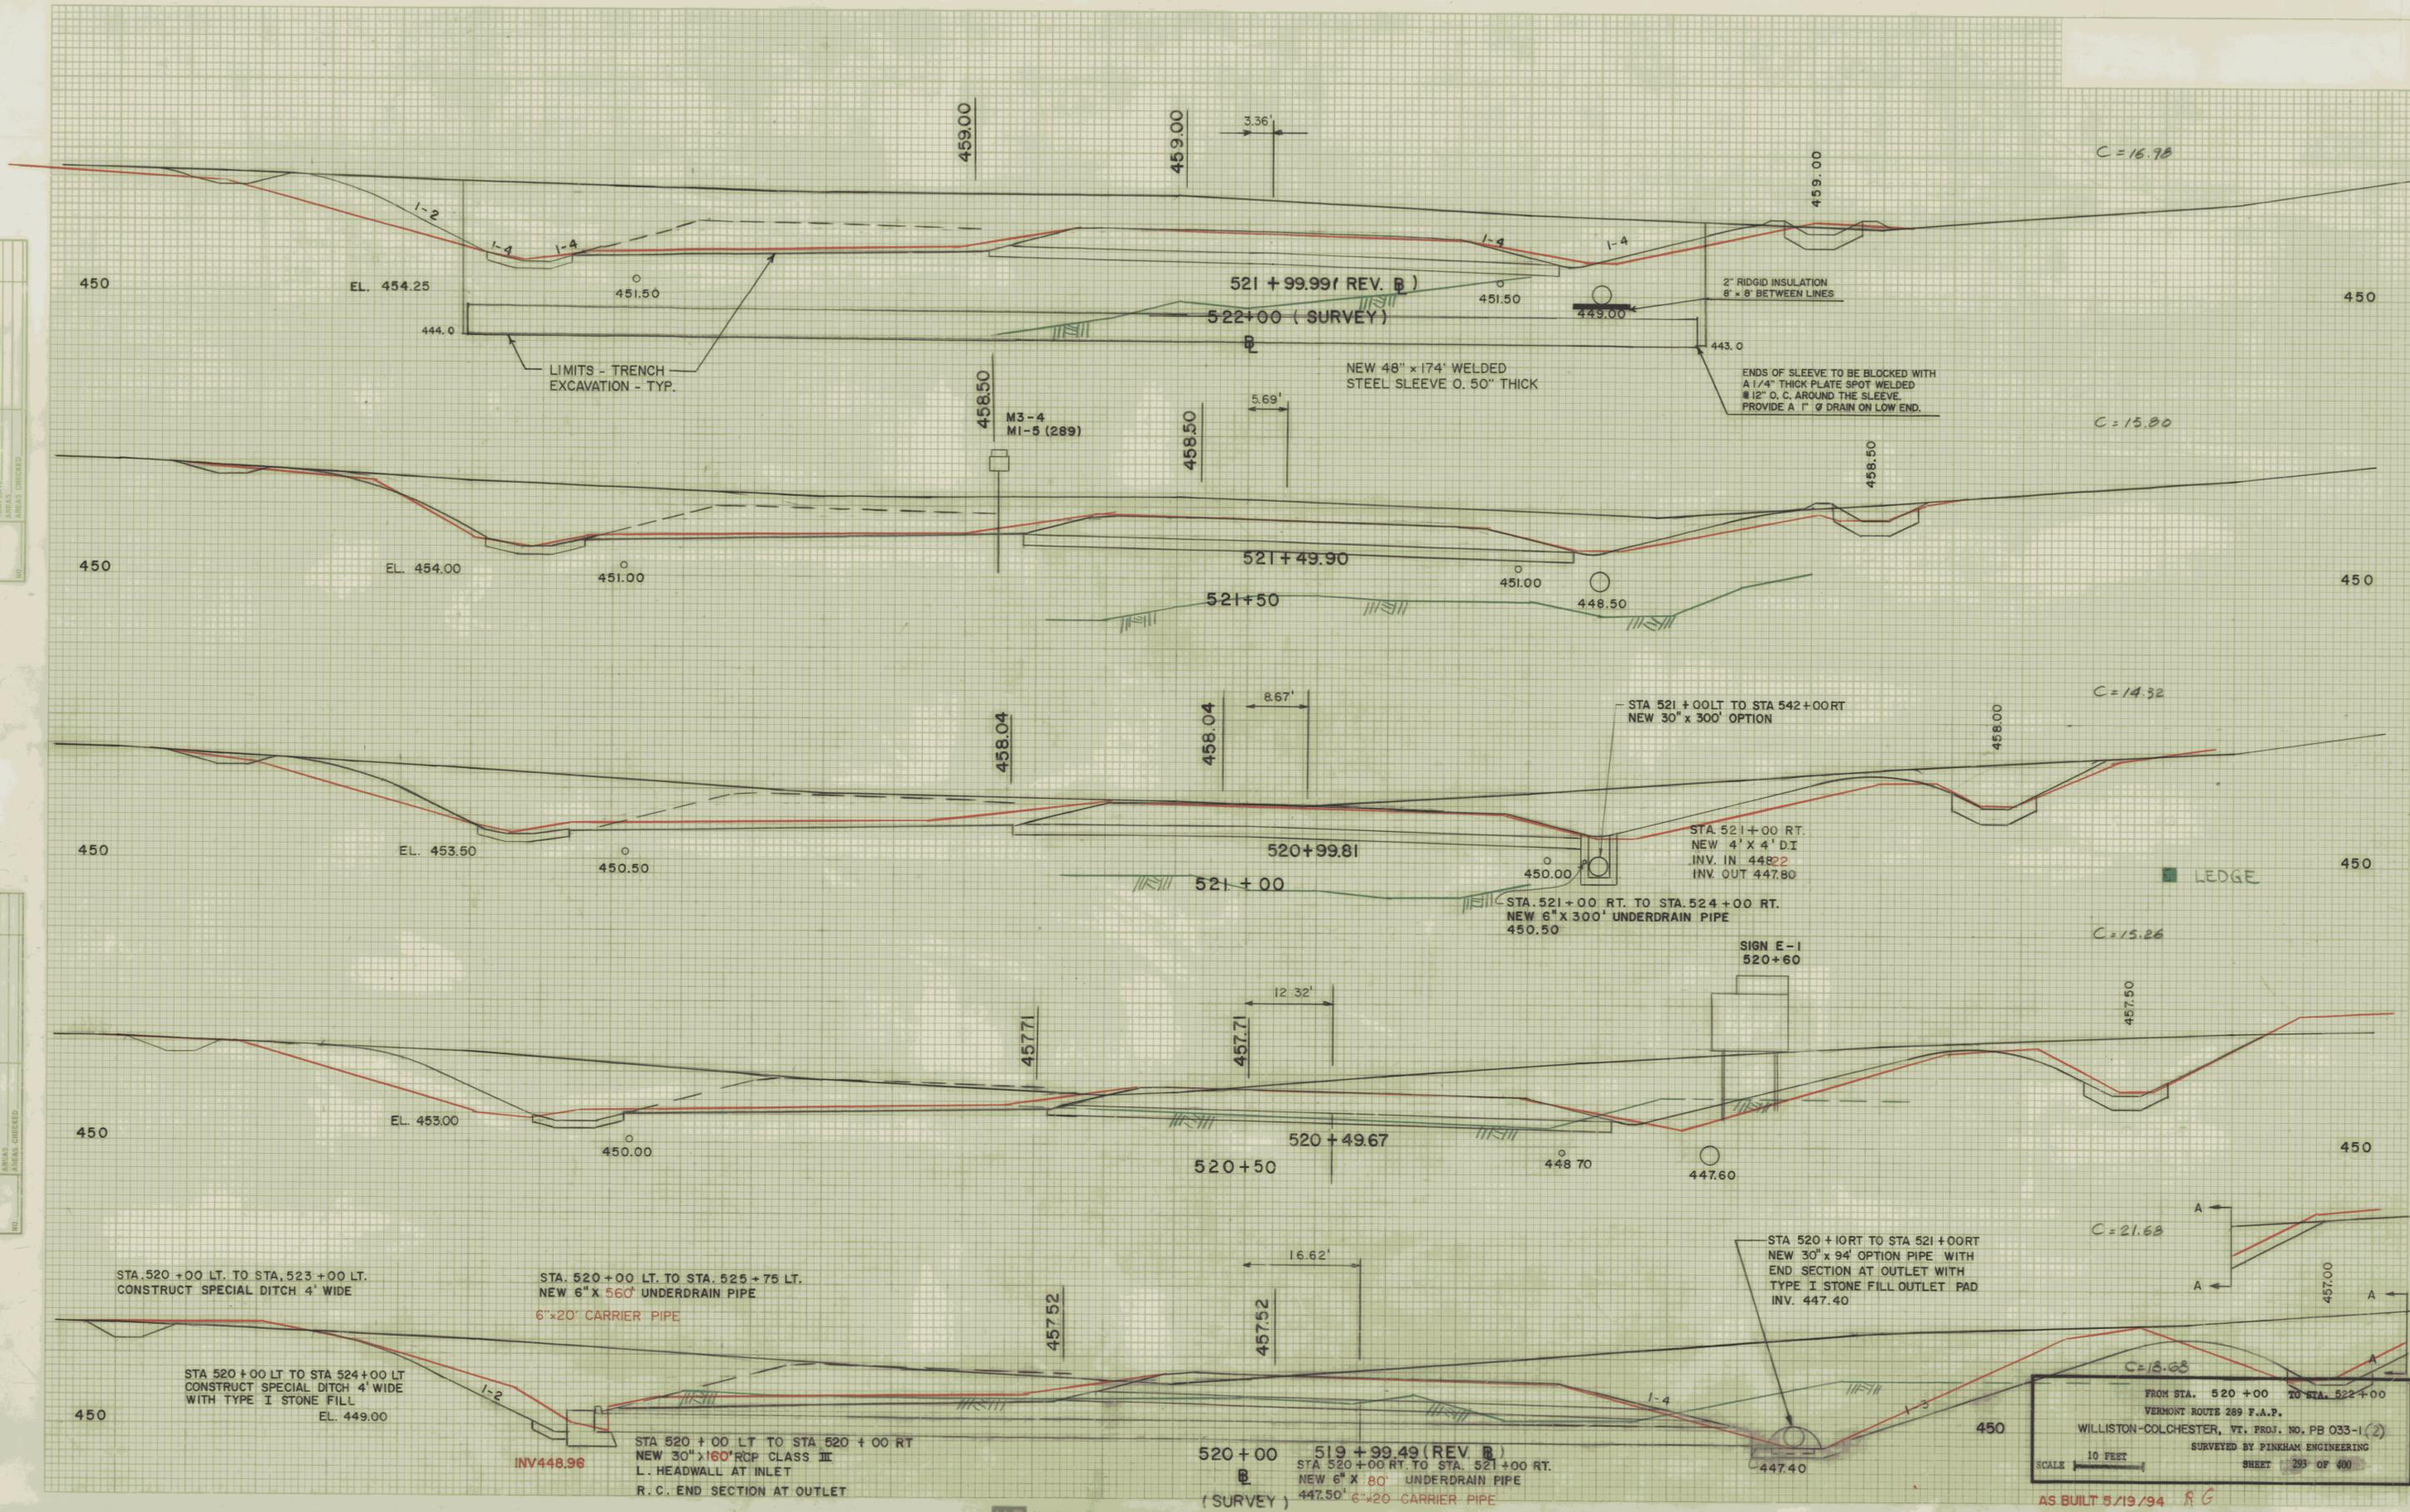

FROM STA. 520+00 TO STA. 522+00
 VERMONT ROUTE 289 P.A.P.
 WILLISTON-COLCHESTER, VT. PROJ. NO. PB 033-1(2)
 SURVEYED BY PINKHAM ENGINEERING
 SCALE 10 FEET SHEET 293 OF 400

AS BUILT 5/19/94 R G