


FOLD LINE

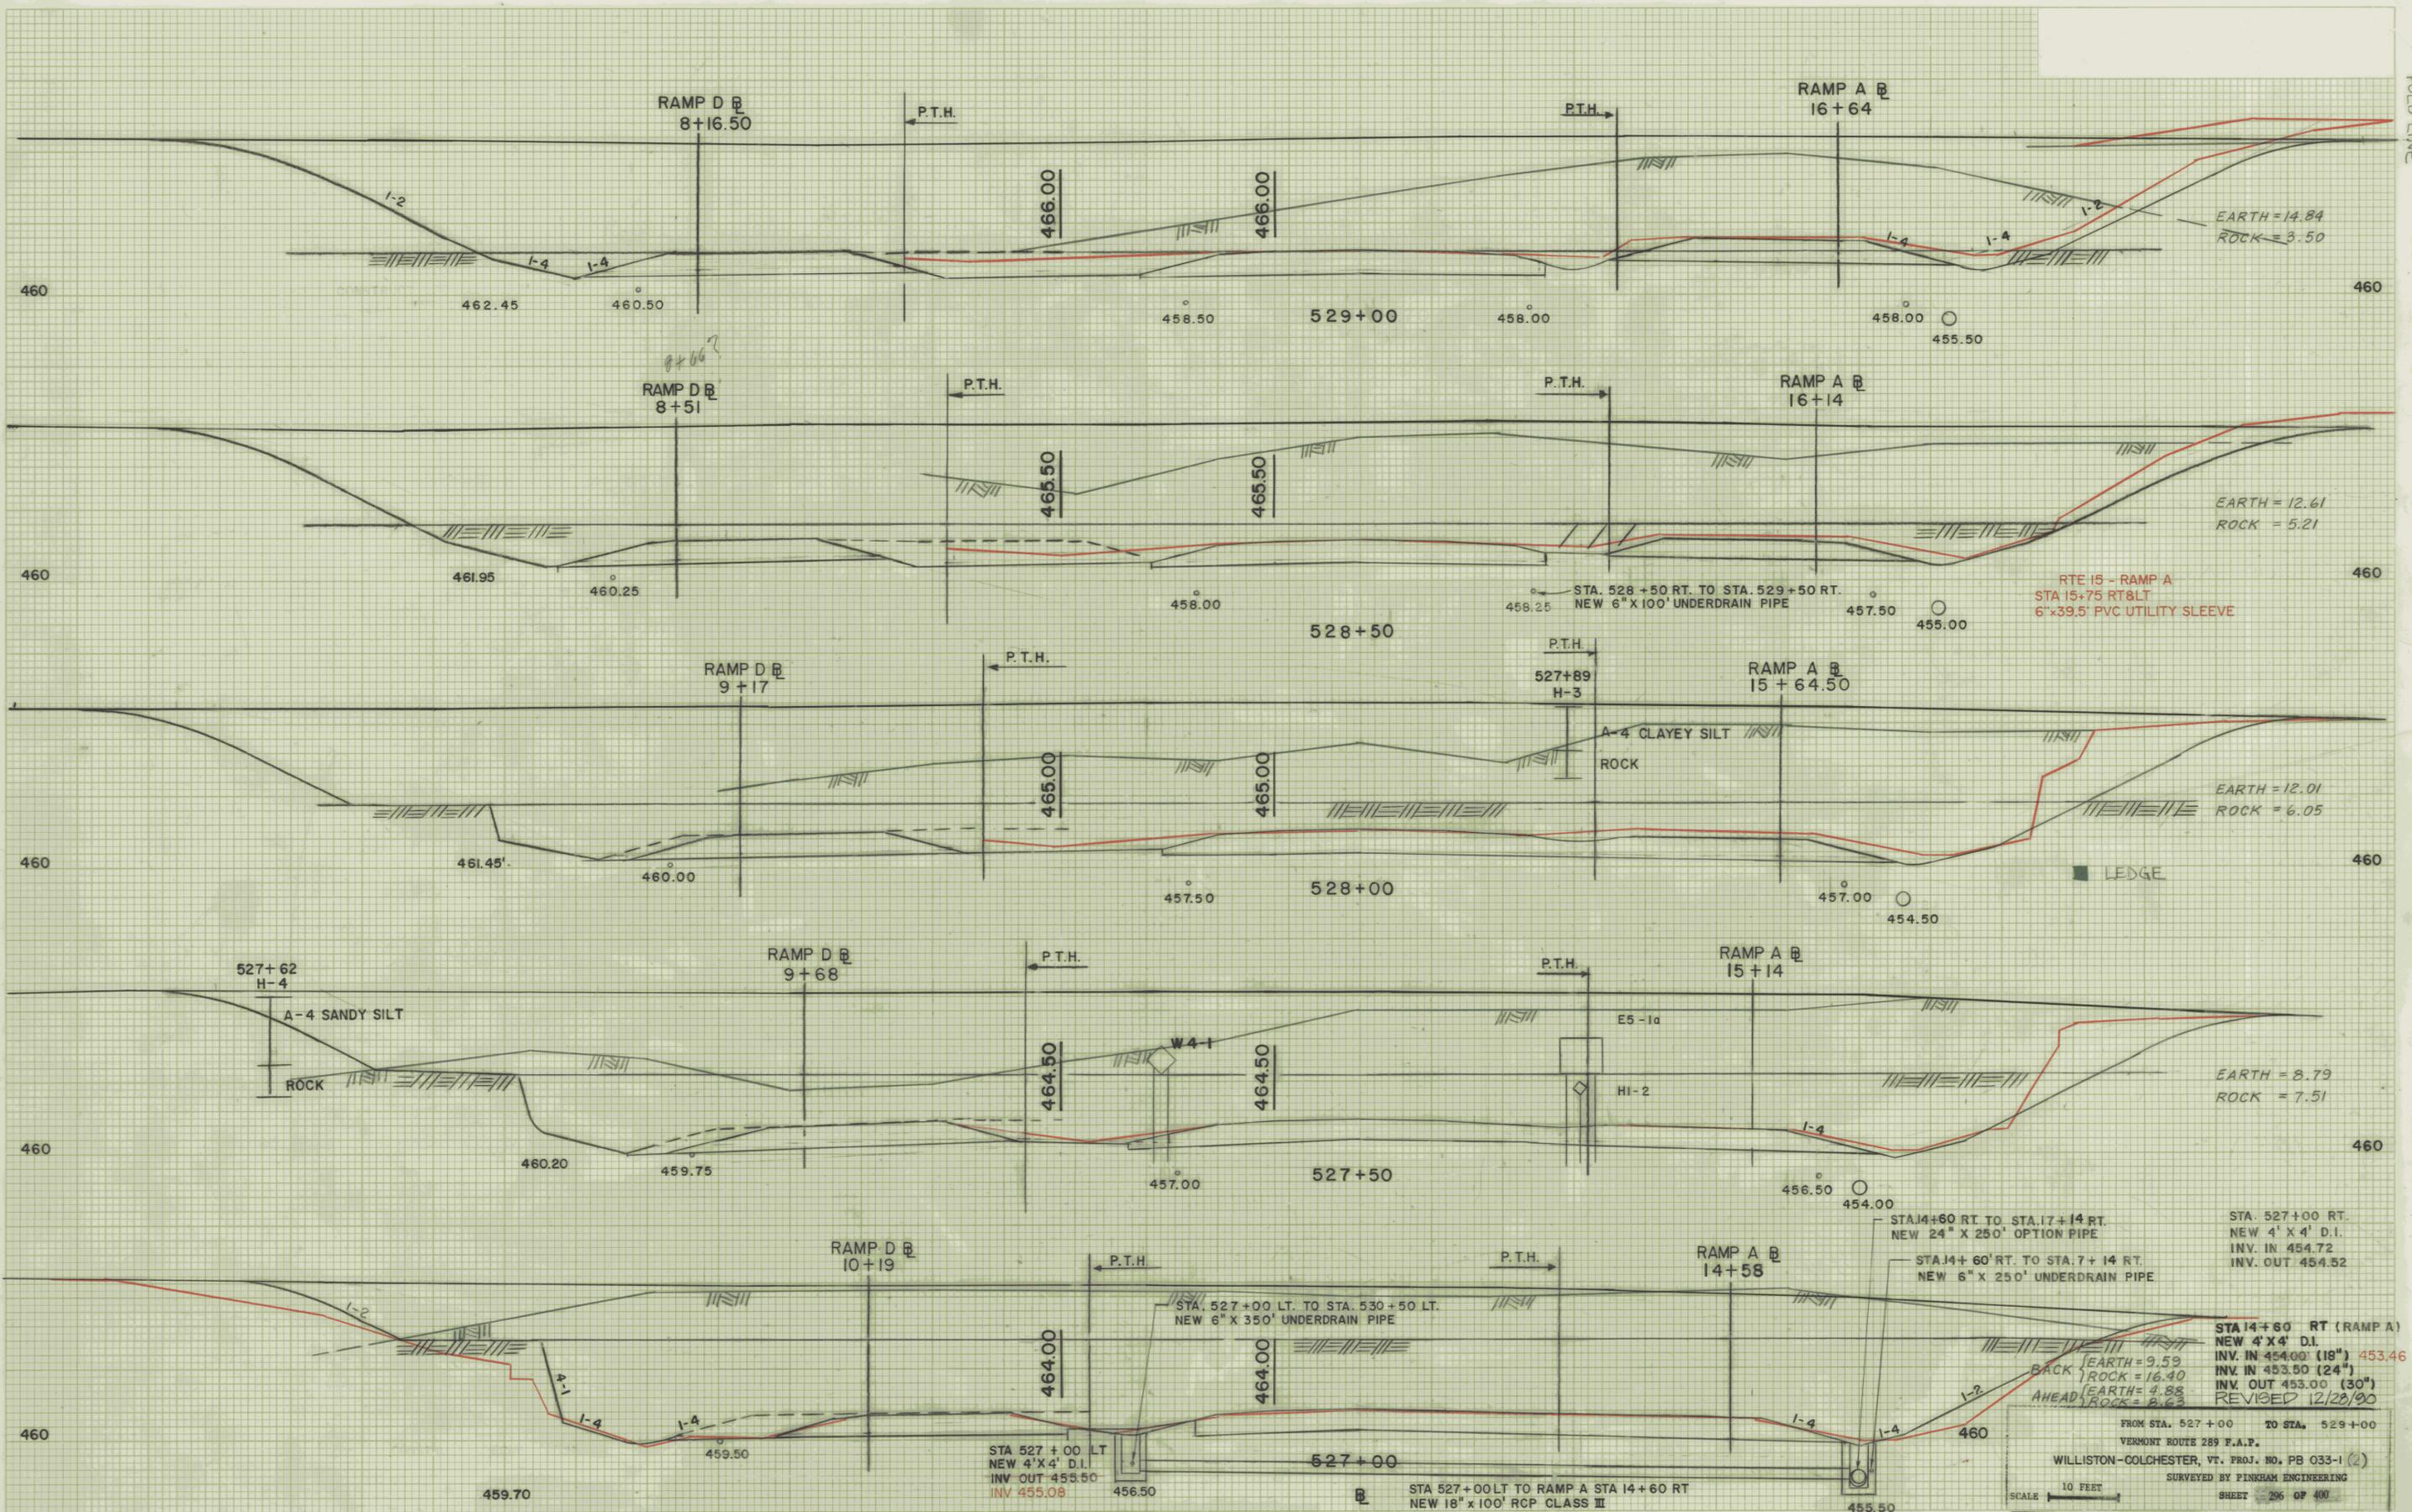

Keuffel & Esser Company

AS BUILT 5/20/94