


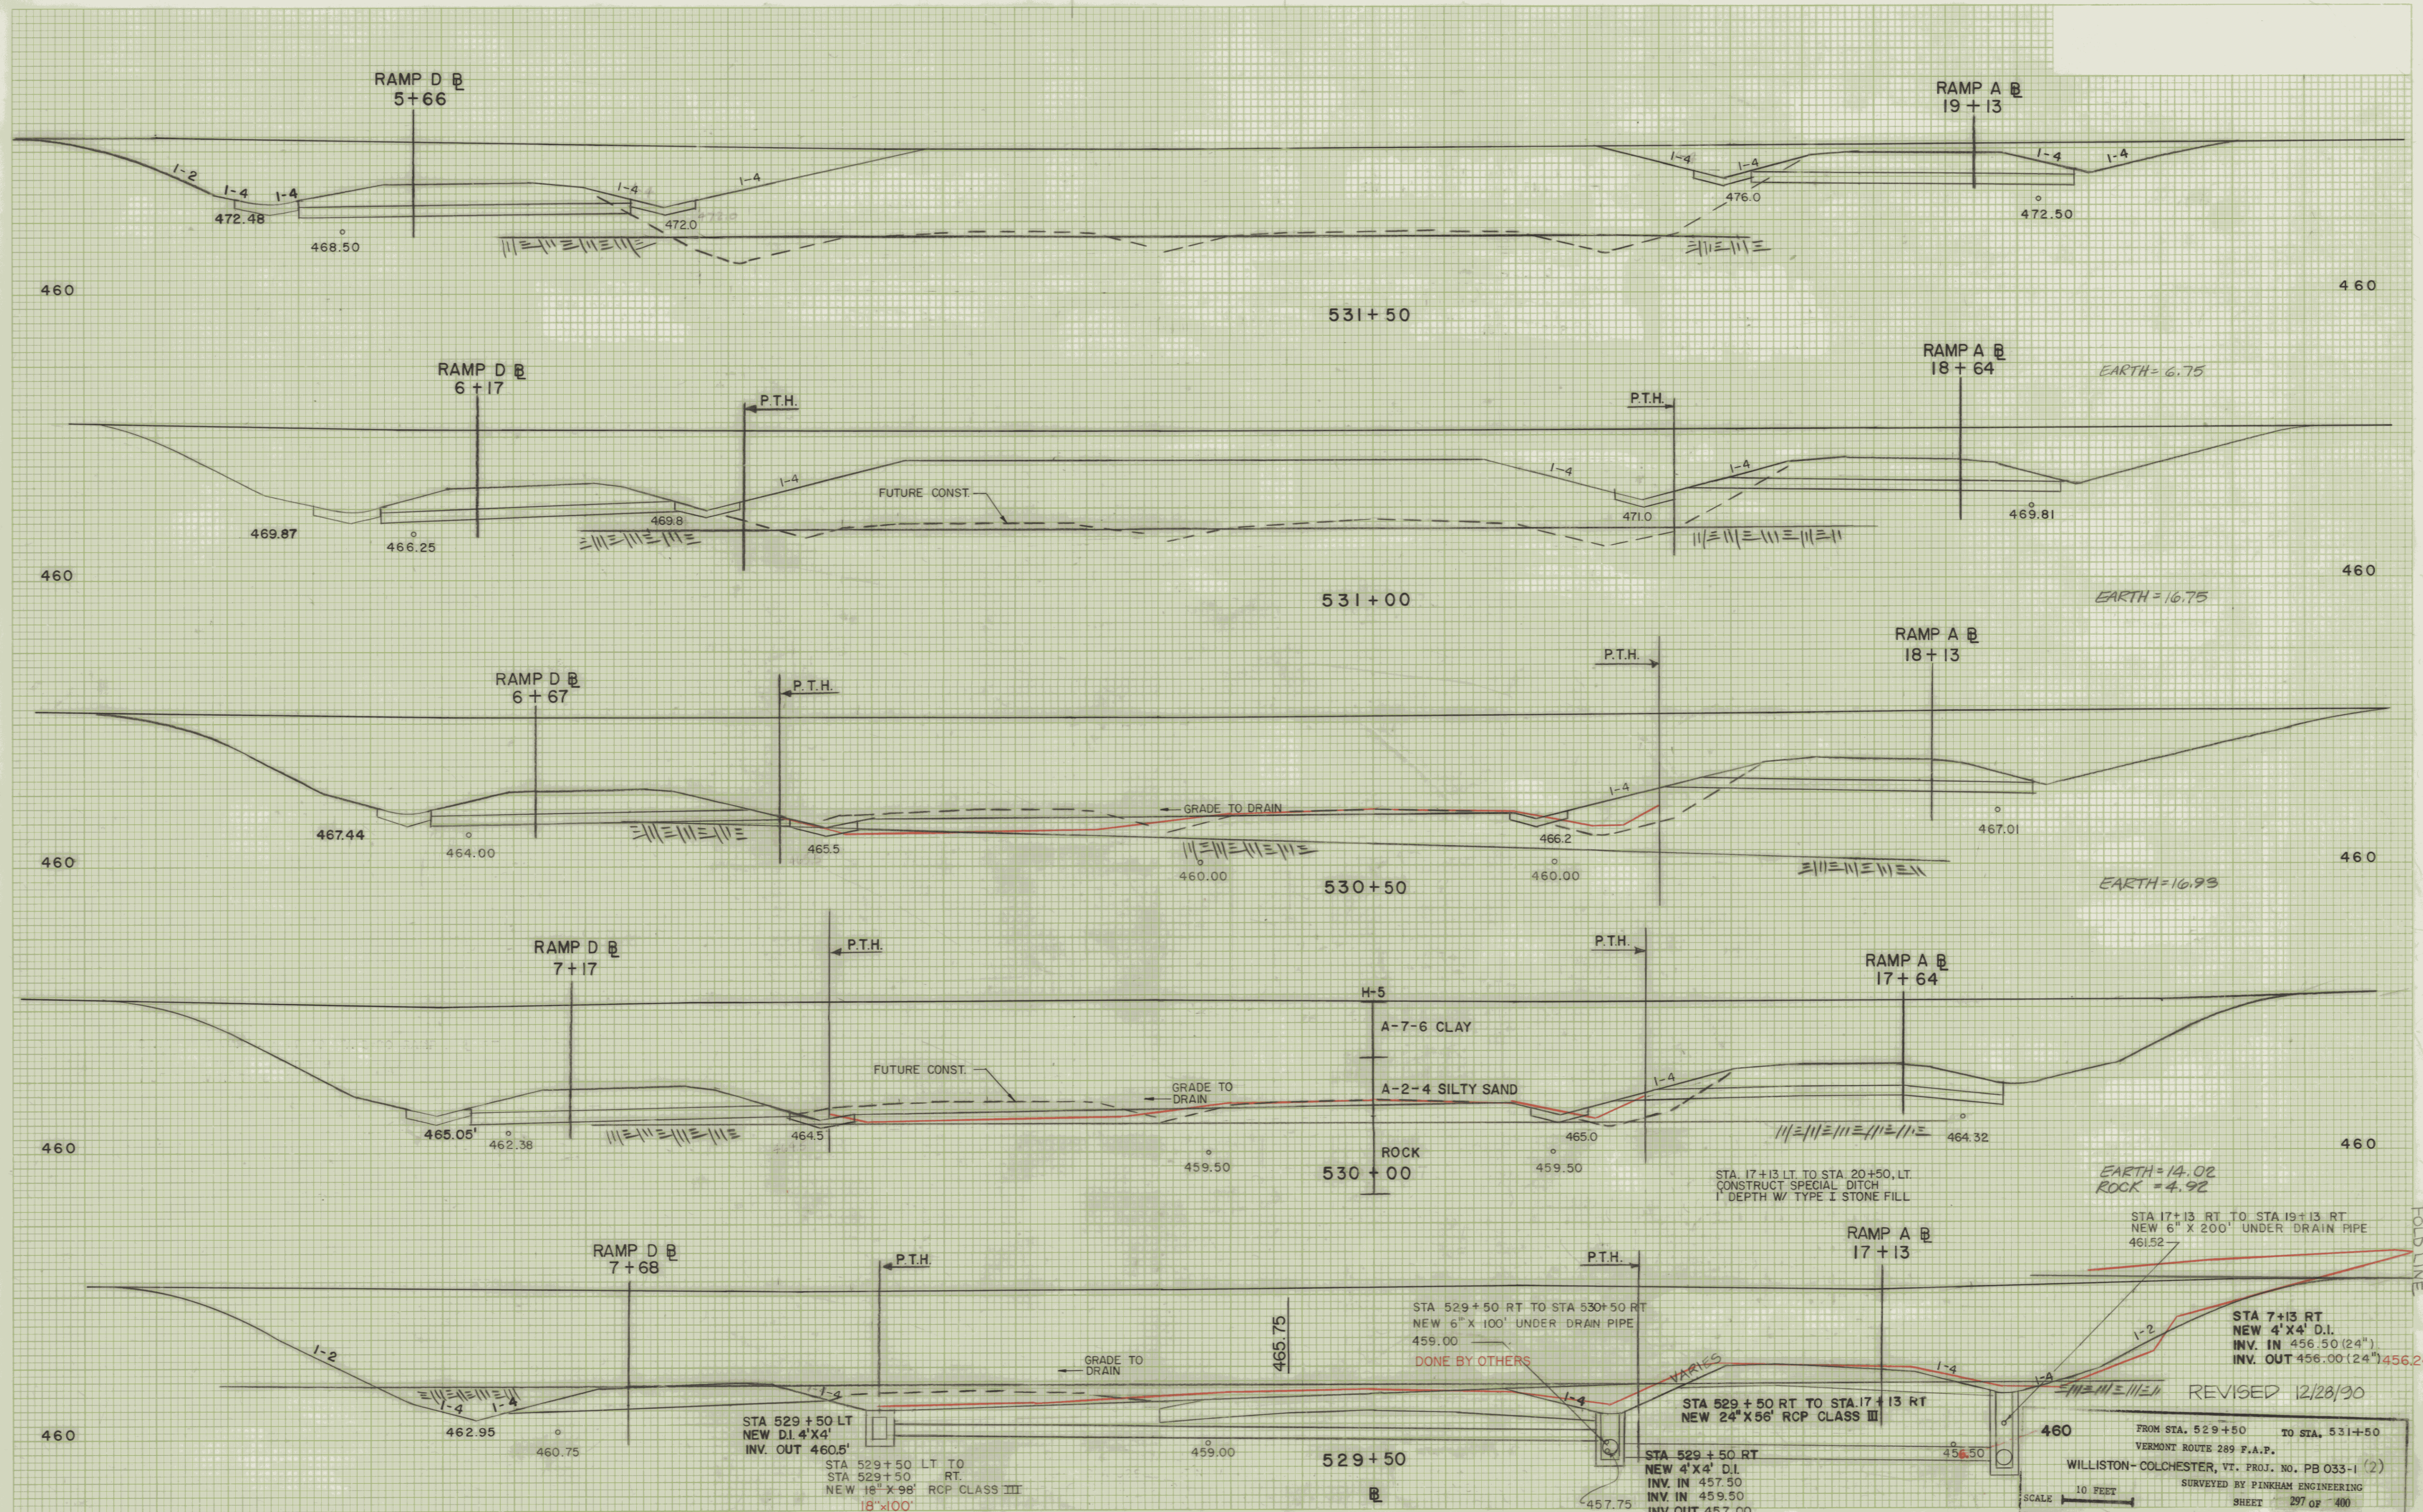

STA 529+50 LT
NEW D.I. 4'x4'
INV. OUT 460.5'
STA 529+50 LT TO
STA 529+50 RT.
NEW 18" X 98" RCP CLASS III
18"x100"

STA 529+50 RT TO STA 530+50 RT
NEW 6" X 100' UNDER DRAIN PIPE
459.00
DONE BY OTHERS

STA 529+50 RT
NEW 4'x4' D.I.
INV. IN 457.50
INV. IN 459.50
INV. OUT 457.00

STA 17+13 LT TO STA 20+50, LT.
CONSTRUCT SPECIAL DITCH
1' DEPTH W/ TYPE I STONE FILL

STA 17+13 RT TO STA 19+13 RT
NEW 6" X 200' UNDER DRAIN PIPE
461.52

STA 7+13 RT
NEW 4'x4' D.I.
INV. IN 456.50 (24")
INV. OUT 456.00 (24") 456.24

460
FROM STA. 529+50 TO STA. 531+50
VERMONT ROUTE 289 F.A.P.
WILLISTON-COLCHESTER, VT. PROJ. NO. PB 033-1 (2)
SURVEYED BY PINKHAM ENGINEERING
SHEET 297 OF 400
SCALE 10 FEET
AS BUILT 5/20/94